
FEE \$ 10.00 PLANNING CL TCP \$ 7 (Single Family Residential an Community Develop) SIF \$ 292.00 Community Develop)	nd Accessory Structures)
TAX SCHEDULE NO. 2943-071-23-004	TOTAL SQ. FT. OF EXISTING & PROPOSED <u>1572</u> NO. OF DWELLING UNITS: Before: <u>After</u> this Construction NO. OF BUILDINGS ON PARCEL Before: <u>After</u> this Construction
property lines, ingress/egress to the property, driveway loc	Il existing & proposed structure location(s), parking, setbacks to all eation & width & all easements & rights-of-way which abut the parcel. DMMUNITY DEVELOPMENT DEPARTMENT STAFF Maximum coverage of lot by structures Permanent Foundation Required: YESNO Parking Req'mt Special Conditions Ing. formulation regul CENSUS TRAFFICANNX#
structure authorized by this application cannot be occupie Occupancy has been issued, if applicable, by the Building I hereby acknowledge that I have read this application and	ed, in writing, by the Community Development Department. The ed until a final inspection has been completed and a Certificate of g Department (Section 305, Uniform Building Code). the information is correct; Lagree to comply with any and all codes, the project. I understand that failure to comply shall result in legal

Applicant Signature		Date	7-7-03
Department Approval Alt Ronnie Edu	and sAPA	Date	7-25-03
Additional water and/or sewer tap fee(s) are required:	YES	NO	W/O NO. 15/54
Utility Accounting	<u> </u>	Date 7	24/03
VALUE FOR CIV MONITUR FROM DATE OF ICCUANCE	E (Section 0.2.20	Crond June	tion Zoning & Dovelonment Code)

VALID FOR SIX MONTHS FROM DATE OF ISSUANCE (Section 9-3-2C Grand Junction Zoning & Development Code)

(White: Planning)	(Yellow: Customer)	(Pink: Building Department)

(Goldenrod: Utility Accounting)

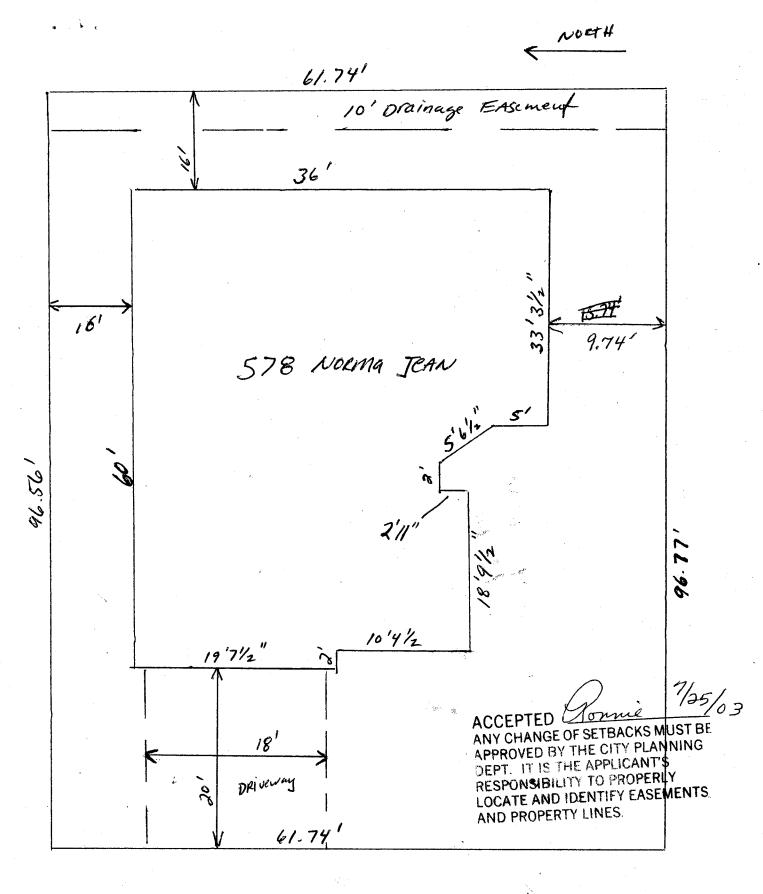

Norma Jean Street

01e Ver 18/03