
	(N) [
FEE \$ 10.00 PLANNING CLEA	
TCP \$ 500.00 (Single Family Residential and Action of the second sec	
SIF \$ JAD.00	
Building Address 729 JCUTERS CR.	No. of Existing Bldgs Proposed
Parcel No. 220/-334-36-067	Sq. Ft. of Existing Bldgs Proposed _///9
Subdivision <u>FOUNTAN</u> GROMS	Sq. Ft. of Lot / Parcel
Filing <u>3</u> Block <u>Lot</u> Lot <u>6</u>	Sq. Ft. Coverage of Lot by Structures & Impervious Surface (Total Existing & Proposed)
OWNER INFORMATION:	DESCRIPTION OF WORK & INTENDED USE:
Name FOUNTAIN GREDNS LLC	
Address 1655 WALNUT ST-SUTT 300	New Single Family Home (*check type below) Interior Remodel Other (please specify):
City/State/Zip BOULAER Co 80302	*TYPE OF HOME PROPOSED:
Name (ONUSTRUCTION /NC	Site Built Manufactured Home (UBC) Manufactured Home (HUD) Other (please specify):
Address <u>Po Box 4247</u>	
City / State / Zip <u>G.J.</u> Co <u>SISO2</u>	NOTES: SNOLD FAMILY NOSIDENCE
Telephone (970) 245-9008	
	cisting & proposed structure location(s), parking, setbacks to all on & width & all easements & rights-of-way which abut the parcel.
ZONE PD	Maximum coverage of lot by structures
SETBACKS: Front from property line (PL)	
	Permanent Foundation Required: YESNO
Side from PL Rear from PL	Permanent Foundation Required: YESNO
· · · · · · · · · · · · · · · · ·	
Sidefrom PL Rearfrom PL Maximum Height of Structure(s) Driveway	Parking Requirement






Ē

1 33

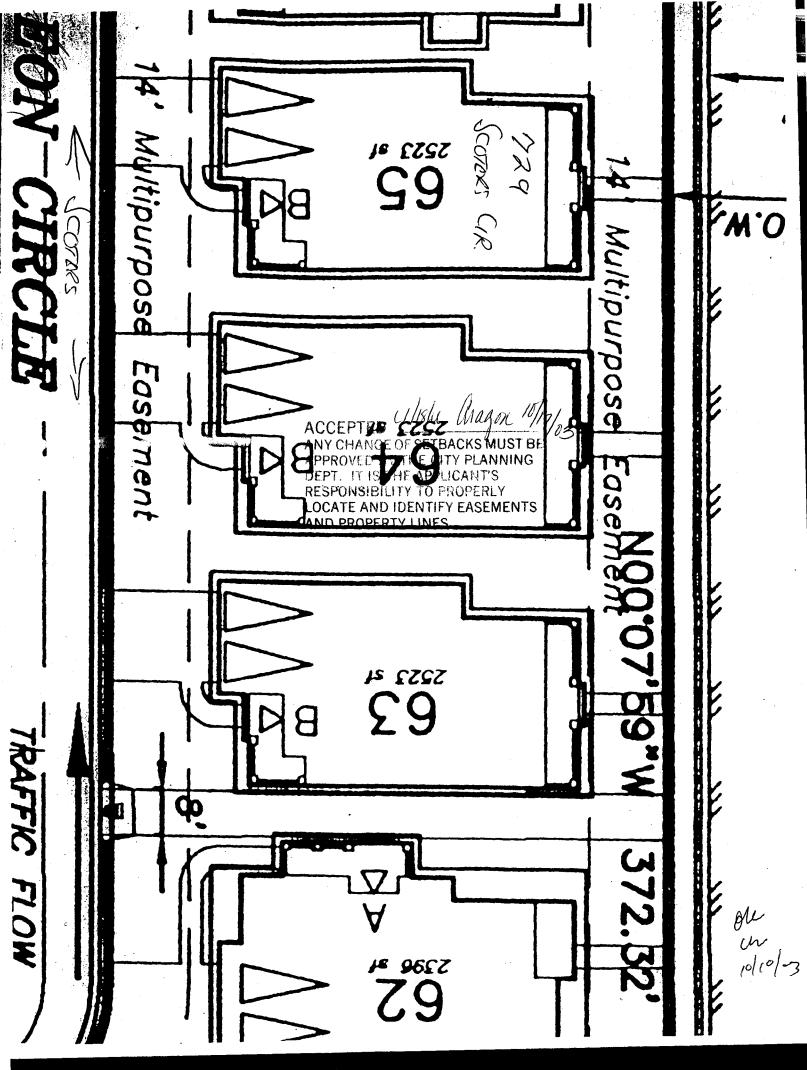

.