
FEE'\$ 10.00 PLANNING CLE	EARANCE BLDG PERMIT NO.
TCP \$ 0 (Single Family Residential and	
SIF \$ 292.00 Community Develop	ment Department
Building Address 340 Comyon Rin Ct	Your Bridge to a Better Community
Parcel No. 2945-192-18-017	
Subdivision <u>Lanyon Rim</u>	
Filing Block _ Z Lot _ 17	Sq. Ft. Coverage of Lot by Structures & Impervious Surface
OWNER INFORMATION:	(Total Existing & Proposed) <u>3,300</u>
Name 6. Denn & Helen and	DESCRIPTION OF WORK & INTENDED USE:
Address	New Single Family Home (*check type below)     Interior Remodel     Other (please specify):
City / State / Zip	
APPLICANT INFORMATION:	*TYPE OF HOME PROPOSED:
Name Chris Kendrick Const.	Site Built Manufactured Home (UBC) Manufactured Home (HUD)
Address 231 W. Fallen Rock Rd	Other (please specify):
City/State/Zip <u>Grand Junition Co. 815</u>	03 NOTES:
Telephone (970) 245 - 8989	
REQUIRED: One plot plan, on 8 ½" x 11" paper, showing a	II existing & proposed structure location(s), parking, setbacks to all action & width & all easements & rights-of-way which abut the parcel.
REQUIRED: One plot plan, on 8 ½" x 11" paper, showing a property lines, ingress/egress to the property, driveway loc	II existing & proposed structure location(s), parking, setbacks to all cation & width & all easements & rights-of-way which abut the parcel.










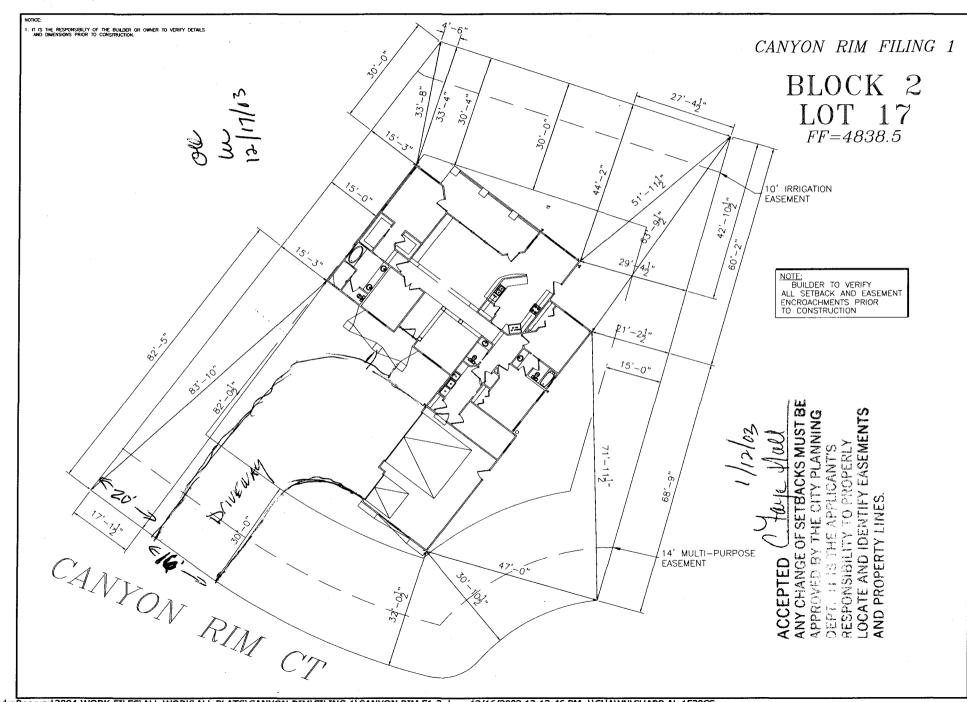

\Autodraftserver\2004 WORK FILES\ALL WORK\ALL PLATS\CANYON RIM\FILING 1\CANYON RIM F1-2.dwg, 12/16/2003 12:13:46 PM, \\SHAWN\SHARP AL-1530CS

.