
FEE \$ 10.00 PLANNING CLI	FARANCE BLDG PERMIT NO.
TCP \$ 500.00 (Single Family Residential and	d Accessory Structures)
SIF \$ 292.00 Community Develop	ment Department
Building Address 690 / Miranda	No. of Existing Bldgs No. Proposed/
Parcel No. 2945-032-98-001	
Subdivision Colonial Heights	
	Sq. Ft. Coverage of Lot by Structures & Impervious Surface (Total Existing & Proposed)
OWNER INFORMATION:	DESCRIPTION OF WORK & INTENDED USE:
Name Sonshine 11	 X New Single Family Home (*check type below)
Address 3350 G RUAD	Interior Remodel Addition
City / State / Zip <u>GJ</u> Co 8/50/	
APPLICANT INFORMATION:	*TYPE OF HOME PROPOSED:
Name Sonshire I	Site Built Manufactured Home (UBC) Manufactured Home (HUD)
Address 2350 G KOAD	Other (please specify):
City / State / Zip Co 8/50/	NOTES:
	NOTES
Telephone	
DECUUDED: One plat plan, or 9 1/0" x 11" percer abowing	all eviating 9 proposed attractive logation(a) particing activates to all
property lines, ingress/egress to the property, driveway loo	all existing & proposed structure location(s), parking, setbacks to all cation & width & all easements & rights-of-way which abut the parcel.





OMMUNITY DEVELOPMENT DEPARTMENT STAFF Maximum coverage of lot by structures $(lo ?6)$ Permanent Foundation Required: YES NO Parking Requirement 2 Special Conditions Engliticered foundation required Special Conditions Engliticered foundation required Wed, in writing, by the Community Development Department. The red until a final inspection has been completed and a Certificate of g Department (Section 305, Uniform Building Code). If the information is correct; I agree to comply with any and all codes, to the project. I understand that failure to comply shall result in legal to non-use of the building(s). Date $5 \sqrt{8}/04$ 400 Date $6 - 14 - 04$


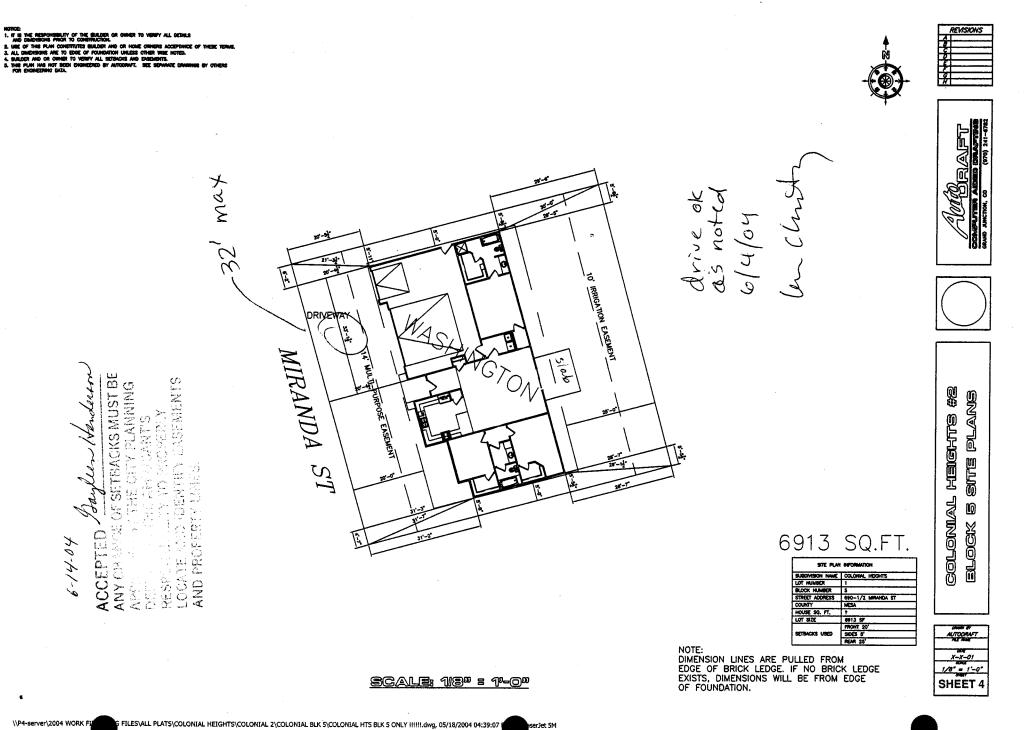

serJet 5M