FEE\$	10.00
TCP\$	Ø
SIF \$	9

(White: Planning)

(Yellow: Customer)

PLANNING CLEARANCE

BLDG PERMIT NO.


(Single Family Residential and Accessory Structures)

Community Development Department

Building Address 382 myrrh St	No. of Existing Bldgs No. Proposed
Parcel No. 2943-191-25-001	Sq. Ft. of Existing Bldgs 1557 Sq. Ft. Proposed 200
Subdivision White Willows	Sq. Ft. of Lot / Parcel
Filing Block 5 Lot 1	Sq. Ft. Coverage of Lot by Structures & Impervious Surface (Total Existing & Proposed)
OWNER INFORMATION:	
Name Ernest Hodson	DESCRIPTION OF WORK & INTENDED USE:
Address 382 Myrrh St	New Single Family Home (*check type below) Interior Remodel
City/State/Zip GJ CO 81501	Other (please specify): 10 x 20 5 hed
APPLICANT INFORMATION:	*TYPE OF HOME PROPOSED:
Name Same	Site Built
Address	Cirioi (piedase specify).
City/State/Zip cell 640- 755 4934	NOTES:
Telephone 242-4173	
REQUIRED: One plot plan, on 8 1/2" x 11" paper, showing all e	xisting & proposed structure location(s), parking, setbacks to all
	on & width & all easements & rights-of-way which abut the parcel.
property lines, ingress/egress to the property, driveway location	on & width & all easements & rights-of-way which abut the parcel. MUNITY DEVELOPMENT DEPARTMENT STAFF
property lines, ingress/egress to the property, driveway location	
THIS SECTION TO BE COMPLETED BY	MUNITY DEVELOPMENT DEPARTMENT STAFF Maximum coverage of lot by structures
(Pink: Building Department)

(Goldenrod: Utility Accounting)

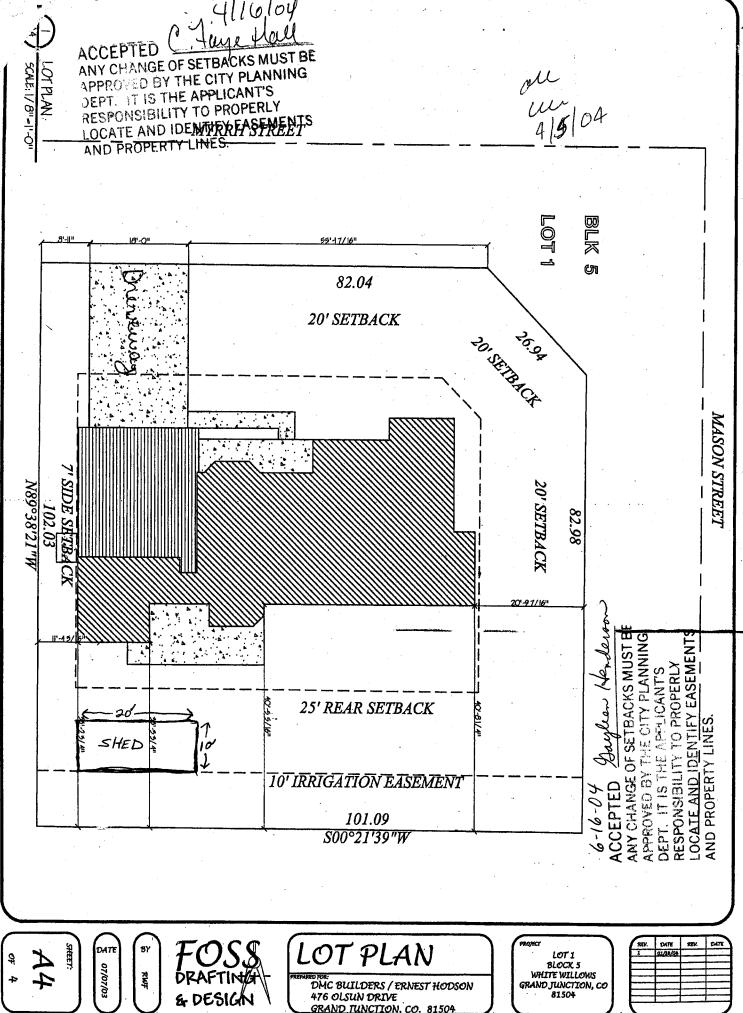

GRAND TUNCTION. CO.

