FEE \$. 10.00	
TCP\$ 7 Ø	
SIF\$ 292.00	

(White: Planning)

(Yellow: Customer)

PLANNING CLEARANCE

BLDG PERMIT NO.	


(Goldenrod: Utility Accounting)

(Single Family Residential and Accessory Structures)

<u>Community Development Department</u>

Building Address 422 MARIANNE DR	No. of Existing Bldgs O No. Proposed
Parcel No. 2943-174-32-001 + 002	Sq. Ft. of Existing Bldgs O Sq. Ft. Proposed 1509)
Subdivision WESTLAND ESTATES	Sq. Ft. of Lot / Parcel
Filing <u>3</u> Block <u>3</u> Lot <u>8</u>	Sq. Ft. Coverage of Lot by Structures & Impervious Surface
OWNER INFORMATION:	(Total Existing & Proposed) 0 4 22 10 11 Height of Proposed Structure 25 '
Name TIM KEENAN Address 582 GREENFIELD CR. Wat	DESCRIPTION OF WORK & INTENDED USE: New Single Family Home (*check type below) Interior Remodel Addition
City/State/Zip GRAND 3CT CO 8150	Other (please specify):
APPLICANT INFORMATION:	*TYPE OF HOME PROPOSED:
Name TIM KEENAN	Site Built Manufactured Home (ÚBC) Manufactured Home (HUD)
Address 582 GREENFIELD CR.WE	Other (please specify):
City/State/Zip GRAND JCT. CO 81504	NOTES:
Telephone 970 - 261 - 4770	······································
	cisting & proposed structure location(s), parking, setbacks to all n & width & all easements & rights-of-way which abut the parcel.
_	MUNITY DEVELOPMENT DEPARTMENT STAFF
THIS SECTION TO BE COMPLETED BY COMM	Maximum coverage of lot by structures
$Q_{\Lambda} = 1$	
ZONE PSF-4	Maximum coverage of lot by structures
ZONESF-4 SETBACKS: Frontfrom property line (PL)	Maximum coverage of lot by structures
(Pink: Building Department)

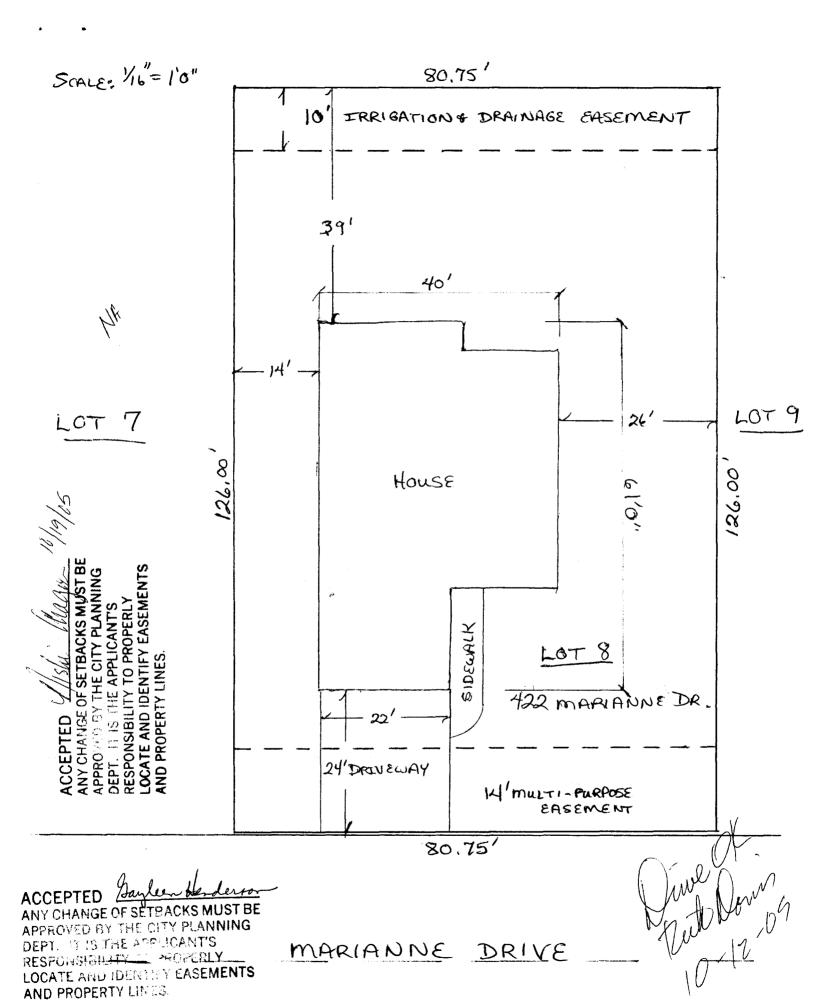

1	
FEE \$ \(\begin{align*} \text{\$\left(\text{D} \) \end{align*}} \text{PLANNING CLEAR}	ARANCE BLDG PERMIT NO.
TCP\$ (Single Family Residential and Ad	ccessory Structures)
SIF \$ 292.00 Community Developme	
425 Marianne N	line
Building Address 2975 West Fidge	No. of Existing Bldgs No. Proposed
Parcel No. 2943-174-31-001	Sq. Ft. of Existing Bldgs <u>0</u> Sq. Ft. Proposed <u>1394</u>
Subdivision Westland Estates	Sq. Ft. of Lot / Parcel
Filing Block Lot	Sq. Ft. Coverage of Lot by Structures & Impervious Surface (Total Existing & Proposed)
OWNER INFORMATION:	Height of Proposed Structure 21.5 41
Name Ches VEITENHIE MIER Address 3220 CRd	DESCRIPTION OF WORK & INTENDED USE: New Single Family Home (*check type below) Interior Remodel Addition
City / State / Zip QT. CO. 81503	Cher (please specify):
APPLICANT INFORMATION:	*TYPE OF HOME PROPOSED:
Name Doubles R. Brilders	Site Built Manufactured Home (UBC Manufactured Home (HUD)
Address 2500 Broodway Wit B Ba	Other (please specify):
City / State / Zip 61. Co. 81503	
Telephone 970-241-3449	
Telephone	
	xisting & proposed structure location(s), parking, setbacks to a on & width & all easements & rights-of-way which abut the parce
property lines, ingress/egress to the property, driveway location	
property lines, ingress/egress to the property, driveway location	on & width & all easements & rights-of-way which abut the parce
THIS SECTION TO BE COMPLETED BY COMP	on & width & all easements & rights-of-way which abut the parcel MUNITY DEVELOPMENT DEPARTMENT STAFF
THIS SECTION TO BE COMPLETED BY COMP	MUNITY DEVELOPMENT DEPARTMENT STAFF Maximum coverage of lot by structures
THIS SECTION TO BE COMPLETED BY	MUNITY DEVELOPMENT DEPARTMENT STAFF Maximum coverage of lot by structures SOOO Permanent Foundation Required: YES NO
THIS SECTION TO BE COMPLETED BY	MUNITY DEVELOPMENT DEPARTMENT STAFF Maximum coverage of lot by structures 5000 Permanent Foundation Required: YES_XNO Parking Requirement
THIS SECTION TO BE COMPLETED BY COMME ZONE SETBACKS: Front from property line (PL) Side from PL Rear 35 from PL Maximum Height of Structure(s) 35	MUNITY DEVELOPMENT DEPARTMENT STAFF Maximum coverage of lot by structures 5000 Permanent Foundation Required: YES_XNO Parking Requirement Special Conditions
THIS SECTION TO BE COMPLETED BY	MUNITY DEVELOPMENT DEPARTMENT STAFF Maximum coverage of lot by structures 5000 Permanent Foundation Required: YES_XNO Parking Requirement Special Conditions in writing, by the Community Development Department. The until a final inspection has been completed and a Certificate of
THIS SECTION TO BE COMPLETED BY	MUNITY DEVELOPMENT DEPARTMENT STAFF Maximum coverage of lot by structures 5000 Permanent Foundation Required: YES_XNO Parking Requirement Special Conditions in writing, by the Community Development Department. The until a final inspection has been completed and a Certificate of epartment (Section 305, Uniform Building Code). information is correct; I agree to comply with any and all codes a project. I understand that failure to comply shall result in legal



