
| FEE \$ 10.00 PLANNING CLE | BLDG PERMIT NO. |
|---|--|
| TCP \$ 1000.00 (Single Family Residential and | Accessory Structures) |
| SIF\$ 292.00 <u>Community Developm</u> | nent Department |
| | |
| Building Address 2065 pc (ross | No. of Existing Bldgs No. Proposed |
| Parcel No. <u>2947-151-54003</u> | _ Sq. Ft. of Existing Bldgs Sq. Ft. Proposed |
| Subdivision Independence Pracil | Sq. Ft. of Lot / Parcel 3 Acre |
| Filing Block Lot | Sq. Ft. Coverage of Lot by Structures & Impervious Surface (Total Existing & Proposed) |
| OWNER INFORMATION: | Height of Proposed Structure 18+- |
| Name Kangtast | |
| Address 687 (creant- Cir | New Single Family Home (*check type below) |
| City/State/Zip CA. Co 8503 | Other (please specify): |
| | |
| APPLICANT INFORMATION: | *TYPE OF HOME PROPOSED: Site Built Manufactured Home (UBC) |
| Name harry verheur | _ Manufactured Home (HUD) Other (please specify): |
| Address | |
| City / State / Zip | NOTES: |
| Telephone <u>241-0775</u> | |
| | |
| | existing & proposed structure location(s), parking, setbacks to all |
| property lines, ingress/egress to the property, driveway local | tion & width & all easements & rights-of-way which abut the parcel. |
| property lines, ingress/egress to the property, driveway local THIS SECTION TO BE COMPLETED BY COM () ∧ | tion & width & all easements & rights-of-way which abut the parcel. MMUNITY DEVELOPMENT DEPARTMENT STAFF |
| property lines, ingress/egress to the property, driveway local THIS SECTION TO BE COMPLETED BY COM ZONE | tion & width & all easements & rights-of-way which abut the parcel. MMUNITY DEVELOPMENT DEPARTMENT STAFF |
| property lines, ingress/egress to the property, driveway local THIS SECTION TO BE COMPLETED BY COM ZONE | tion & width & all easements & rights-of-way which abut the parcel. MMUNITY DEVELOPMENT DEPARTMENT STAFF |
| property lines, ingress/egress to the property, driveway local THIS SECTION TO BE COMPLETED BY COM ZONE P() SETBACKS: Front 25 ' Side 10 ' from PL Rear 25 ' from PL | tion & width & all easements & rights-of-way which abut the parcel. MMUNITY DEVELOPMENT DEPARTMENT STAFF _ Maximum coverage of lot by structures 35 % Permanent Foundation Required: YES_X_NO Parking Requirement |

X

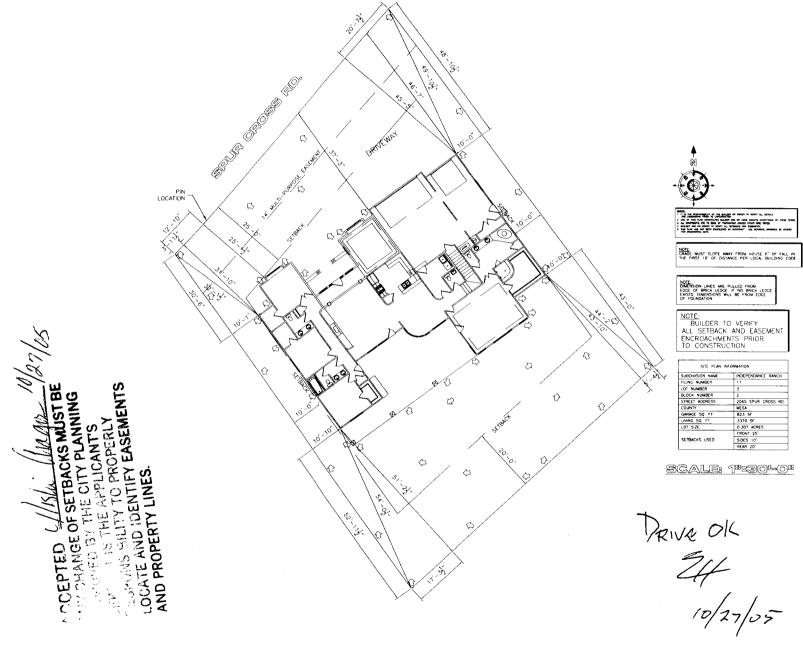





٠,

٨





BENNET CONSTRUCTION INDEPENDANCE RANCH ZOSS SPURCEOSS Alune 11, alock 2, lot 3 - roof rlan

AUTODRAFT 5417 X-X-01 3586 1 "= 30'-0" 5467 SHEET 1

F:\BENNETT\IND RANCH - F11- B2 - L3\SITE-1.dwg, 10/25/2005 10:54:07 AM, \\HP-1\\HP LaserJet 1100 (MS)