
, 1		
PLANNING CLE	ARANCE BLDG PERMIT NO.	
TCP.\$ 1539.00 (Single Family Residential and Accessory Structures)		
SIF \$ 4/20.00 Community Developm	ent Department	
Building Address 2826 S. Forest Ln	No. of Existing Bldgs No. Proposed	
Parcel No. 2943-192-47-009	Sq. Ft. of Existing Bldgs Sq. Ft. Proposed	
Subdivision Summer Glen	Sq. Ft. of Lot / Parcel 6017	
Filing Block <u>2</u> Lot <u>9</u>	Sq. Ft. Coverage of Lot by Structures & Impervious Surface	
OWNER INFORMATION:	(Total Existing & Proposed) <u>I6_38</u> Height of Proposed Structure	
Name Darter U.E	DESCRIPTION OF WORK & INTENDED USE:	
Address786 ValleyCt.	New Single Family Home (*check type below)	
City/State/Zip G5 C0 81505	Other (please specify):	
APPLICANT INFORMATION:	*TYPE OF HOME PROPOSED:	
Name <u>Gruce flanes</u> Address <u>Same as above</u>	¹ Manufactured Home (HUD) Other (please specify):	
Address Same as above		
City / State / Zip	NOTES:	
Telephone248-8500		
	existing & proposed structure location(s), parking, setbacks to all on & width & all easements & rights-of-way which abut the parcel.	
property lines, ingress/egress to the property, driveway locati		
property lines, ingress/egress to the property, driveway locati	on & width & all easements & rights-of-way which abut the parcel.	
property lines, ingress/egress to the property, driveway locati THIS SECTION TO BE COMPLETED BY COM	on & width & all easements & rights-of-way which abut the parcel. MUNITY DEVELOPMENT DEPARTMENT STAFF	
property lines, ingress/egress to the property, driveway locati THIS SECTION TO BE COMPLETED BY COM ZONE	on & width & all easements & rights-of-way which abut the parcel. MUNITY DEVELOPMENT DEPARTMENT STAFF Maximum coverage of lot by structures	
property lines, ingress/egress to the property, driveway locati THIS SECTION TO BE COMPLETED BY COM ZONE	on & width & all easements & rights-of-way which abut the parcel. MUNITY DEVELOPMENT DEPARTMENT STAFF Maximum coverage of lot by structures 70 % Permanent Foundation Required: YES_X_NO	
property lines, ingress/egress to the property, driveway location THIS SECTION TO BE COMPLETED BY COM ZONE $fuf \in S$ SETBACKS: Front $20'$ from property line (PL) Side $5'$ from PL Rear $10'$ from PL Maximum Height of Structure(s) $35'$ Driveway $Driveway$	on & width & all easements & rights-of-way which abut the parcel. MUNITY DEVELOPMENT DEPARTMENT STAFF Maximum coverage of lot by structures 70% Permanent Foundation Required: YES_X_NO Parking Requirement	





The until a final inspection has been completed and a Certificate of epartment (Section 305, Uniform Building Code). information is correct; I agree to comply with any and all codes, e project. I understand that failure to comply shall result in legal on-use of the building(s). Date $4/12/06$ Date $4/12/06$	

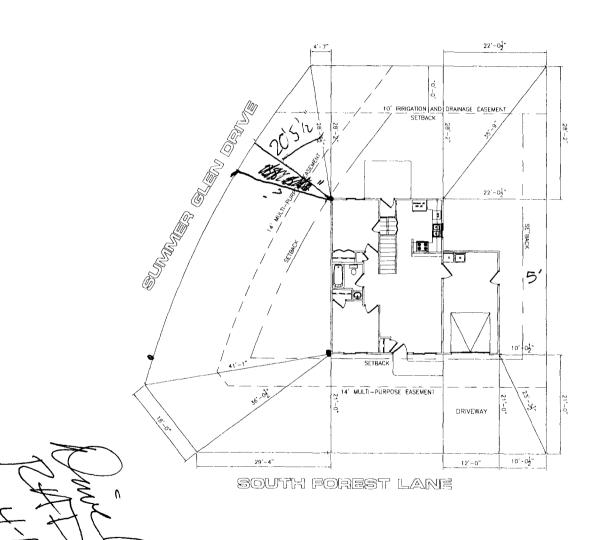

SETBACKS MUST BE AND PROPERTY LINES.
ENCROACHMEN TO CONSTRUC			
SITE PLAN INFO	RMATION]	
SUBDIVISION NAME	SUMMER GLEN	1	
PLAN NAME	VICTORIA	1	
FILING NUMBER	1	1	
LOT NUMBER	9	1	
BLOCK NUMBER	2	1	
STREET ADDRESS	2826 S. FOREST LN.	1	
COUNTY	MESA	1	
GARAGE SQ. FT.	264	1	
COVERED ENTRY SQ. FT.	N/A	1	
COVERED PATIO SQ. FT.	N/A	1	
LIVING SQ. FT	1375		

TAND SQ. TT.	N/A
LIVING SQ. FT	1375
LOT SIZE	6017.6 SQ. FT.
	FRONT 20'
SETBACKS USED	SIDES 5'
	REAR 'O'

4