

FEE \$ 10.00
TCP \$ 1539.00
SIF \$ 400.00

PLANNING CLEARANCE
 (Single Family Residential and Accessory Structures)
Community Development Department

BLDG PERMIT NO. _____

Building Address 3025 Mohawk
 Parcel No. 2943-162-92-002
 Subdivision Prairie View
 Filing _____ Block 2 Lot 2

No. of Existing Bldgs 0 No. Proposed 1
 Sq. Ft. of Existing Bldgs 0 Sq. Ft. Proposed 2017
 Sq. Ft. of Lot / Parcel 8357
 Sq. Ft. Coverage of Lot by Structures & Impervious Surface
 (Total Existing & Proposed) 2800
 Height of Proposed Structure 21'6"

OWNER INFORMATION:

Name Eric Paulson + Aubrey Schwiss
 Address 1160 Road Ave
 City / State / Zip Grand Jct., CO 81501

DESCRIPTION OF WORK & INTENDED USE:
 New Single Family Home (*check type below)
 Interior Remodel Addition
 Other (please specify): _____

APPLICANT INFORMATION:

Name Danny Paulson
 Address 1545 Road Ave.
 City / State / Zip Grand Jct., CO 81501
 Telephone 970-250-3530

*TYPE OF HOME PROPOSED:
 Site Built Manufactured Home (UBC)
 Manufactured Home (HUD)
 Other (please specify): _____

REQUIRED: One plot plan, on 8 1/2" x 11" paper, showing all existing & proposed structure location(s), parking, setbacks to all property lines, ingress/egress to the property, driveway location & width & all easements & rights-of-way which abut the parcel.

THIS SECTION TO BE COMPLETED BY COMMUNITY DEVELOPMENT DEPARTMENT STAFF	
ZONE <u>RMF-5</u>	Maximum coverage of lot by structures <u>60%</u>
SETBACKS: Front <u>20'</u> from property line (PL)	Permanent Foundation Required: YES <input checked="" type="checkbox"/> NO <input type="checkbox"/>
Side <u>5'</u> from PL Rear <u>25'</u> from PL	Parking Requirement <u>2</u>
Maximum Height of Structure(s) <u>35'</u>	Special Conditions _____
Voting District <u>C</u> Driveway Location Approval _____ (Engineer's Initials)	APR 0 2006

Modifications to this Planning Clearance must be approved, in writing, by the Community Development Department. The structure authorized by this application cannot be occupied until a final inspection has been completed and a Certificate of Occupancy has been issued, if applicable, by the Building Department (Section 305, Uniform Building Code).

I hereby acknowledge that I have read this application and the information is correct; I agree to comply with any and all codes, ordinances, laws, regulations or restrictions which apply to the project. I understand that failure to comply shall result in legal action, which may include but not necessarily be limited to non-use of the building(s).


Applicant Signature [Signature] Date 3/31/06
 Department Approval NA [Signature] Date 4-3-06

Additional water and/or sewer tap fee(s) are required: YES <input checked="" type="checkbox"/> NO <input type="checkbox"/>	W/O No. <u>18985</u>
Utility Accounting <u>[Signature]</u>	Date <u>4/4/06</u>

VALID FOR SIX MONTHS FROM DATE OF ISSUANCE (Section 2.2.C.1 Grand Junction Zoning & Development Code)
 (White: Planning) (Yellow: Customer) (Pink: Building Department) (Goldenrod: Utility Accounting)

Project No.	1808
Client	C. COLLIER
Design Date	March 11, 2005
Issue Date	March 11, 2005
Scale	1/8" = 1'-0"
Sheet No.	1808-01
Sheet Title	Site Plan
Drawn By	C. COLLIER
Checked By	
Approved By	
Date	

CL.1

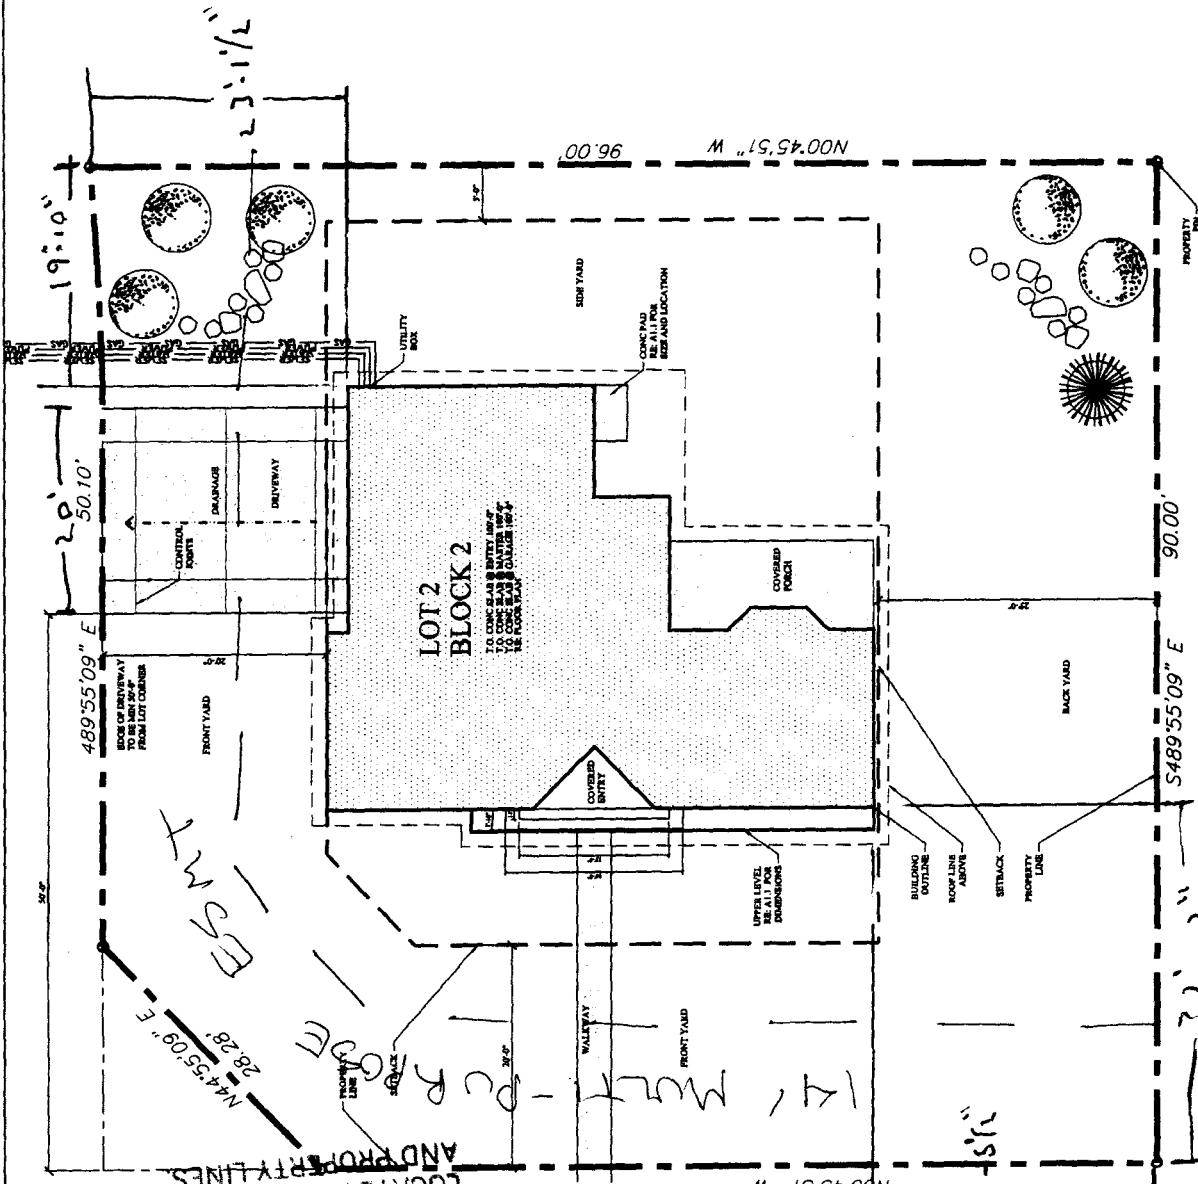

SITE NOTES



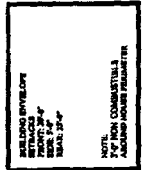

1 EROSION CONTROL

1 SITE PLAN

4/3/04
drive

Mohawk

ESMT

PC R CODE

Dodge

141 Molt

32' 2"