FEE \$	100
TCP\$	1539
SIF\$	460


PLANNING CLEARANCE


BLDG PERMIT	NO.

(Single Family Residential and Accessory Structures)

Community Development Department

Building Address 2930 WHITNEY LN	No. of Existing Bldgs No. Proposed
Parcel No. 2943 - 053 - 77 - 034	Sq. Ft. of Existing Bldgs O Sq. Ft. Proposed 25975
Subdivision FORREST ESTATES	Sq. Ft. of Lot / Parcel 700456
Filing Block Lot 34	Sq. Ft. Coverage of Lot by Structures & Impervious Surface
OWNER INFORMATION:	(Total Existing & Proposed) Height of Proposed Structure 18.5 FT
Name ROB & MARY DEBACA	DESCRIPTION OF WORK & INTENDED USE:
Address 345 33 ROAD	New Single Family Home (*check type below) Interior Remodel Addition
City/State/Zip PAUSADE CO 81526	Other (please specify):
APPLICANT INFORMATION:	*TYPE OF HOME PROPOSED:
Name ROB & MARY DEBACA	Site Built Manufactured Home (UBC) Manufactured Home (HUD)
Address 345 33 ROAD	Other (please specify):
City/State/Zip PAUSADE, CO 81526	NOTES:
Telephone523 8188	
	isting & proposed structure location(s), parking, setbacks to all a width & all easements & rights-of-way which abut the parcel.
THIS SECTION TO BE COMPLETED BY COMN	IUNITY DEVELOPMENT DEPARTMENT STAFF
ZONE WF-5	Maximum coverage of lot by structuresしつん
	, 207
ZONE RMF-5	Maximum coverage of lot by structures
ZONE	Maximum coverage of lot by structures
ZONE	Maximum coverage of lot by structures
SETBACKS: Front 20 from property line (PL) Side 5 from PL Rear 25 from PL Maximum Height of Structure(s) 35 Voting District Driveway Location Approval (Engineer's Initials) Modifications to this Planning Clearance must be approved,	Maximum coverage of lot by structures
SETBACKS: Front 20 from property line (PL) Side 5 from PL Rear 25 from PL Maximum Height of Structure(s) 35 Voting District Driveway Location Approval (Engineer's Initials) Modifications to this Planning Clearance must be approved, structure authorized by this application cannot be occupied u Occupancy has been issued, if applicable, by the Building De I hereby acknowledge that I have read this application and the	Maximum coverage of lot by structures Permanent Foundation Required: YES NO Parking Requirement Special Conditions In writing, by the Community Development Department. The ntil a final inspection has been completed and a Certificate of partment (Section 305, Uniform Building Code). Information is correct; I agree to comply with any and all codes, project. I understand that failure to comply shall result in legal





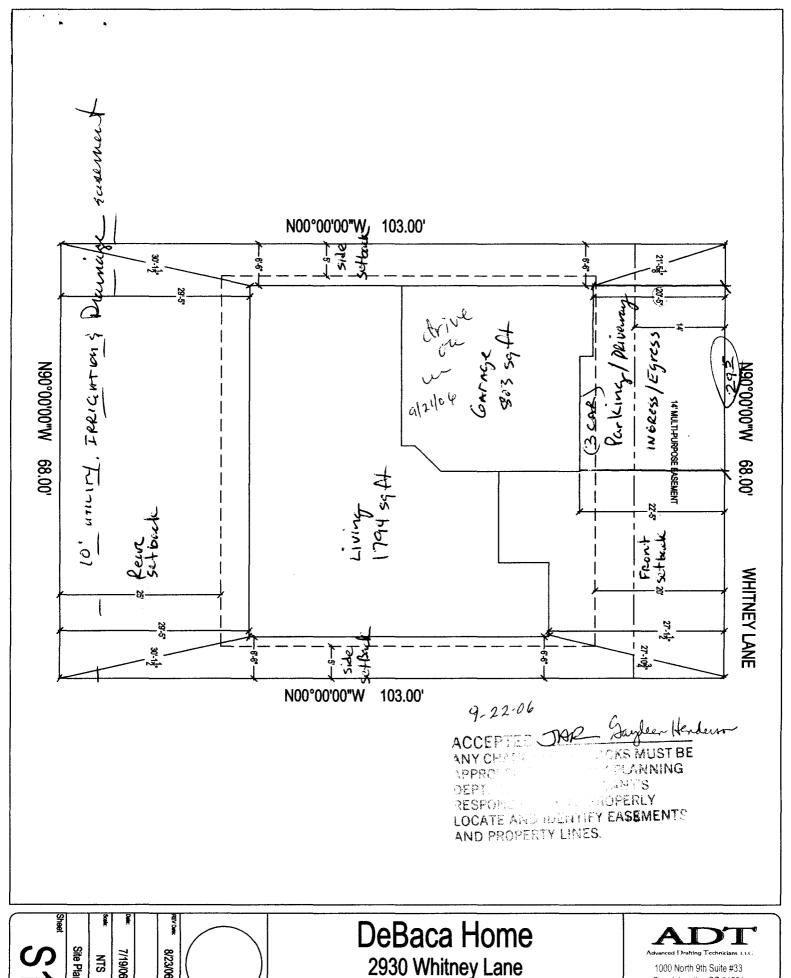

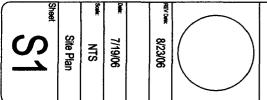

2930 Whitney Lane Grand Junction, CO. 81504

Grand Jucntion CO 81504 Phone (970) 243-8666 Fax (970) 243-4521