FEE\$	10.00
TCP\$	1589.00
SIF\$	460.00

(White: Planning)

(Yellow: Customer)

## **PLANNING CLEARANCE**

BLDG PERMIT NO.	


(Goldenrod: Utility Accounting)

(Single Family Residential and Accessory Structures)

## **Community Development Department**

Building Address 402 29 1/2 Rd	No. of Existing Bldgs No. Proposed
Parcel No. 2943 - 174 - 40 - 019	Sq. Ft. of Existing Bldgs Sq. Ft. Proposed
Subdivision COUNTRY PLACE ESTATES	Sq. Ft. of Lot / Parcel 4673
Filing   Block 3 Lot 19	Sq. Ft. Coverage of Lot by Structures & Impervious Surface
OWNER INFORMATION:	(Total Existing & Proposed) 2229  Height of Proposed Structure 24
Name TML ENTERPRISES INC	DESCRIPTION OF WORK & INTENDED USE:
Address 7.0. Box 2569	New Single Family Home (*check type below)  Interior Remodel  Other (please specify):
City / State / Zip <u>G.J.</u> CO 81502	Other (please specify).
APPLICANT INFORMATION:	*TYPE OF HOME PROPOSED:
Name TML BUTGERISES TNC	X Site Built Manufactured Home (UBC) Manufactured Home (HUD)
Address P.O. Box 2569	Other (please specify):
City / State / Zip GJ CO 8150Z NO	OTES:
Telephone 245-9271	
DECLUBED. One plat plan on 0.4/00 a 440 money abouting all a	xisting & proposed structure location(s), parking, setbacks to all
property lines, ingress/egress to the property, driveway location	on & width & all easements & rights-of-way which abut the parcel.
THIS SECTION TO BE COMPLETED BY COMP	on & width & all easements & rights-of-way which abut the parcel.  MUNITY DEVELOPMENT DEPARTMENT STAFF
property lines, ingress/egress to the property, driveway location THIS SECTION TO BE COMPLETED BY COMP	MUNITY DEVELOPMENT DEPARTMENT STAFF  Maximum coverage of lot by structures
(Pink: Building Department)

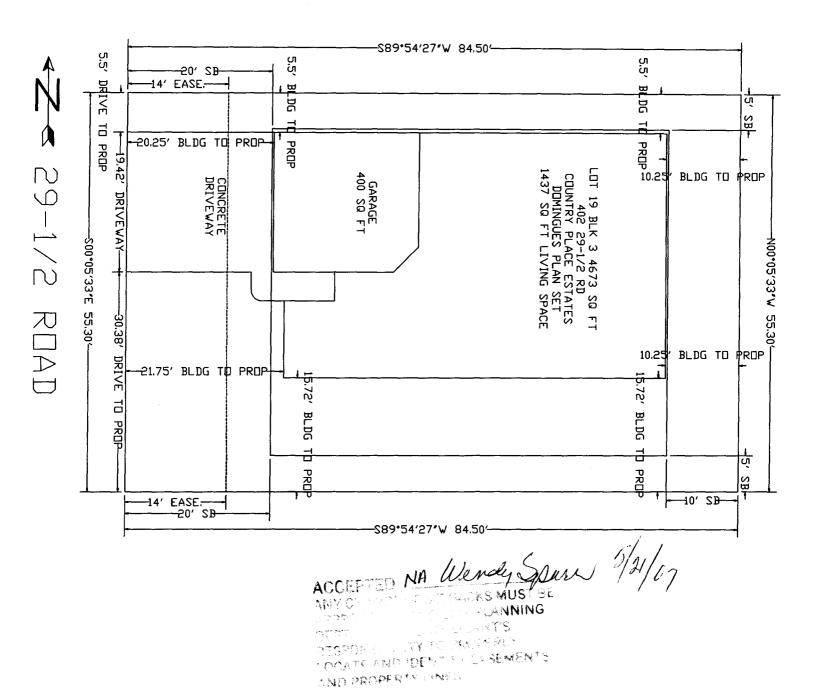

TML ENTERPRISES INC. IS THE SOLE OWNER OF THIS SET OF PLANS. ANY USE OR REPRODUCTION OF THISSE PLANS WITHOUT WRITTEN PERMISSION IS EXPRESSLY PROHIBETED UNDER COPYRIGHT LAWS. ILLEGAL USERS OF THESE PLANS WILL BE PLANS WILL BE PROSECUTED TO THE FULL EXTENT OF THE LAW.

TML ENTERPRISES

PO BOX 2569
GRAND JUNCTION
CO. 81502 (970) 245-9271

TML ENTERPRISES

PO BOX 2569
GRAND JUNCTION
CO. 81502 (970) 245-9271