FEE\$	10-
TCP \$	1589-
SIF\$	460-

(White: Planning)

(Yellow: Customer)

PLANNING CLEARANCE

BLDG	PERMIT	NO.


(Goldenrod: Utility Accounting)

(Single Family Residential and Accessory Structures)

Community Development Department

Building Address 408 1/2 29 1/2 Rd.	No. of Existing Bldgs No. Proposed
Parcel No. 2943-174-40-014	Sq. Ft. of Existing BldgsO Sq. Ft. Proposed
Subdivision COUNTRY PLACE ESTATES	Sq. Ft. of Lot / Parcel4673
Filing Block 3 Lot 14	Sq. Ft. Coverage of Lot by Structures & Impervious Surface
OWNER INFORMATION:	(Total Existing & Proposed) 2231 Height of Proposed Structure 2 4
Name TML ENTERPRISES INC Address P.O. Box 2569	DESCRIPTION OF WORK & INTENDED USE: New Single Family Home (*check type below) Interior Remodel Addition
City / State / Zip G. J CO 81502	Other (please specify):
APPLICANT INFORMATION:	*TYPE OF HOME PROPOSED:
Name TML ENTERPRISES THE	Site Built Manufactured Home (UBC) Manufactured Home (HUD) Other (please specify):
Address P.O. Box 2569	
City / State / Zip GJ CO 8/502 NO	OTES:
Telephone 970 245 927/	
REQUIRED: One plot plan, on 8 1/2" x 11" paper, showing all expreperty lines, ingress/egress to the property, driveway locatio	
property lines, ingress/egress to the property, driveway locatio THIS SECTION TO BE COMPLETED BY COMM	xisting & proposed structure location(s), parking, setbacks to all n & width & all easements & rights-of-way which abut the parcel. MUNITY DEVELOPMENT DEPARTMENT STAFF






(Pink: Building Department)

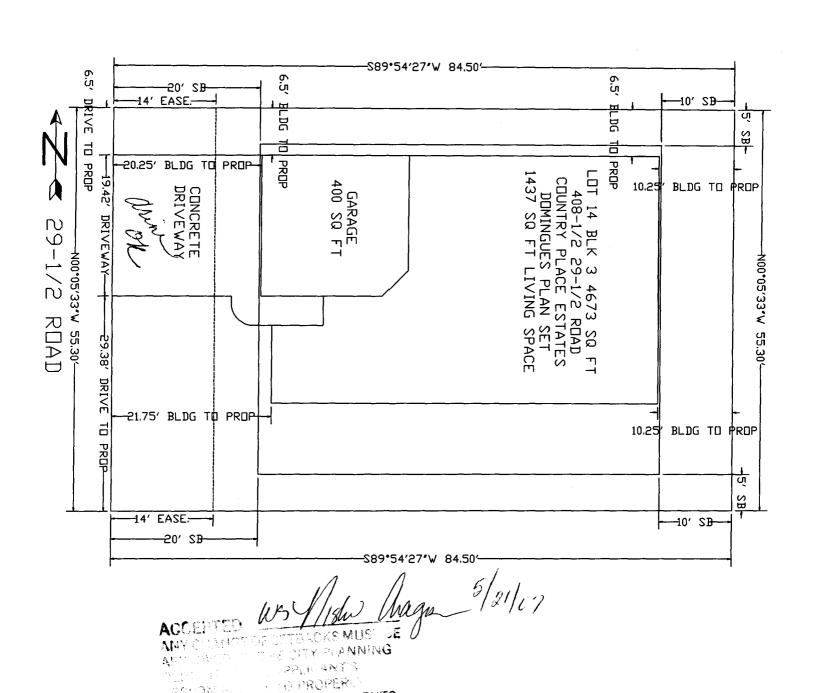

ESCONOBIA DE PROPERTO CONTE AND IDENTIFY EASEMENTS AND PROPERTY LINES

TML ENTERPRISES INC. IS THE SOLE OWNER OF THIS SET OF PLANS, ANY USE OR REPRODUCTION OF THESE PLANS WITHOUT WRITTEN PERMISSION IS EXPRESSLY PROHIBITED UNDER COPYNIGHT LAWS. IILLEGAL USERS OF THESE PLANS WILL BE PROSECUTED TO THE FULL EXTENT OF THE LAW.

TML ENTERPRISES

PO BOX 2569 GRAND JUNCTION CO. 81502 (970) 245-9271 DOMINGUES
408-1/2 29-1/2 ROAD
GRAND JUNCTION, CO

GUES
//2 ROAD
ON, CO