
FÉE \$ 10 ° PLANNING CLE	BLDG PERMIT NO.
TCP \$ 15 89.00 (Single Family Residential and	
SIF \$ 460.00 Community Developm	nent Department
45/2 Bulla Dr.	
Building Address 443 Southa De.	No. of Existing Bldgs No. Proposed
Parcel No 2943-151-13-# 00	9 Sq. Ft. of Existing Bldgs - Sq. Ft. Proposed 1735
Subdivision Chatfield III	Sq. Ft. of Lot / Parcel <u>6563</u>
Filing BlockA Lot 其一	Sq. Ft. Coverage of Lot by Structures & Impervious Surface (Total Existing & Proposed)
	(Total Existing & Proposed)
Name Kod KOCK (ONSMUCTOR Of MC WOSTEN STOPP Address 3220 CRU City/State/Zip 65 (0 81503)	DESCRIPTION OF WORK & INTENDED USE: New Single Family Home (*check type below) Interior Remodel Addition Other (please specify):
Name Roy Robidout	*TYPE OF HOME PROPOSED: Site Built Manufactured Home (UBC) Manufactured Home (HUD)
Address 1897 Tahoe Cr	Other (please specify):
City / State / Zip GT. CO. 81505	NOTES:
Telephone 341-344-9	
REQUIRED: One plot plan, on 8 1/2" x 11" paper, showing all	existing & proposed structure location(s), parking, setbacks to all
REQUIRED: One plot plan, on 8 1/2" x 11" paper, showing all property lines, ingress/egress to the property, driveway loca	tion & width & all easements & rights-of-way which abut the parcel.
REQUIRED: One plot plan, on 8 1/2" x 11" paper, showing all property lines, ingress/egress to the property, driveway loca THIS SECTION TO BE COMPLETED BY COM ZONE F-5 SETBACKS: Front 20 from PL Rear Side from PL Maximum Height of Structure(s) 35' Voting District Driveway Location Approval Drive Modifications to this Planning Clearance must be approve Structure authorized by this application cannot be occupied Occupancy has been issued, if applicable, by the Building I hereby acknowledge that I have read this application and the ordinances, laws, regulations or restrictions which apply to a action, which may include but not necessarily be limited to Applicant Signature Set MayLer Vepartment Approval Juctor R. 


 VALID FOR SIX MONTHS FROM DATE OF ISSUANCE (Section 2.2.C.1 Grand Junction Zoning & Development Code) (White: Planning)
 (Yellow: Customer)
 (Pink: Building Department)
 (Goldenrod: Utility Accounting)

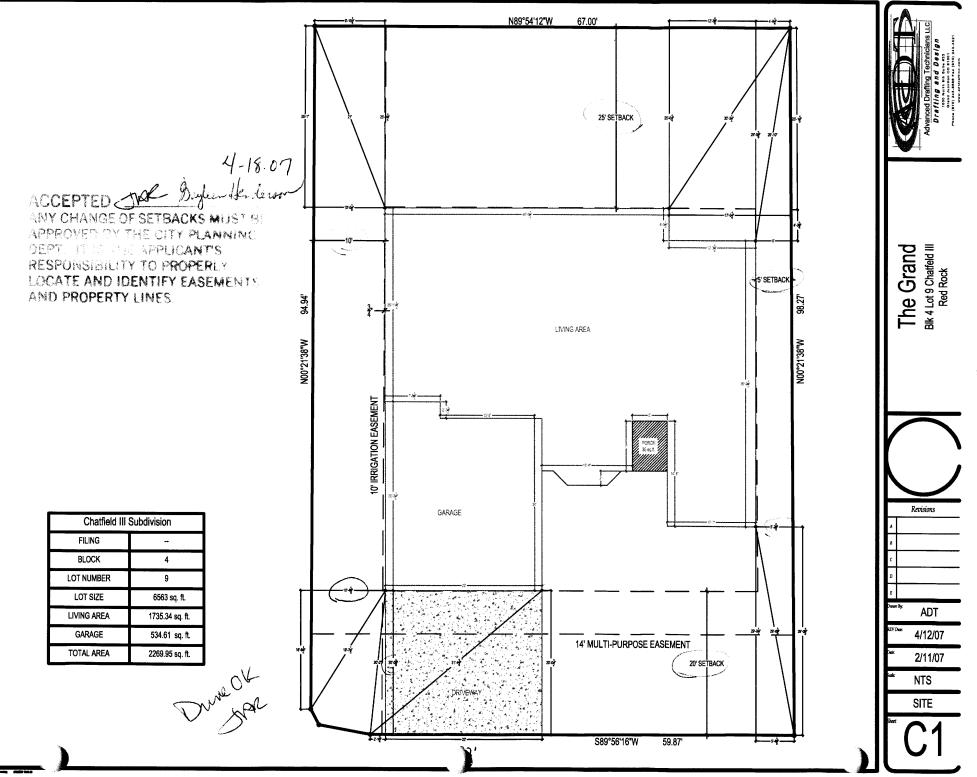

. .