

FEE \$ 10. ^{00/}
TCP \$ 1589. ^{00/}
SIF \$ 460. ^{00/}

PLANNING CLEARANCE
 (Single Family Residential and Accessory Structures)
Community Development Department

BLDG PERMIT NO. _____

Building Address 412 1/2 Chert
 Parcel No. 2943-173-44-018
 Subdivision Country Place Estates
 Filing _____ Block 7 Lot 18

No. of Existing Bldgs 0 No. Proposed 1
 Sq. Ft. of Existing Bldgs N/A Sq. Ft. Proposed 2075
 Sq. Ft. of Lot / Parcel 4521
 Sq. Ft. Coverage of Lot by Structures & Impervious Surface
 (Total Existing & Proposed) 2100
 Height of Proposed Structure 25'

OWNER INFORMATION:

Name James Mitchell
 Address 6907 Mt Nimbus
 City / State / Zip Wellington, CO 80549

DESCRIPTION OF WORK & INTENDED USE:

New Single Family Home (*check type below)
 Interior Remodel Addition
 Other (please specify): _____

APPLICANT INFORMATION:

Name Danny Powlson
 Address 1545 Road Ave.
 City / State / Zip G.J. / CO / 81501
 Telephone 250-3530

***TYPE OF HOME PROPOSED:**

Site Built Manufactured Home (UBC)
 Manufactured Home (HUD)
 Other (please specify): _____

NOTES: _____

REQUIRED: One plot plan, on 8 1/2" x 11" paper, showing all existing & proposed structure location(s), parking, setbacks to all property lines, ingress/egress to the property, driveway location & width & all easements & rights-of-way which abut the parcel.

THIS SECTION TO BE COMPLETED BY COMMUNITY DEVELOPMENT DEPARTMENT STAFF	
ZONE <u>R-8</u>	Maximum coverage of lot by structures <u>70%</u>
SETBACKS: Front <u>20</u> from property line (PL)	Permanent Foundation Required: YES <u>X</u> NO _____
Side <u>5</u> from PL Rear <u>10</u> from PL	Parking Requirement <u>2</u>
Maximum Height of Structure(s) <u>35'</u>	Special Conditions _____
Voting District <u>C</u> Driveway Location Approval <u>[Signature]</u> (Engineer's Initials)	_____

Modifications to this Planning Clearance must be approved, in writing, by the Community Development Department. The structure authorized by this application cannot be occupied until a final inspection has been completed and a Certificate of Occupancy has been issued, if applicable, by the Building Department (Section 305, Uniform Building Code).


I hereby acknowledge that I have read this application and the information is correct; I agree to comply with any and all codes, ordinances, laws, regulations or restrictions which apply to the project. I understand that failure to comply shall result in legal action, which may include but not necessarily be limited to non-use of the building(s).

Applicant Signature [Signature] Date 6/5/07
 Department Approval [Signature] Date 6-8-07

Additional water and/or sewer tap fee(s) are required: YES <input checked="" type="checkbox"/> NO <input type="checkbox"/>	W/O No. <u>20334</u>
Utility Accounting <u>[Signature]</u>	Date <u>6/8/07</u>

VALID FOR SIX MONTHS FROM DATE OF ISSUANCE (Section 2.2.C.1 Grand Junction Zoning & Development Code)
 (White: Planning) (Yellow: Customer) (Pink: Building Department) (Goldenrod: Utility Accounting)

Drawn By	A. COLLIER
Date	Nov. 22, 2006
Project #	06-14-08
Plan #	100% CONSTRUCTION
Sheet	C1.1
Scale	AS SHOWN

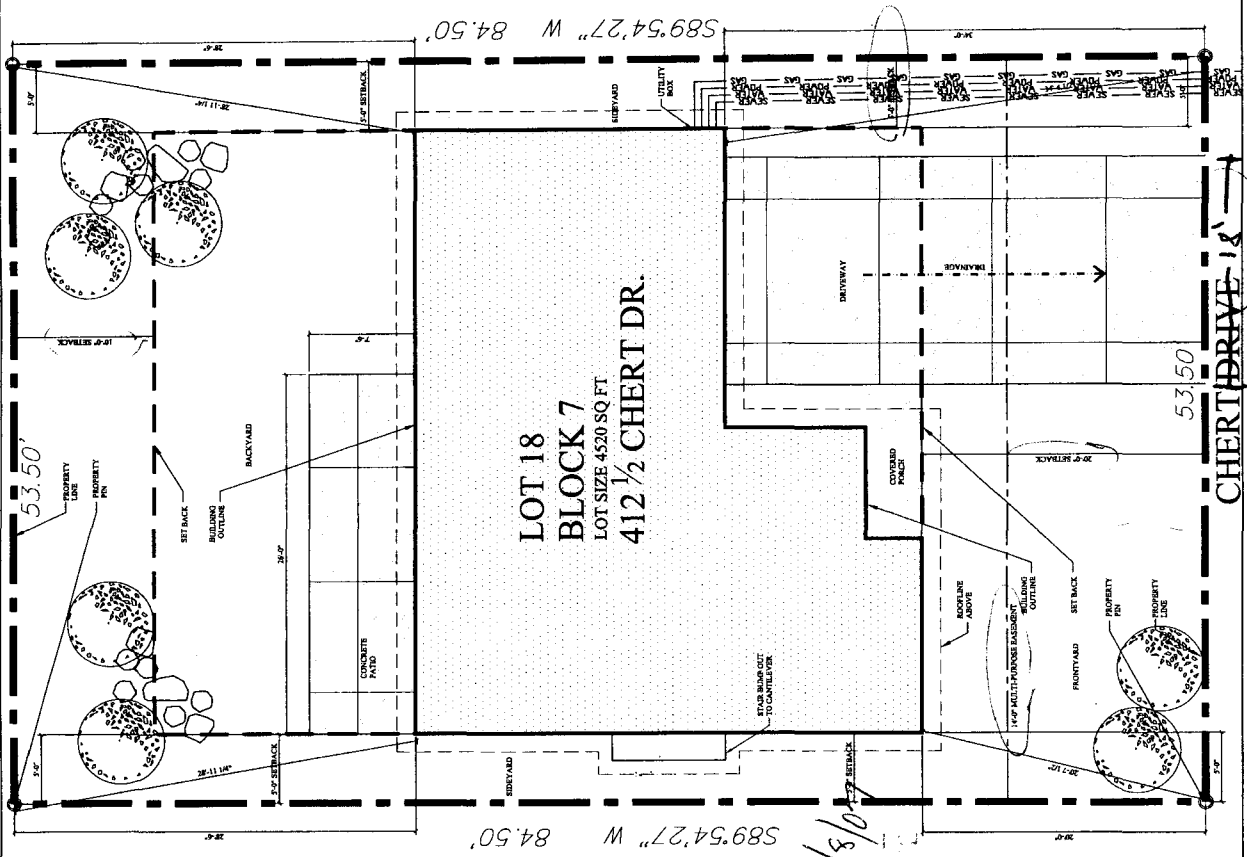




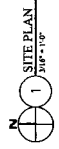

1 SITE PLAN
 3/16" = 1'-0"

Handwritten notes and signature: "John R..." and "6/8/07".