

FEE \$	10.00
TCP \$	1589.00
SIF \$	460.00

PLANNING CLEARANCE
 (Single Family Residential and Accessory Structures)
Community Development Department

BLDG PERMIT NO. _____

P

Building Address 419 1/2 Chert Dr. No. of Existing Bldgs 0 No. Proposed 1
 Parcel No. 2943-173-45-006 Sq. Ft. of Existing Bldgs 0 Sq. Ft. Proposed 1837
 Subdivision Country Place Estates Sq. Ft. of Lot / Parcel 4701
 Filing _____ Block 88 Lot 86 Sq. Ft. Coverage of Lot by Structures & Impervious Surface (Total Existing & Proposed) 2300
 Height of Proposed Structure 18'

OWNER INFORMATION:

Name Poulson Holdings
 Address 1545 Reed Ave
 City / State / Zip G.J. / CO / 81501

DESCRIPTION OF WORK & INTENDED USE:

New Single Family Home (*check type below)
 Interior Remodel Addition
 Other (please specify): _____

APPLICANT INFORMATION:

Name Danny Poulson
 Address 1545 Reed Ave.
 City / State / Zip G.J. / CO / 81501
 Telephone 250-3530

***TYPE OF HOME PROPOSED:**

Site Built Manufactured Home (UBC)
 Manufactured Home (HUD)
 Other (please specify): _____

NOTES: _____

REQUIRED: One plot plan, on 8 1/2" x 11" paper, showing all existing & proposed structure location(s), parking, setbacks to all property lines, ingress/egress to the property, driveway location & width & all easements & rights-of-way which abut the parcel.

THIS SECTION TO BE COMPLETED BY COMMUNITY DEVELOPMENT DEPARTMENT STAFF	
ZONE <u>R-8</u>	Maximum coverage of lot by structures <u>70%</u>
SETBACKS: Front <u>20</u> from property line (PL)	Permanent Foundation Required: YES <u>X</u> NO _____
Side <u>5</u> from PL Rear <u>10</u> from PL	Parking Requirement <u>2</u>
Maximum Height of Structure(s) <u>35'</u>	Special Conditions _____
Voting District <u>C</u>	Driveway Location Approval <u>JAR</u> (Engineer's Initials)

Modifications to this Planning Clearance must be approved, in writing, by the Community Development Department. The structure authorized by this application cannot be occupied until a final inspection has been completed and a Certificate of Occupancy has been issued, if applicable, by the Building Department (Section 305, Uniform Building Code).

I hereby acknowledge that I have read this application and the information is correct; I agree to comply with any and all codes, ordinances, laws, regulations or restrictions which apply to the project. I understand that failure to comply shall result in legal action, which may include but not necessarily be limited to non-use of the building(s).

Applicant Signature [Signature] Date 8/19/07
 Department Approval [Signature] Date 9/6/07

Additional water and/or sewer tap fee(s) are required: <input checked="" type="checkbox"/> YES <input type="checkbox"/> NO	W/O No. <u>20600</u>
Utility Accounting <u>[Signature]</u>	Date <u>9/6/07</u>

VALID FOR SIX MONTHS FROM DATE OF ISSUANCE (Section 2.2.C.1 Grand Junction Zoning & Development Code)
 (White: Planning) (Yellow: Customer) (Pink: Building Department) (Goldenrod: Utility Accounting)

LOT 6 BLOCK 8
419 1/2 CHERT DRIVE
GRAND JUNCTION, COLORADO 81504


MESA-MONUMENT CONSTRUCTION, LLC
DANNY POULSON (970) 250-3530

Date	
Scale	AS SHOWN

CL.1
SITE PLAN

Proposed 10' SETBACK

20' Setback
Drive Dr

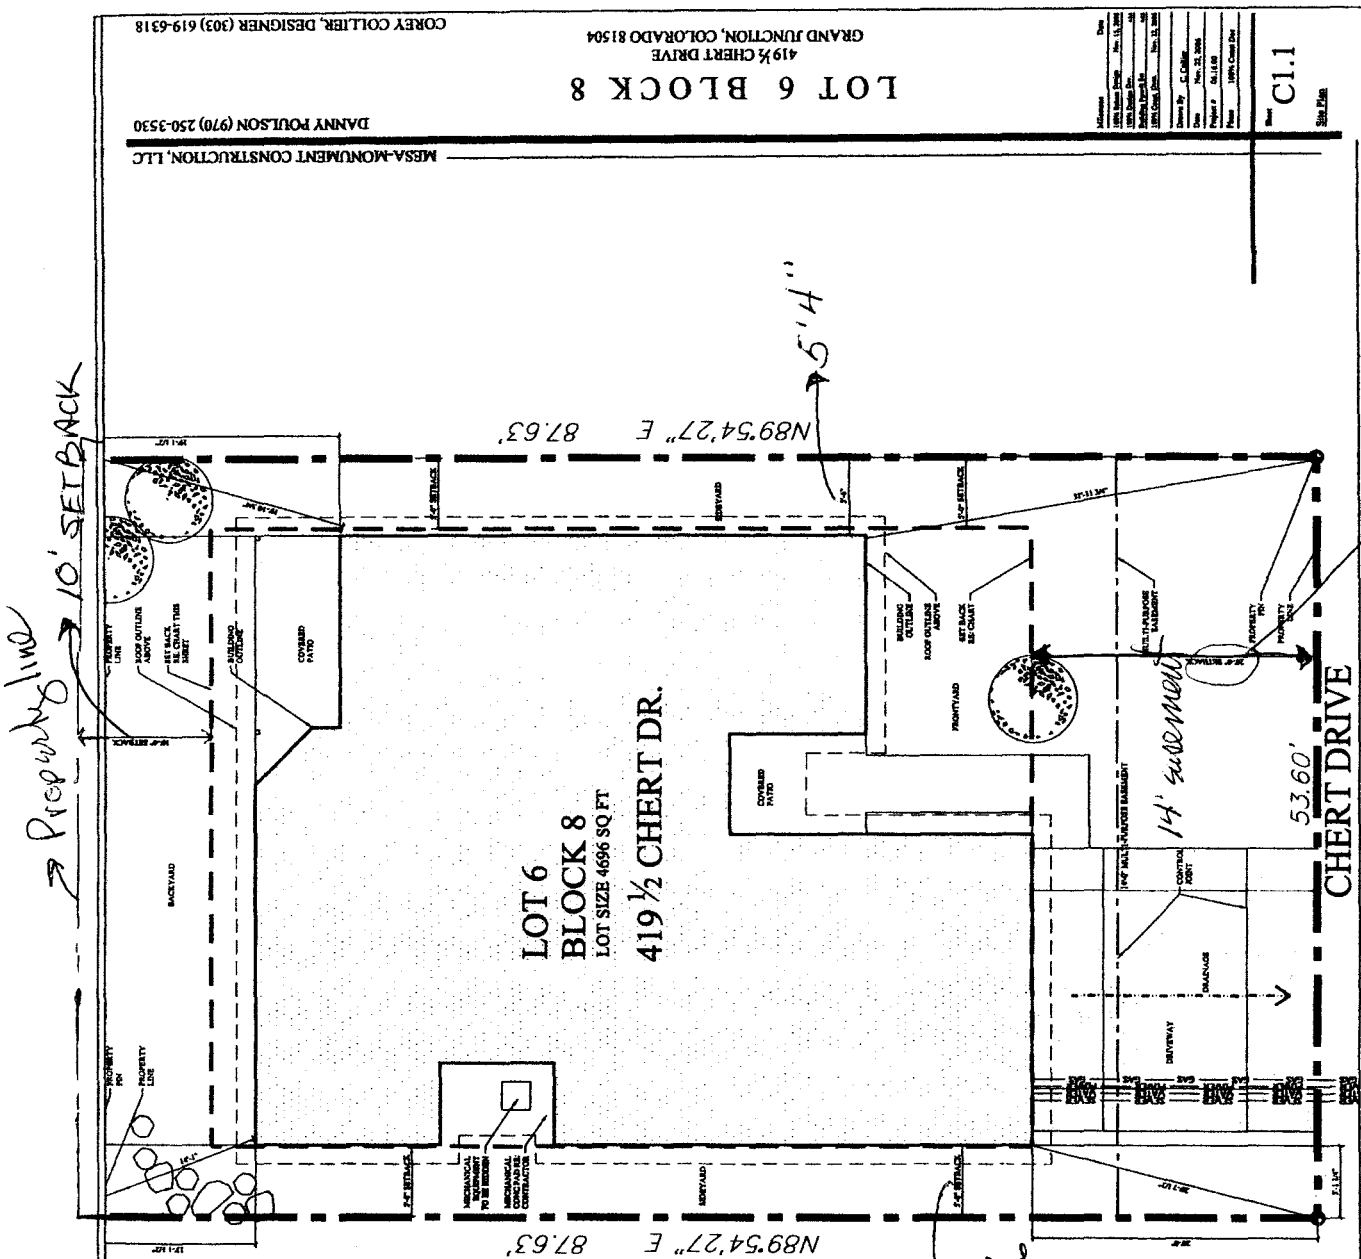

LOT 6
BLOCK 8
LOT SIZE 4696 SQ. FT.
419 1/2 CHERT DR.



1 SITE PLAN