
•		
FEE\$ 10.00 PLANNING	CLEARANCE	BLDG PERMIT NO.
	ntial and Accessory Structures) evelopment Department)
SIF \$ 460.00	evelopment Department	
Building Address 737 Woodridge		is No. Proposed
Parcel No. 2701 - 341 - 37 - 02	Sq. Ft. of Existing B	Ildgs Sq. Ft. Proposed _1085
Subdivision inlood ridge	Sq. Ft. of Lot / Parc	el_2566
Filing Block Lot _2	Sq. Ft. Coverage of (Total Existing & Pre	Lot by Structures & Impervious Surface
OWNER INFORMATION:	Height of Proposed	Structure
Name <u>BEDHART Homes ar We</u>	and ridge DESCRIPTION O	F WORK & INTENDED USE: nily Home (*check type below)
Address 2320-EZ. Rd.	Interior Remode	Addition
City / State / Zip Grand Jer COBIST		pecify): <u>Jewnhome-attache</u> Single Yanuly
APPLICANT INFORMATION:	TYPE OF HOME	· · · · · · · · · · · · · · · · · · ·
Name <u>RED HART CONT.</u>	Site Built Manufactured H	Home (HUD)
Address 2320-E'z Rd.	Other (please s	
City / State / Zip Grend Jer, CO SN	03 NOTES: New S	IF Runch Townhome
Telephone 234-0822 - Dan	w/10	ar attached yarage
REQUIRED: One plot plan, on 8 1/2" x 11" paper, sho property lines, ingress/egress to the property, driver		
	BY COMMUNITY DEVELOP	MENT DEPARTMENT STAFF
zone	Maximum coverag	ge of lot by structures
SETBACKS: Front 20 from property line (F	PL) Permanent Found	lation Required: YES_V_NO
Side 🔴 from PL Rear _/O fro	om PL Parking Requirem	ent
Maximum Height of Structure(s)	Special Conditions	6
Voting District Driveway Location Approval	eer's Initials)	
Modifications to this Planning Clearance must be structure authorized by this application cannot be Occupancy has been issued, if applicable, by the E	occupied until a final inspectio	n has been completed and a Certificate of
I hereby acknowledge that I have read this application ordinances, laws, regulations or restrictions which a action, which may include but not necessarily be in	nited to non-use of the building	nd that failure to comply shall result in legal g(s).
Applicant Signature	Da Da	te July 9 2005

Applicant Signature Dulk. Dull	Date <u>July 7 2005</u>
Department Approval TPR Wendy Spin	Date 1/2/0/07
Additional water and/or sewer tap fee(s) are required: YES / NC	D W/O NO. 20490
Utility Accounting	Date 7/26/07
VALID FOR SIX MONTHS FROM DATE OF ISSUANCE (Section 2.2.C.)	1 Grand Junction Zoning & Development Code)

 VALID FOR SIX MONTHS FROM DATE OF ISSUANCE (Section 2.2.C.1 Grand Juriction Zoning & Development Code)

 (White: Planning)
 (Yellow: Customer)
 (Pink: Building Department)
 (Goldenrod: Utility Accounting)

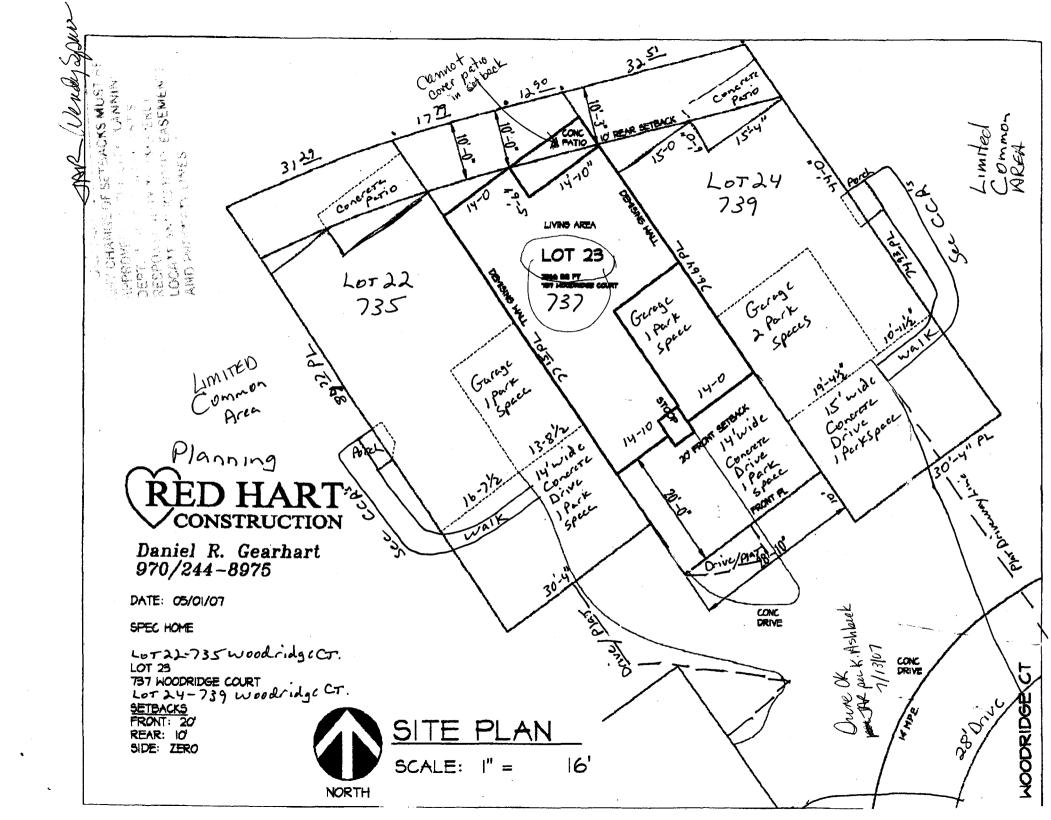

FAX No. 9702457706 UNITED TITLE FRI/JUL/13/2007 13:47 RECEPTION #: 2372380, BK 4388 PG 782 04/02/2007 at 11:22:03 AM, 2 OF 10, R \$50.00 \$ \$1.00 Doc Code: COVENANTS Janice Rich, Mesa County, CO CLERK AND RECORDER 737 Woodridge Ct

> from time to time. Common Area shall be divided into two categories, "General Common Area" and "Limited Common Area" having the following definitions:

P. 002

"General Common Area" means all Common Area except all Limited Common Area and may be designated by abbreviation on the plat as "GCB;"

"Limited Common Area" means those Common Areas designated or reserved herein or on the plat map for the exclusive use by fewer than all of the Owners of Lots, and may be designated by abbreviation on the plat as "LCE" and shall include all sidewalks, driveways and patios constructed by or on behalf of the Declarant for use by specific Unit Owners, regardless of whether they are designated as LCE's on the plat map. The Limited Common Area is for the exclusive use of the Owners of the Units to which they are attached or relate, their respective invitees and guests.

"Lot" shall mean and refer to any plot of land shown upon any recorded subdivision map Section 5. of the Properties with the exception of the Common Area.

"Declarant" shall mean and refer to Woodridge, LLC, its successors and assigns if such Section 6. successors or assigns should acquire more than one undeveloped Lot from the Declarant for the purpose of development,

"Architectural Control Committee" shall mean and refer to the Architectural Control Section 7. Committee set forth at Article VI of this Declaration,

ARTICLE II

PROPERTY RIGHTS IN THE LOTS AND COMMON AREAS

Section 1. Title to the Lots. The Declarant, its successors and assigns, shall convey fee simple title to the Lots subject to current real property taxes, which taxes shall be promited to the date of transfer, and easements, conditions and reservations then of record, including those set forth in this Declaration. No Owner shall be entitled to subdivide a Lot, nor shall any Owner be entitled to sever his ownership interest in a Lot from his membership in the Association, provided that this clause shall not be construed as precluding the Owner of a Lot from creating a cotenancy or joint tenancy with any other person or persons.

Section 2. Title to the Common Area. The Declarant, its successors and assigns, shall convey by appropriate deed fee simple title to the Common Area to the Association, free and clear of all lieus and encumbrances, except essements, conditions and reservations then of record, excluding those set forth in this Declaration.

Section 3. Members' Easements of Enforment. Every Member shall have a non-exclusive right and easement in and to the Common Area, including, but not limited to, an easement for ingress, egress and subjacent support over and through the Common Area, and casements for utilities and drainage. Each such easement shall be apputcesson to and shall pass with the title to every Lot, subject to the following provisions:

The right of the Association to adopt uniform rules and regulations pertaining to the use and enjoyment of the Common Area and for the use, operation and maintanance of any irrigation system owned by the Association.

The Association may borrow money and grant a mortgage or deed of trust on the Ъ. Common Area or any part thereof for the purpose of improving the Common Area, provided any such mortgage or deed of trust shall be expressly subordinate to the rights of the Members herein;

The right of the Association to suspend a Member's voting rights for any period during C. which any Assessment against his Lot remains unpaid and delinquent; and for a period not to exceed (30) days for any single infraction of the rules and regulations of the Association, provided that any suspension of such voting rights, except for failure to pay assessments, shall be made only by the Association or a daily appointed committee thereof, after notice and hearing given and held in accordance with the Bylaws of the Association;

The right of the Association to dedicate or transfer all or any part of the Common Area to đ. any public agency, authority or utility for such purposes and subject to such conditions as may be agreed to by the Members. No such dedication or transfer shall be effective unless an instrument signed by Members entitled to cast