FÉE'\$	10
TCP\$	•
SIF\$	

## **PLANNING CLEARANCE**

RI	DG	DE	⊋МІТ	NO.

(Single Family Residential and Accessory Structures)

## **Public Works & Planning Department**


Building Address 2840 Herri CT	No. of Existing Bldgs No. Proposed
Parcel No. 2943 - 303 - 62 - 009	Sq. Ft. of Existing Bldgs 646 Sq. Ft. Proposed 60 1
Subdivision Annowheso Acres	Sq. Ft. of Lot / Parcel 9,278
Filing Block Lot	Sq. Ft. Coverage of Lot by Structures & Impervious Surface
OWNER INFORMATION:	(Total Existing & Proposed)Height of Proposed Structure
Name Steve Wolfier  Address Z840 Acris CT  City/State/Zip Grend Straction Co 8/	DESCRIPTION OF WORK & INTENDED USE:  New Single Family Home (*check type below) Interior Remodel Other (please specify):
APPLICANT INFORMATION	*TYPE OF HOME PROPOSED:
Name	Site Built Manufactured Home (UBC) Manufactured Home (HUD) Other (please specify):
	NOTES have as see 31 Ca
City / State / Zip	
Telephone 507-350-8224	property live
property lines, ingress/egress to the property, driveway locat	existing & proposed structure location(s), parking, setbacks to all ion & width & all easements & rights-of-way which abut the parcel.
THIS SECTION TO BE COM	PLETED BY PLANNING STAFF
ZONEKS	Maximum coverage of lot by structures
SETBACKS: Front from property line (PL)	Permanent Foundation Required: YESNO
Side from PL Rear from PL	Floodplain Certificate Required: YESNO
Maximum Height of Structure(s)	Parking Requirement
Voting District Driveway Location Approval(Engineer's Initia	Special Conditionss
	d, in writing, by the Public Works & Planning Department. The until a final inspection has been completed and a Certificate of
Company has seen assure, it applicable, by the building t	Department.
I hereby acknowledge that I have read this application and th	e information is correct; I agree to comply with any and all codes, ne project. I understand that failure to comply shall result in legal

VALID FOR SIX MONTHS FROM DATE OF ISSUAN¢E (Section 2.2.C.4 Grand Junction Zoning & Development Code)

(White: Planning) (Yellow: Customer) (Pink: Building Department) (Goldenrod: Utility Accounting)

## - Gity of Grand Junction GIS Zoning Map ©



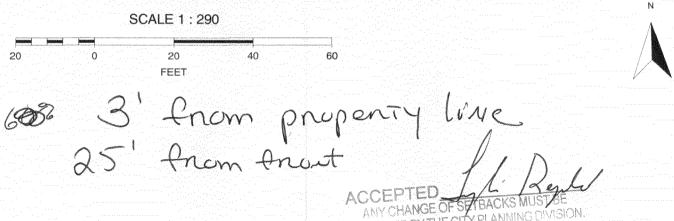

TIS THE APPLICANT'S RESPONSIBILITY TO PROPERLY LOCATE AND DENTIFY EASEMENTS AND PROPERTY LINES.