FEE \$	10.00
TCP\$	1589.00
SIF\$	480.00

PLANNING CLEARANCE

BLDG PERMIT NO.


(Single Family Residential and Accessory Structures)

Community Development Department

Building Address 3033 Prairie View	No. of Existing Bldgs No. Proposed
Parcel No. 2943-162-99-005	Sq. Ft. of Existing Bldgs Sq. Ft. Proposed
Subdivision Prairie View South Sec. 16	Sq. Ft. of Lot / Parcel 7850 Sq. Ft.
Filing Block Lot _5	Sq. Ft. Coverage of Lot by Structures & Impervious Surface (Total Existing & Proposed) 1344+440+17 = 1801 = 227
OWNER INFORMATION:	Height of Proposed Structure <36'
Name Michael + Mary Jane Seriani	DESCRIPTION OF WORK & INTENDED USE: New Single Family Home (*check type below)
Address 620 Moss Way	Interior Remodel Addition Other (please specify):
City/State/Zip Palisade CD 81526	
APPLICANT INFORMATION:	*TYPE OF HOME PROPOSED: Site Built Manufactured Home (UBC
Name	Manufactured Home (HUD)
Address Same as me	Other (please specify):
City / State / Zip NO	TES:
Telephone464-4902	
REQUIRED: One plot plan, on 8 1/2" x 11" paper, showing all ex	isting & proposed structure location(s), parking, setbacks to a
property lines, ingress/egress to the property, driveway location	& width & all easements & rights-of-way which abut the parce

VALID FOR SIX MONTHS FROM DATE OF ISOUANCE (Section 2.2.C.1 Grand Junction Zoning & Development Code)

(White: Planning) (Yellow: Customer) (Pink: Building Department) (Goldenrod: Utility Accounting)

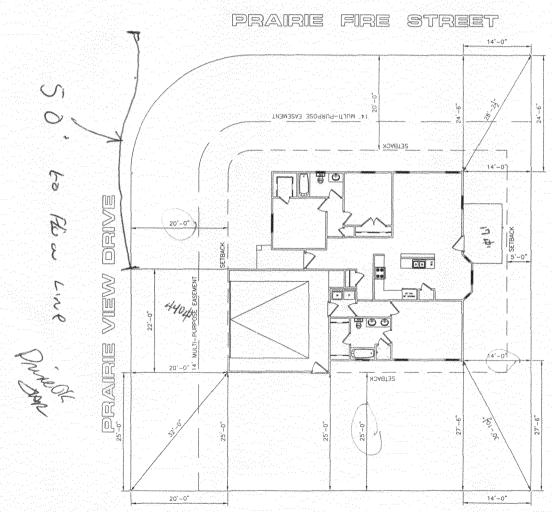

APPROVED BY THE CITY PLANNING DIVISION. IT IS THE APPLICANT'S RESPONSIBILITY TO CCEPTED AND PAR ANY CHANGE OF SETBACKS MUST BE EASEMENTS AND PROPERTY LINES. PROPERLY LOCATE AND IDENTIFY ACCEPTED

ALL SETBACK AND EASEMENT ENCROACHMENTS PRIOR TO CONSTRUCTION BUILDER TO VERIFY NOTE



BRICK LEDGE NOTE:
DIMENSION LINES ARE PULLED FROM
EDGE OF BRICK LEDGE. IF NO BRICK LEDGESISTS, DIMENSIONS WILL BE FROM EDGE
OF FOUNDATION. NOTE GRADE MUST SLOPE AWAY FROM HOUSE 6" OF FALL IN THE FIRST 10' OF DISTANCE PER LOCAL BUILDING CODE.

NOTICE.








SCALE: 1*** SCALE: 1****