

FEE \$	10 ⁰⁰
TCP \$	/
SIF \$	/

PLANNING CLEARANCE

(Single Family Residential and Accessory Structures)

Community Development Department

BLDG PERMIT NO. M

22921-14645

Building Address 539 Rim Drive

No. of Existing Bldgs _____ No. Proposed _____

Parcel No. 294508323016

Sq. Ft. of Existing Bldgs _____ Sq. Ft. Proposed _____

Subdivision South Rim

Sq. Ft. of Lot / Parcel _____

Filing _____ Block _____ Lot _____

Sq. Ft. Coverage of Lot by Structures & Impervious Surface (Total Existing & Proposed) _____

Height of Proposed Structure _____

OWNER INFORMATION:

Name Lance + Jean Reynoso

DESCRIPTION OF WORK & INTENDED USE:

Address 539 Rim Drive

- New Single Family Home (*check type below)
- Interior Remodel Addition
- Other (please specify): deck addition

City / State / Zip Grand Junction, CO 81503

3x9

APPLICANT INFORMATION:

***TYPE OF HOME PROPOSED:**

Name Lance Reynoso

- Site Built Manufactured Home (UBC)
- Manufactured Home (HUD)
- Other (please specify): _____

Address 539 Rim Drive

City / State / Zip Grand Junction, CO 81503 NOTES: _____

Telephone 970-255-7447

REQUIRED: One plot plan, on 8 1/2" x 11" paper, showing all existing & proposed structure location(s), parking, setbacks to all property lines, ingress/egress to the property, driveway location & width & all easements & rights-of-way which abut the parcel.

THIS SECTION TO BE COMPLETED BY COMMUNITY DEVELOPMENT DEPARTMENT STAFF

ZONE PD

Maximum coverage of lot by structures _____

SETBACKS: Front _____ from property line (PL)

Permanent Foundation Required: YES _____ NO _____

Side _____ from PL Rear _____ from PL

Parking Requirement _____

Maximum Height of Structure(s) _____

Special Conditions _____

Voting District _____ Driveway Location Approval _____
(Engineer's Initials)

Modifications to this Planning Clearance must be approved, in writing, by the Community Development Department. The structure authorized by this application cannot be occupied until a final inspection has been completed and a Certificate of Occupancy has been issued, if applicable, by the Building Department (Section 305, Uniform Building Code).

I hereby acknowledge that I have read this application and the information is correct; I agree to comply with any and all codes, ordinances, laws, regulations or restrictions which apply to the project. I understand that failure to comply shall result in legal action, which may include but not necessarily be limited to non-use of the building(s).

Applicant Signature Lance Reynoso Date 6-9-08

Department Approval Pat Dunlop Date 6/9/08

Additional water and/or sewer tap fee(s) are required: YES NO W/O No water/sewer charge.



Utility Accounting [Signature] Date 6/9/08

VALID FOR SIX MONTHS FROM DATE OF ISSUANCE (Section 2.2.C.1 Grand Junction Zoning & Development Code)
(White: Planning) (Yellow: Customer) (Pink: Building Department) (Goldenrod: Utility Accounting)

539 Rim Drive



SCALE 1 : 710

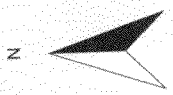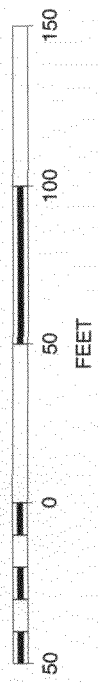

ACCEPTED *Pat Range 6/9/08*
ANY CHANGE OF SETBACKS MUST BE
APPROVED BY THE CITY PLANNING DIVISION.
IT IS THE APPLICANT'S RESPONSIBILITY TO
PROPERLY LOCATE AND IDENTIFY
EASEMENTS AND PROPERTY LINES.