


Scale 15'

Vacant lot owned by + used for parking By High Noon Solar
← 150' →

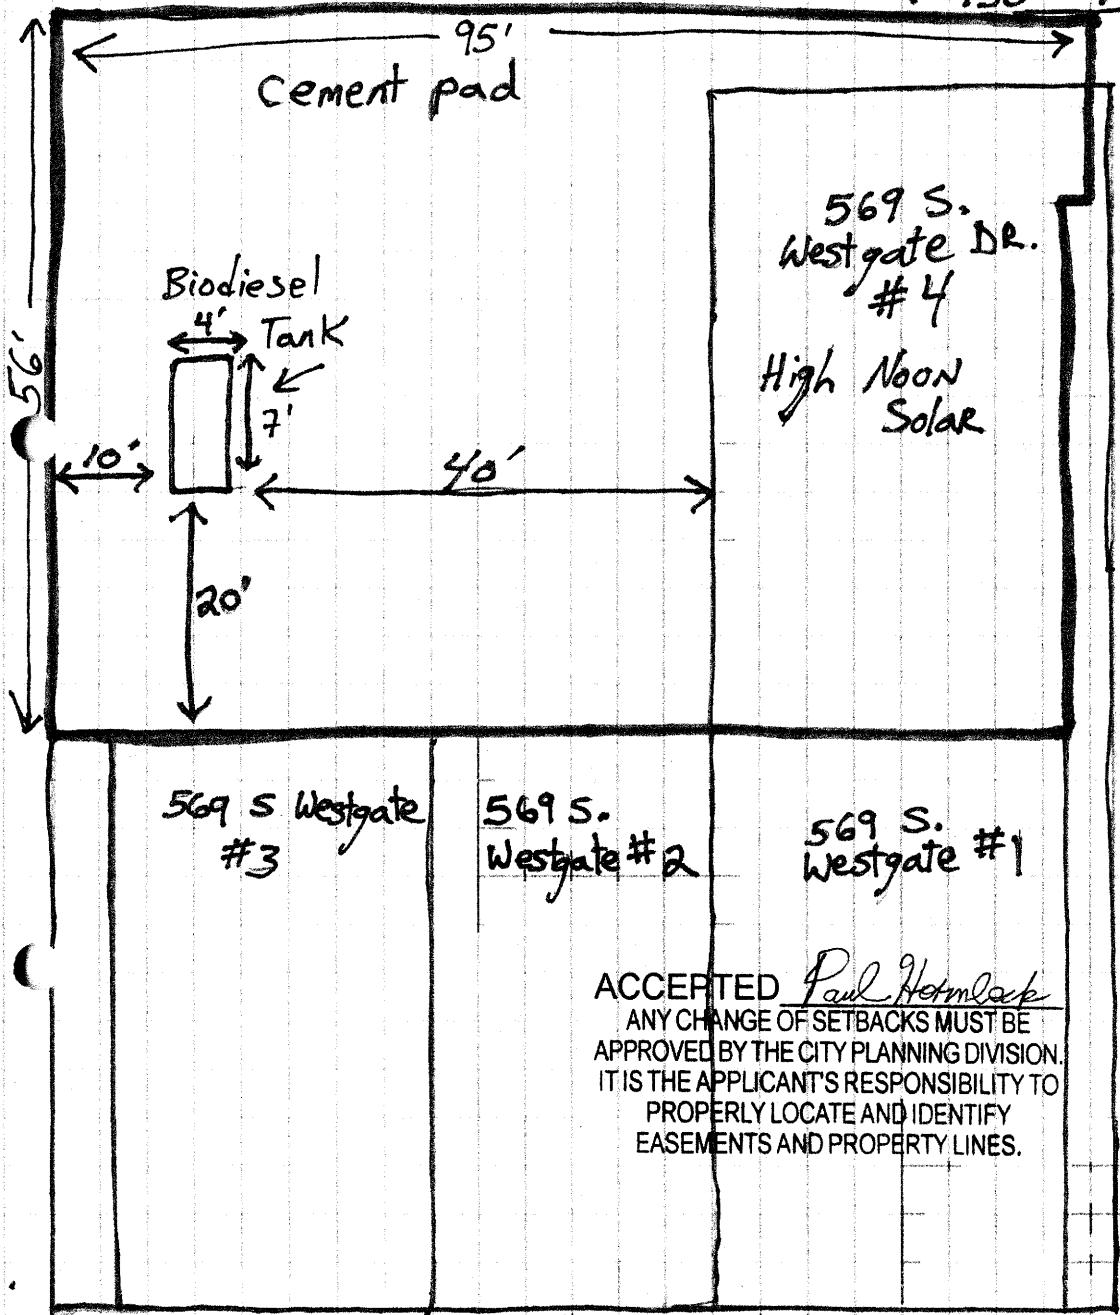

↑
SHARED PARKING

Landscaped area

DRIVEWAY

South Westgate Drive

Landscaped area

Shared PARKING

