

FEE \$	10 <sup>00</sup>
TCP \$	/
SIF \$	/

**PLANNING CLEARANCE**  
 (Single Family Residential and Accessory Structures)  
**Public Works & Planning Department**

BLDG PERMIT NO. 13742-0

Building Address 2277 Greenbriar Ct  
 Parcel No. 2945-074-16-020  
 Subdivision Bluffs West  
 Filing \_\_\_\_\_ Block \_\_\_\_\_ Lot \_\_\_\_\_

No. of Existing Bldgs 1 No. Proposed 1  
 Sq. Ft. of Existing Bldgs 1700 Approx Sq. Ft. Proposed 280  
 Sq. Ft. of Lot / Parcel \_\_\_\_\_  
 Sq. Ft. Coverage of Lot by Structures & Impervious Surface  
 (Total Existing & Proposed) \_\_\_\_\_  
 Height of Proposed Structure \_\_\_\_\_

**OWNER INFORMATION:**

Name Paulette Bourget  
 Address 2277 Greenbriar Ct  
 City / State / Zip \_\_\_\_\_

DESCRIPTION OF WORK & INTENDED USE:  
 New Single Family Home (\*check type below)  
 Interior Remodel  Addition  
 Other (please specify): Detached Greenhouse

**APPLICANT INFORMATION:**

Name Same  
 Address \_\_\_\_\_  
 City / State / Zip \_\_\_\_\_  
 Telephone \_\_\_\_\_

\*TYPE OF HOME PROPOSED:  
 Site Built  Manufactured Home (UBC)  
 Manufactured Home (HUD)  
 Other (please specify): Greenhouse 14x20

NOTES: This is a agriculture building

**REQUIRED: One plot plan, on 8 1/2" x 11" paper, showing all existing & proposed structure location(s), parking, setbacks to all property lines, ingress/egress to the property, driveway location & width & all easements & rights-of-way which abut the parcel.**

**THIS SECTION TO BE COMPLETED BY PLANNING STAFF**

ZONE <u>RD</u>	Maximum coverage of lot by structures _____
SETBACKS: Front <u>25'</u> from property line (PL)	Permanent Foundation Required: YES _____ NO _____
Side <u>7'</u> from PL Rear <u>10'</u> from PL	Floodplain Certificate Required: YES _____ NO _____
Maximum Height of Structure(s) _____	Parking Requirement _____
Voting District _____ Driveway Location Approval _____ (Engineer's Initials)	Special Conditions _____

Modifications to this Planning Clearance must be approved, in writing, by the Public Works & Planning Department. The structure authorized by this application cannot be occupied until a final inspection has been completed and a Certificate of Occupancy has been issued, if applicable, by the Building Department.

I hereby acknowledge that I have read this application and the information is correct; I agree to comply with any and all codes, ordinances, laws, regulations or restrictions which apply to the project. I understand that failure to comply shall result in legal action, which may include but not necessarily be limited to non-use of the building(s).


Applicant Signature Paulette Bourget Date 3-31-09  
 Planning Approval fat dungs Date 3/31/09

Additional water and/or sewer tap fee(s) are required:	YES	NO <input checked="" type="checkbox"/>	W/O No. <u>no water/sewer</u>
Utility Accounting <u>over</u>	Date <u>3/31/09</u>		

# 2277 Greenbriar Court



SCALE 1 : 377

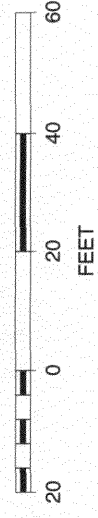

*ACCEPTED for [unclear]* 2/3/09  
ANY CHANGE OF SETBACKS MUST BE APPROVED BY THE CITY PLANNING DIVISION. IT IS THE APPLICANT'S RESPONSIBILITY TO PROPERLY LOCATE AND IDENTIFY FASEMENTS AND PROPERTY LINES.