

FEE \$	10
TCP \$	2,554
SIF \$	460

**PLANNING CLEARANCE**  
 (Single Family Residential and Accessory Structures)  
**Public Works & Planning Department**

BLDG PERMIT NO. \_\_\_\_\_

Building Address 353 Hancock St.  
 Parcel No. 2943-201-15-014  
 Subdivision Swan Meadows  
 Filing 1 Block 1 Lot 14

No. of Existing Bldgs — No. Proposed 1  
 Sq. Ft. of Existing Bldgs — Sq. Ft. Proposed 1614  
 Sq. Ft. of Lot / Parcel 3483  
 Sq. Ft. Coverage of Lot by Structures & Impervious Surface (Total Existing & Proposed) 2313 27%  
 Height of Proposed Structure 16 ft

**OWNER INFORMATION:**

Name Sonshine III Construction & Dev  
 Address 2350 G Rd  
 City / State / Zip Grand Junction, CO 81505

DESCRIPTION OF WORK & INTENDED USE:  
 New Single Family Home (\*check type below)  
 Interior Remodel  Addition  
 Other (please specify): \_\_\_\_\_

**PAID**

**APPLICANT INFORMATION:**

Name Sundance Property Leasing, Inc.  
 Address 2350 G Rd  
 City / State / Zip Grand Junction, CO 81505  
 Telephone 970 255 8853 646 4325

\*TYPE OF HOME PROPOSED:  
 Site Built  Manufactured Home (UBC)  
 Manufactured Home (HUD)  
 Other (please specify): \_\_\_\_\_

NOTES: \_\_\_\_\_

**REQUIRED: One plot plan, on 8 1/2" x 11" paper, showing all existing & proposed structure location(s), parking, setbacks to all property lines, ingress/egress to the property, driveway location & width & all easements & rights-of-way which abut the parcel.**

THIS SECTION TO BE COMPLETED BY PLANNING STAFF		
ZONE <u>R-4</u>	Maximum coverage of lot by structures <u>50%</u>	
SETBACKS: Front <u>20</u> from property line (PL)	Permanent Foundation Required: YES <input checked="" type="checkbox"/> NO <input type="checkbox"/>	
Side <u>7</u> from PL Rear <u>25</u> from PL	Floodplain Certificate Required: YES <input type="checkbox"/> NO <input checked="" type="checkbox"/>	
Maximum Height of Structure(s) <u>40'</u>	Parking Requirement <u>2</u>	
Voting District <u>E</u>	Driveway Location Approval <u>21</u> (Engineer's Initials)	Special Conditions _____

Modifications to this Planning Clearance must be approved, in writing, by the Public Works & Planning Department. The structure authorized by this application cannot be occupied until a final inspection has been completed and a Certificate of Occupancy has been issued, if applicable, by the Building Department.

I hereby acknowledge that I have read this application and the information is correct; I agree to comply with any and all codes, ordinances, laws, regulations or restrictions which apply to the project. I understand that failure to comply shall result in legal action, which may include but not necessarily be limited to non-use of the building(s).


Applicant Signature [Signature] Date 4/29/2010  
 Planning Approval [Signature] Date 4/29/10

Additional water and/or sewer tap fee(s) are required: YES <input checked="" type="checkbox"/> NO <input type="checkbox"/>	W/O No. <u>21667</u>
Utility Accounting <u>[Signature]</u>	Date <u>5/4/10</u>

VALID FOR SIX MONTHS FROM DATE OF ISSUANCE (Section 2.2.C.4 Grand Junction Zoning & Development Code)  
 (White: Planning) (Yellow: Customer) (Pink: Building Department) (Goldenrod: Utility Accounting)




353 Hancock St  
 Grand Junction, CO, 81504

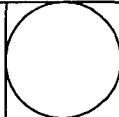

Project	ADT
Rev	3/26/10
Date	3/26/10
Scale	1" = 5'
Sheet	SITE PLAN
Drawn	C1

FILE NO.	BLOCK	LOT NUMBER	LOT SIZE	LIVING AREA	GARAGE	TOTAL AREA

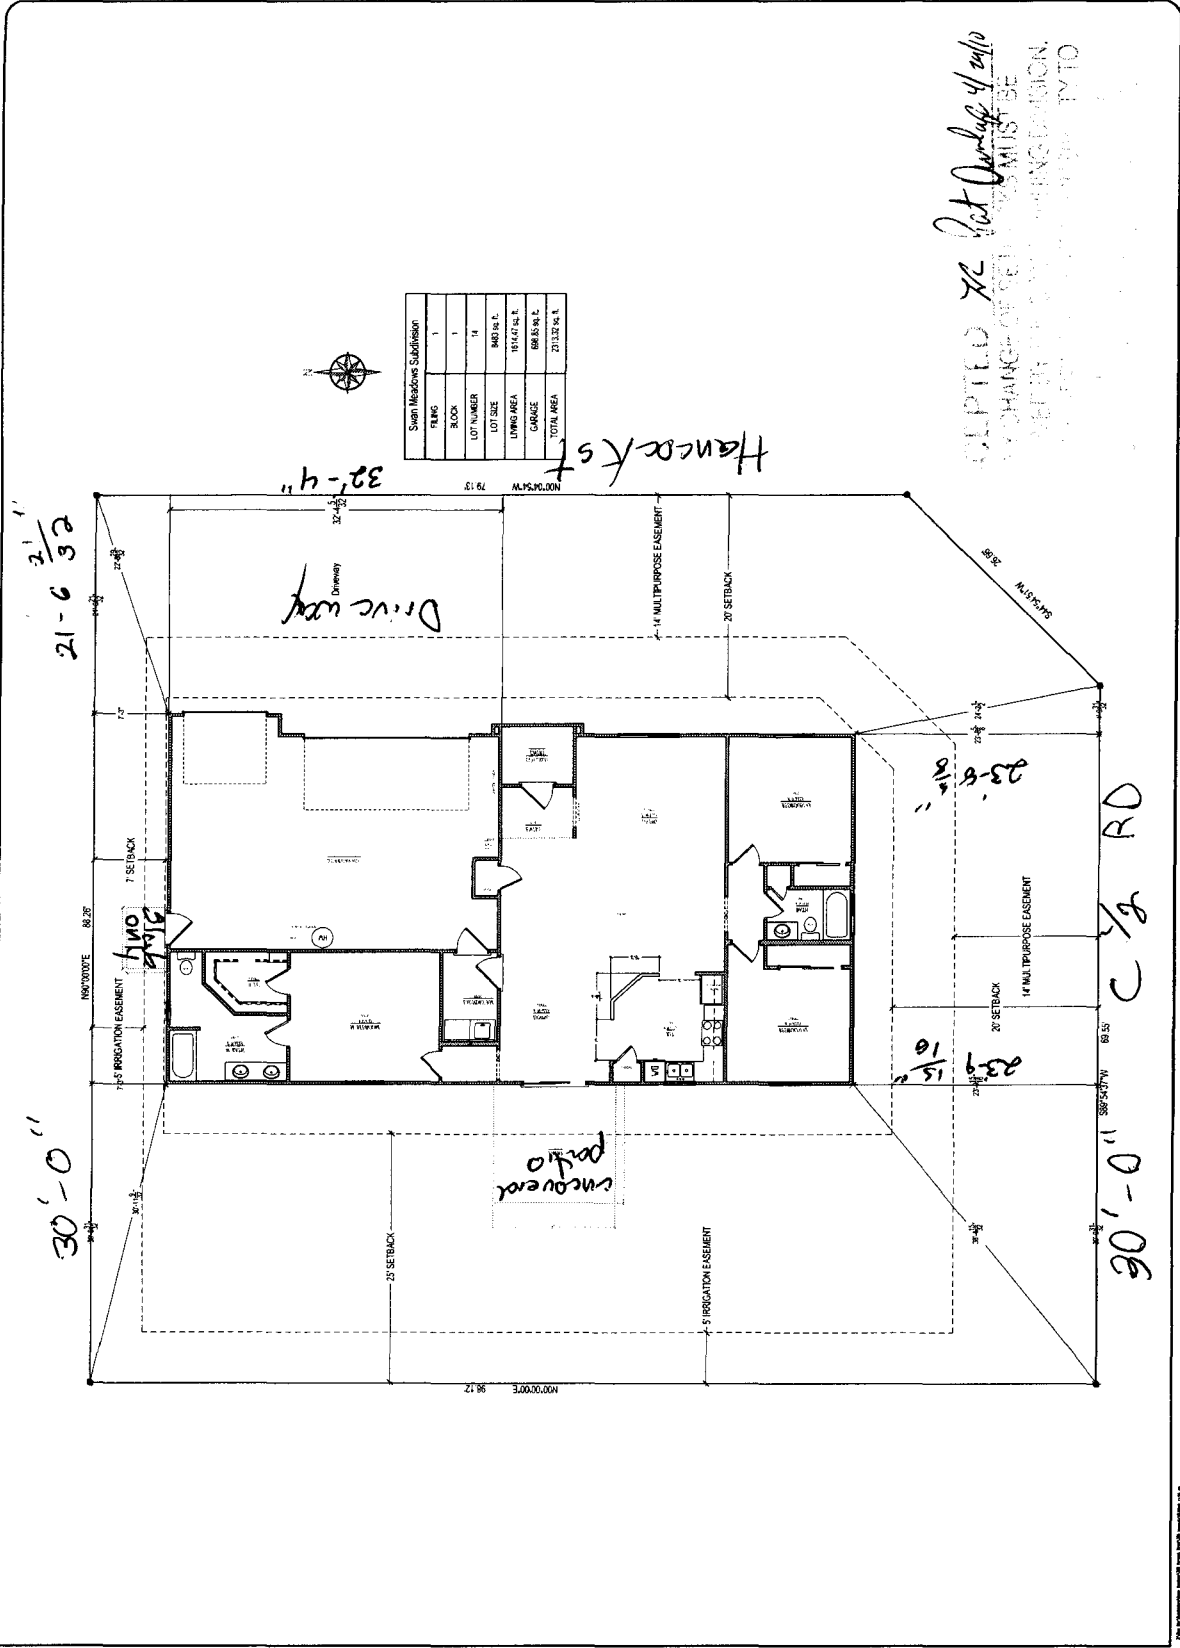

CLIPPED XL Per Overlay of info  
