FEE \$100
TCP\$ 2554
SIE & 4/00

(White: Planning)

(Yellow: Customer)

PLANNING CLEARANCE

BLDG PERMIT NO.


(Single Family Residential and Accessory Structures)

Public Works & Planning Department

Building Address 2994 Osprey Way	No. of Existing Bldgs No. Proposed
Parcel No. 2943-321-30-010	Sq. Ft. of Existing Bldgs Sq. Ft. Proposed 792 G
Subdivision HAWKS NEST	Sq. Ft. of Lot / Parcel
Filing Two Block 3 Lot 10	Sq. Ft. Coverage of Lot by Structures & Impervious Surface
OWNER INFORMATION:	(Total Existing & Proposed) 4650 Height of Proposed Structure 33'
Name 30 Road LLC	DESCRIPTION OF WORK & INTENDED USE:
Address 710 S 15 St	New Single Family Home (*check type below) Interior Remodel Addition
City / State / Zip GJ CO 8L5D/	Other (please specify):
APPLICANT INFORMATION:	*TYPE OF HOME PROPOSED:
Name STEADY CONST LLC	Site Built
Address 761 25 Rd	
City / State / Zip <u>G_J_CO_81505</u>	NOTES:
Telephone 250 9244	
REQUIRED: One plot plan, on 8 1/2" x 11" paper, showing all existing & proposed structure location(s), parking, setbacks to all property lines, ingress/egress to the property, driveway location & width & all easements & rights-of-way which abut the parcel.	






(Pink: Building Department)

(Goldenrod: Utility Accounting)

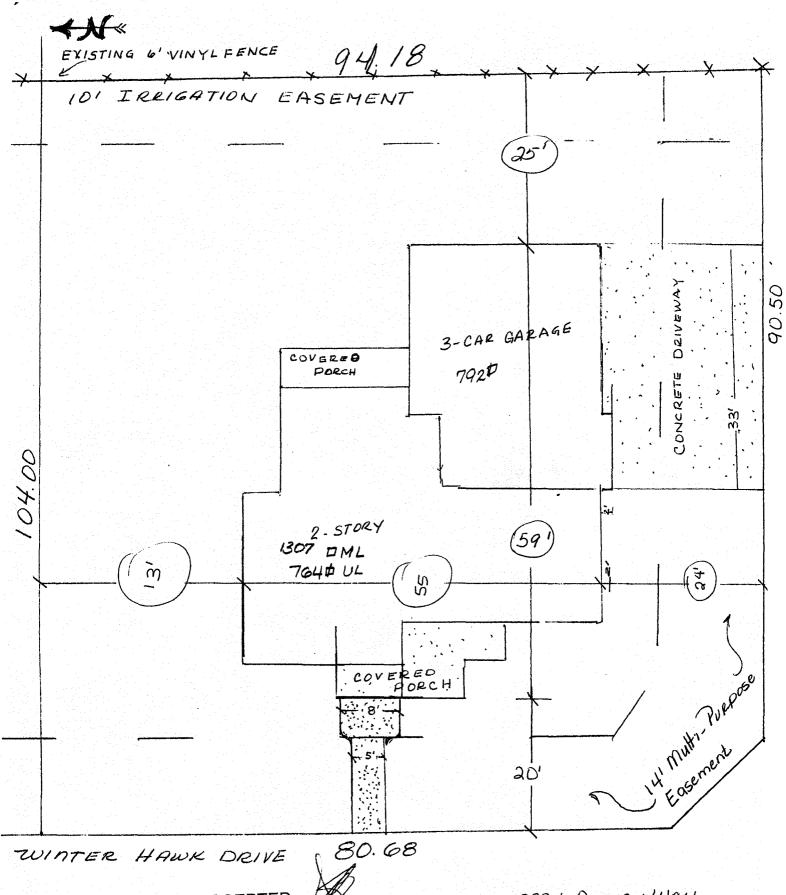

ACCEPTED

ANY CHANGE OF SETBACKS MUST BE

PROVED BY THE CITY PLANNING DIVISION
TIS THE APPLICANT'S RESPONSIBILITY TO

 2994 Osorey Way LOT 10 BIK3 Hawks Nest Fil 2943-321-30-010 9370\$

2,8 63# Total