

FEE \$	10
TCP \$	2,554
SIF \$	460

PLANNING CLEARANCE
 (Single Family Residential and Accessory Structures)
Public Works & Planning Department

BLDG PERMIT NO. _____

Building Address 173 WINTER HAWK DR
 Parcel No. 2943-321-32-004
 Subdivision HAWKS NEST
 Filing 2 Block 5 Lot 4

No. of Existing Bldgs 0 No. Proposed 1
 Sq. Ft. of Existing Bldgs 0 Sq. Ft. Proposed 1172 ML
1200 UL
832 GAR
 Sq. Ft. of Lot / Parcel 9129
 Sq. Ft. Coverage of Lot by Structures & Impervious Surface
 (Total Existing & Proposed) 3800 42%
 Height of Proposed Structure 33'

OWNER INFORMATION:

Name 30 Rd, LLC
 Address 710 S. 15th St
 City / State / Zip GJ, CO 81501

DESCRIPTION OF WORK & INTENDED USE:

New Single Family Home (*check type below)
 Interior Remodel Addition
 Other (please specify): _____

APPLICANT INFORMATION:

Name Steady CONST LLC
 Address 761 25 Rd
 City / State / Zip GJ, CO 81501
 Telephone 250-7244

***TYPE OF HOME PROPOSED:**

Site Built Manufactured Home (UBC)
 Manufactured Home (HUD)
 Other (please specify): _____

PAID

NOTES: _____

REQUIRED: One plot plan, on 8 1/2" x 11" paper, showing all existing & proposed structure location(s), parking, setbacks to all property lines, ingress/egress to the property, driveway location & width & all easements & rights-of-way which abut the parcel.

THIS SECTION TO BE COMPLETED BY PLANNING STAFF

ZONE R-4 Maximum coverage of lot by structures 50%
 SETBACKS: Front 20 from property line (PL) Permanent Foundation Required: YES NO _____
 Side 7 from PL Rear 25 from PL Floodplain Certificate Required: YES _____ NO
 Maximum Height of Structure(s) 40 ft Parking Requirement 2
 Voting District E Driveway Location Approval td Special Conditions _____
 (Engineer's Initials)

Modifications to this Planning Clearance must be approved, in writing, by the Public Works & Planning Department. The structure authorized by this application cannot be occupied until a final inspection has been completed and a Certificate of Occupancy has been issued, if applicable, by the Building Department.

I hereby acknowledge that I have read this application and the information I have provided is correct; I agree to comply with any and all codes, ordinances, laws, regulations or restrictions which apply to the project. I understand that failure to comply shall result in legal action, which may include but not necessarily be limited to non-use of the building(s).

Applicant Signature [Signature] Date 3-29-10

Planning Approval [Signature] Date 4-22-10

Additional water and/or sewer tap fee(s) are required: YES NO _____ W/O No. PD AMSD

Utility Accounting [Signature] Date 4/29/10

VALID FOR SIX MONTHS FROM DATE OF ISSUANCE (Section 2.2.C.4 Grand Junction Zoning & Development Code)
 (White: Planning) (Yellow: Customer) (Pink: Building Department) (Goldenrod: Utility Accounting)





87.80'

10' IRRIGATION EASEMENT

IRRIGATION
● RISER

46'

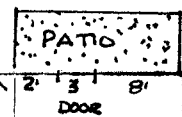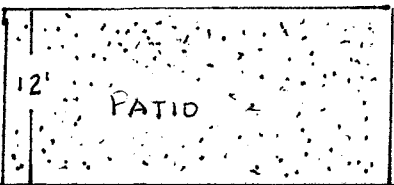


68'

12.80'

103.9'

103.97'

36'

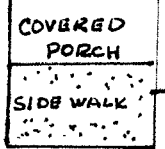

33'

*Driveway OK
Duffen Seal*

22'

WATER
TAP ●

14' Multi-Purpose Easement

87.80'

STREET
LITE

WINTER HAWK DRIVE

APPROVED BY *Barbara Henderson*
4-22-10

173 WINTER HAWK DRIVE
LOT 4 BLK 5 HAWKS NEST
9129 # FILING TWL