


Amended Plat and Dedication Henderson Heights

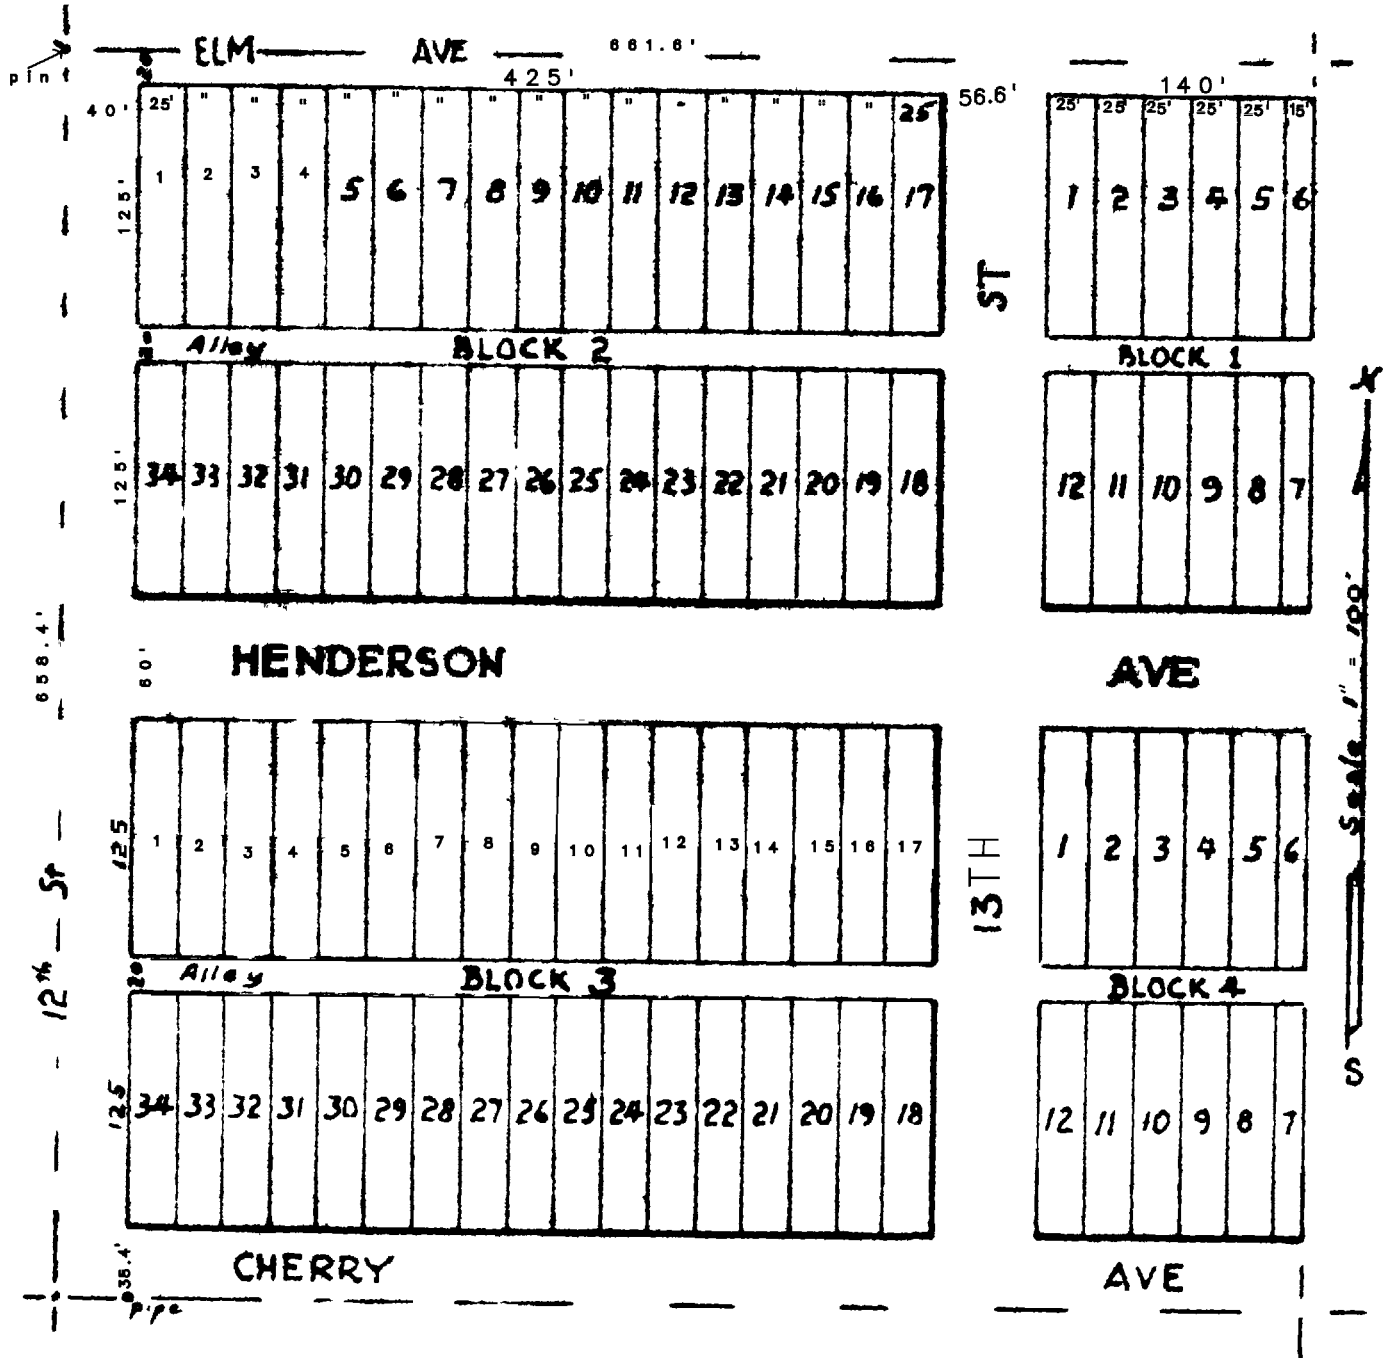

AMENDED PLAT and DEDICATION of HENDERSON HEIGHTS



Hessie Roberts of Grand Junction, Colorado, being the owner of the South half of Block 1 and all of Blocks 2, 3 and 4; and Ralph Baker and Thelma Baker of Grand Junction Colorado, being the owners of the North half of Block 1 of Henderson Heights as platted and recorded in Plat book 4 page 2 of the records of the County of Mesa, Colorado, now join in an AMENDED PLAT of HENDERSON HEIGHTS; and the said Hessie Roberts, Ralph Baker and Thelma Baker hereby dedicate to the public forever all streets, avenues, and alleys as shown on the accompanying amended plat.
 Dated at Grand Junction, Colorado, June 2nd 1936.

Hessie Roberts, Ralph Baker, Thelma Baker
 STATE OF COLORADO } (seal) (seal) (seal)

County of Mesa } ss. I, Orlo D. Williams, a notary public in and for said County and State, do hereby certify that Hessie Roberts, Ralph Baker and Thelma Baker who are known to me to be the same persons whose names are subscribed to the foregoing amended plat and dedication, signed, sealed and delivered said amended plat and dedication as their free and voluntary act and deed. Given under my hand and Notarial seal this 2nd day of June AD 1936. My commission expires January 20th 1940

Orlo D. Williams
 Notary Public.

State of Colorado June 30 1936
 County of Mesa
 I hereby certify that this instrument was filed for record July 9th 1936
 E. J. [unclear] M. and Recorder
 in Book [unclear] of [unclear]
 E. J. [unclear] Recorder Deputy

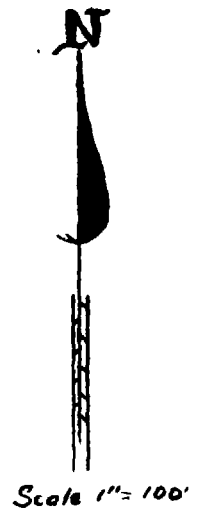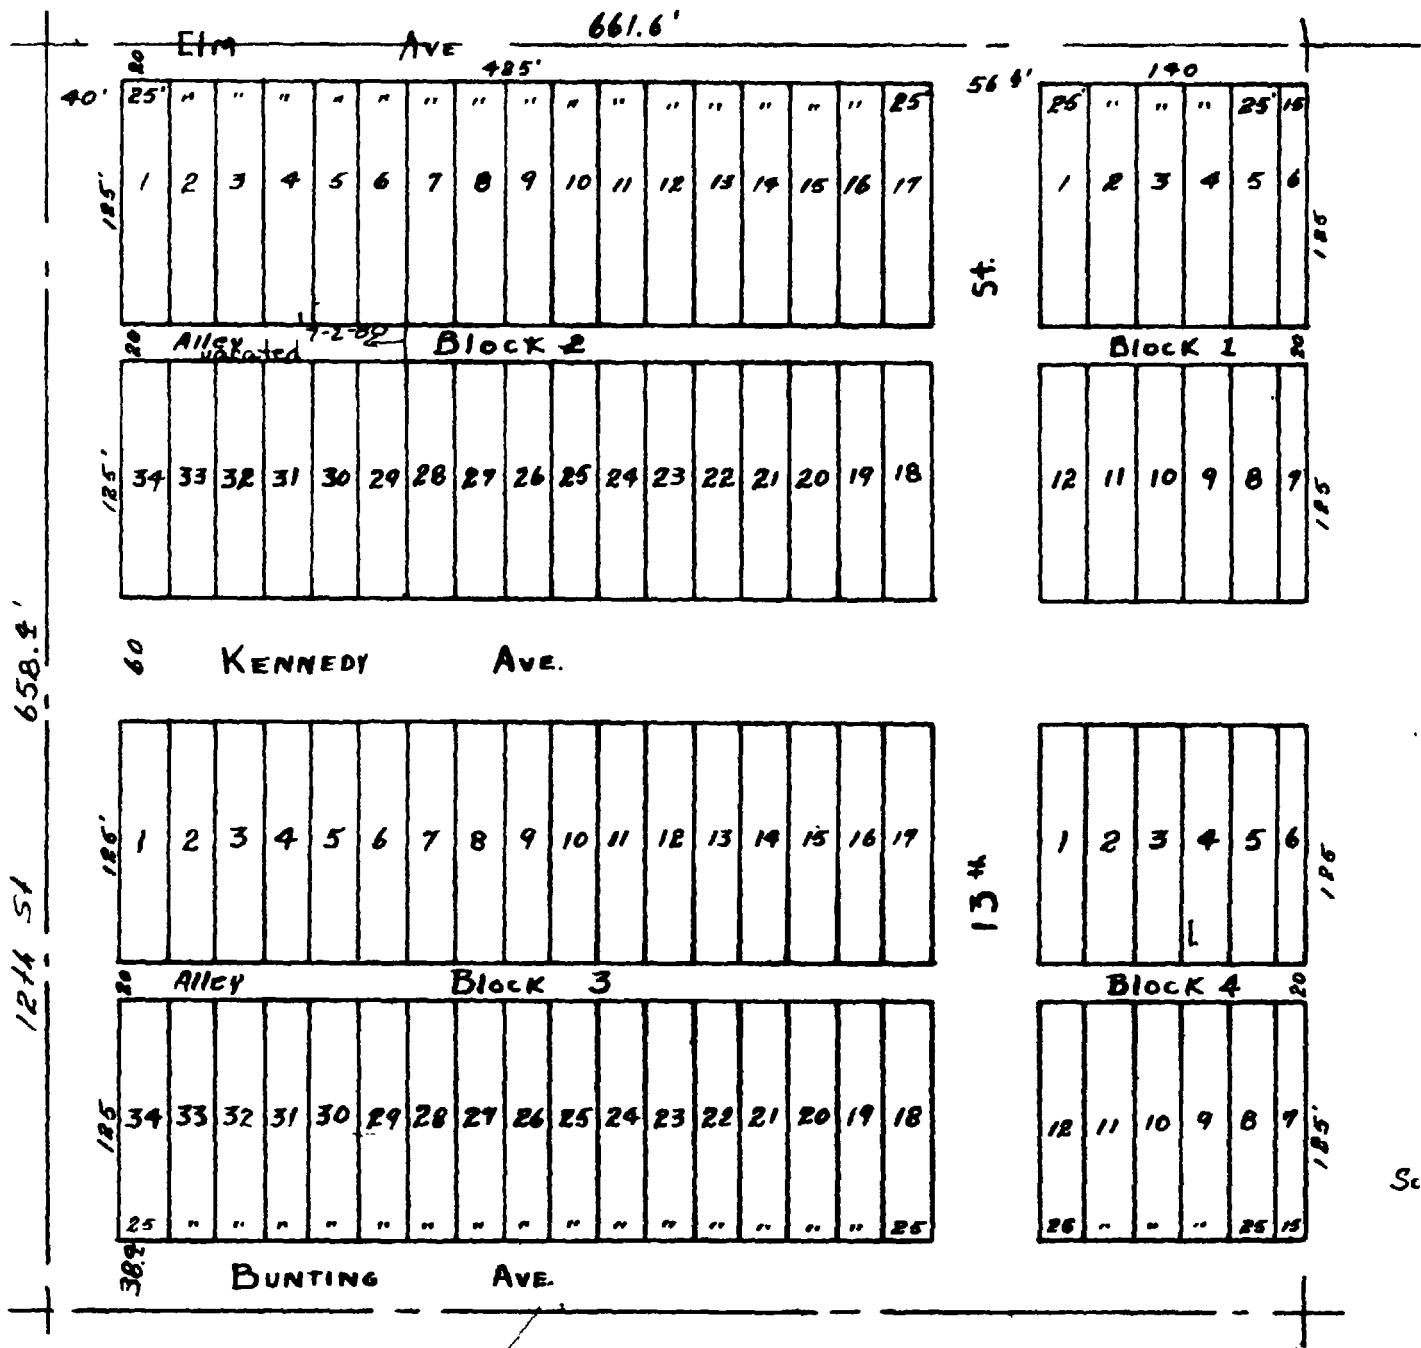

HENDERSON HEIGHTS