

*4' Dedicated for ROW
10' for Alstall*

KNOW ALL MEN BY THESE PRESENTS That E F Lewis and Ruby Lewis, being the owners of the W $\frac{1}{4}$ SW $\frac{1}{4}$ NE $\frac{1}{4}$ section 12 T 1 S R 1 W Ute Meridian, have caused to be made SUNGOLD PARK SUBDIVISION of said land, and they do hereby dedicate the streets, avenues and alleys as shown hereon to the use of the public forever

E. F. Lewis

Ruby Lewis

STATE OF COLORADO) SS
County of Mesa)

The forgoing instrument was acknowledged before me by E F Lewis and Ruby Lewis on the 12th day of July, 1950
My commission expires June 19-1952

Richard B. Williams

Notary Public


I hereby certify that this is a true and correct plat of survey of the above described land and the subdivision thereof

Ray S. George

County Surveyor

**SUNGOLD PARK
SUBDIVISION**

W $\frac{1}{4}$ SW $\frac{1}{4}$ NE $\frac{1}{4}$ Sec 12
T 1 S R 1 W Ute M
MESA COUNTY COLORADO

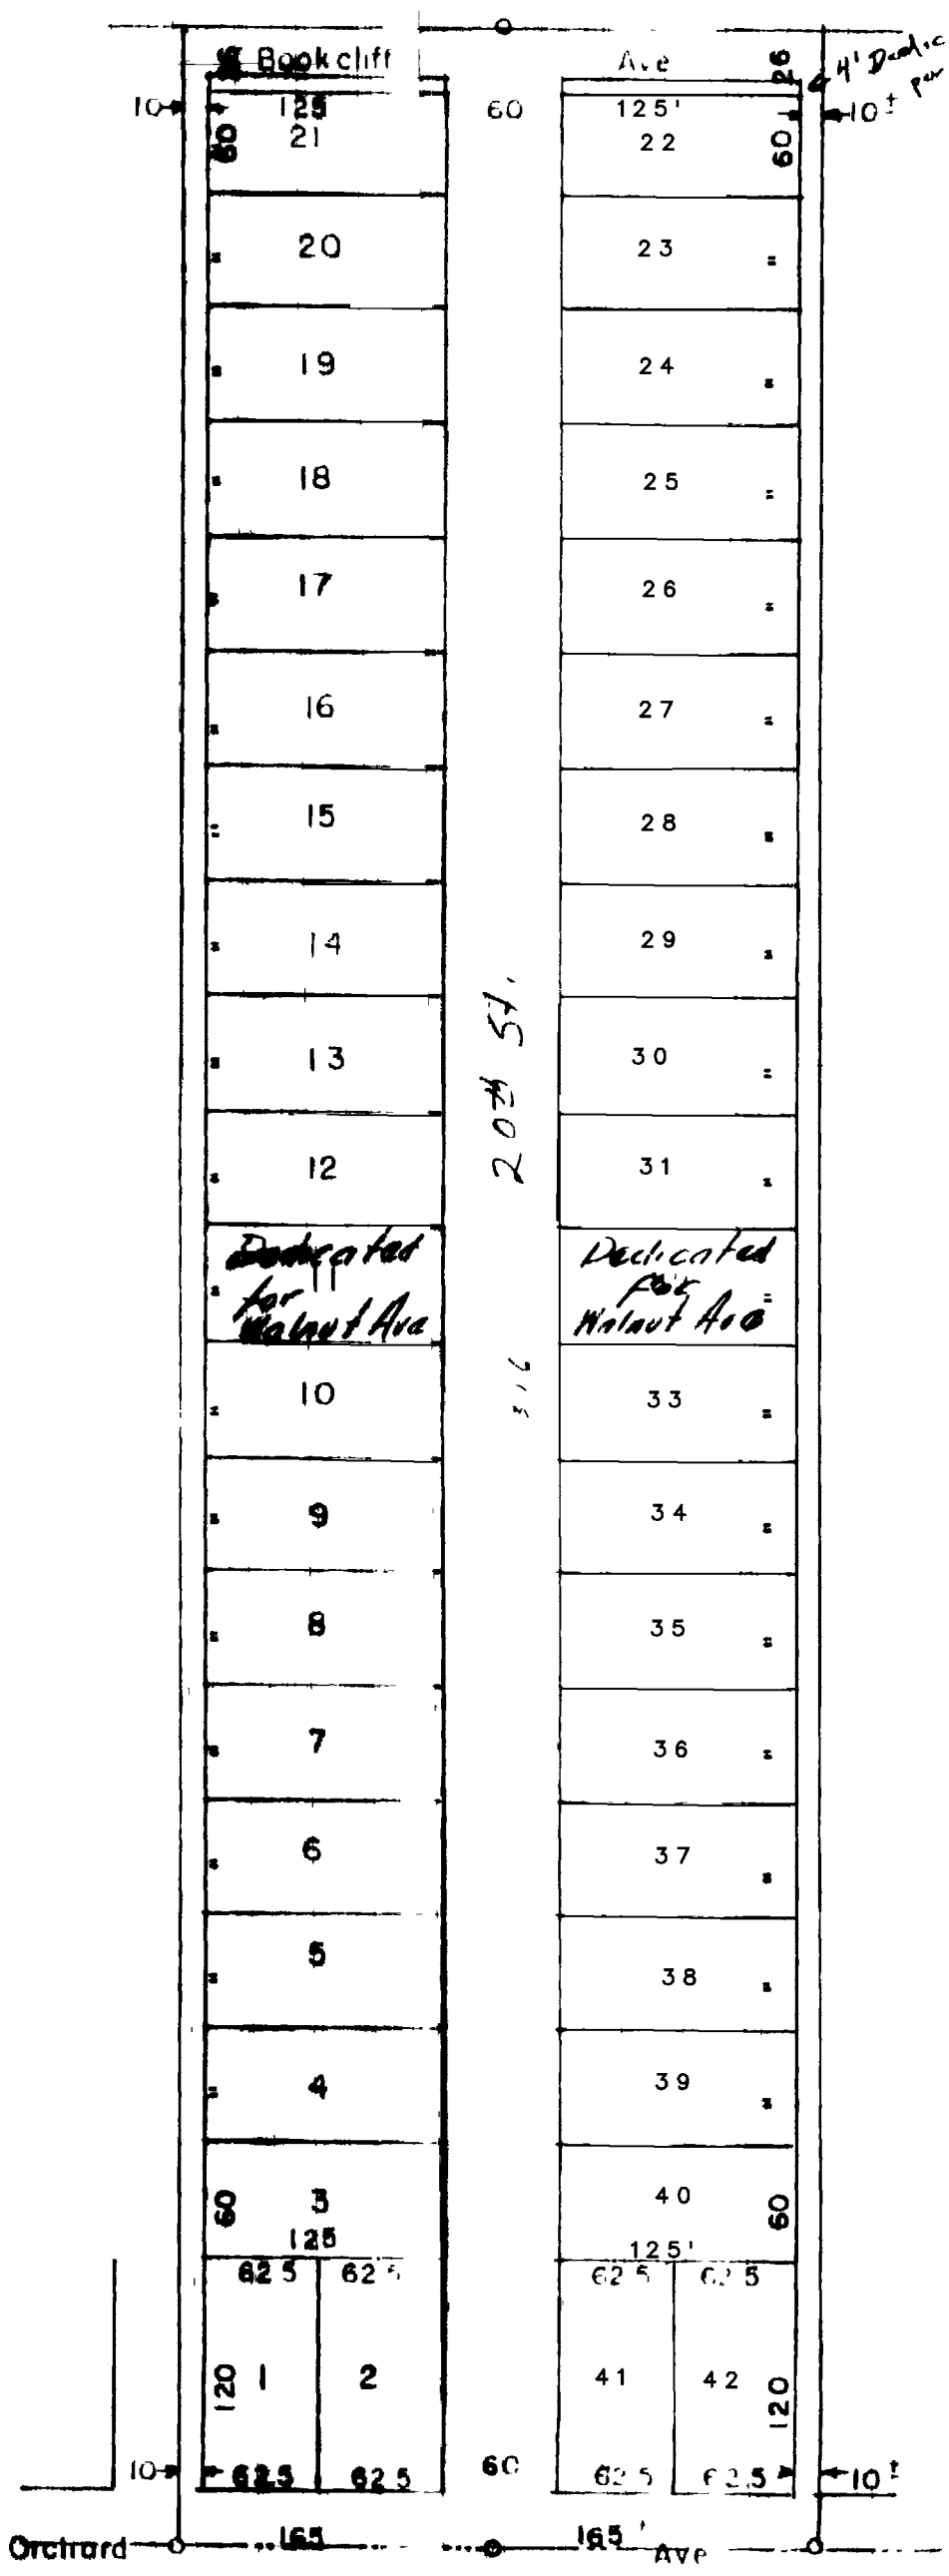

SW cor SW $\frac{1}{4}$ NE $\frac{1}{4}$ sec 12
T 1 S R 1 W Ute M

