





PETITION AND APPLICATION FOR REZONING

STATE OF COLORADO)

)ss.

COUNTY OF M E S A)

We the undersigned being the owners of the following described property, to-wit:

Beginning 25 feet East of the Southwest Corner of the Northwest Quarter of the Southeast Quarter of the Southeast Quarter of Section Seven (7), Township One (1) South, Range One (1) East of the Ute Meridian, thence North 160 feet, thence South 89°40' East 262 feet, thence South 160 feet, thence North 89°40' West 262 feet to the point of beginning; in the City of Grand Junction, Mesa County, Colorado.

containing .9 acres more or less, do respectfully petition and request that the zoning ordinance of the above described land be changed from R-3 to C-1.

Respectfully submitted

G. Robert Guyton  
G. Robert Guyton

Maebeth Guyton  
Maebeth Guyton



The foregoing instrument was acknowledged before me this 29<sup>th</sup> day of October, 1976, by G. Robert Guyton and Maebeth Guyton.

My commission expires: 9-18-79





Jeanne Procopio  
Notary Public

Chief Drive-in  
Zone R-1-C

C-1

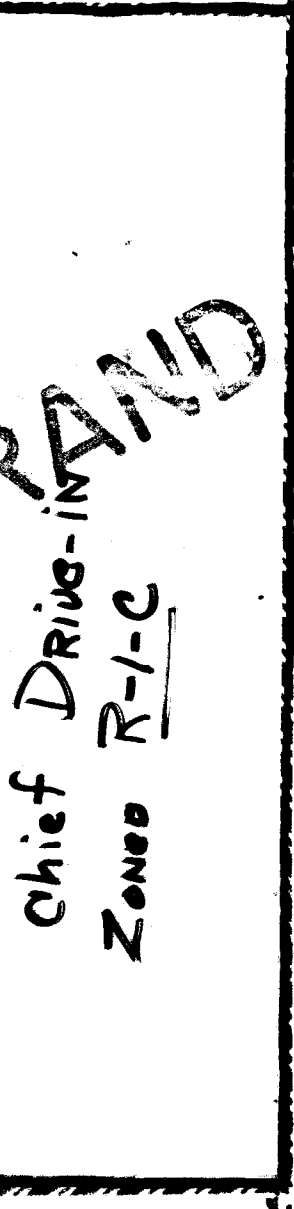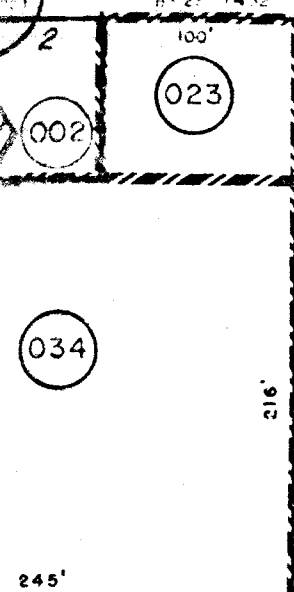

28 3/4 ROAD 50' Desc. 780-165

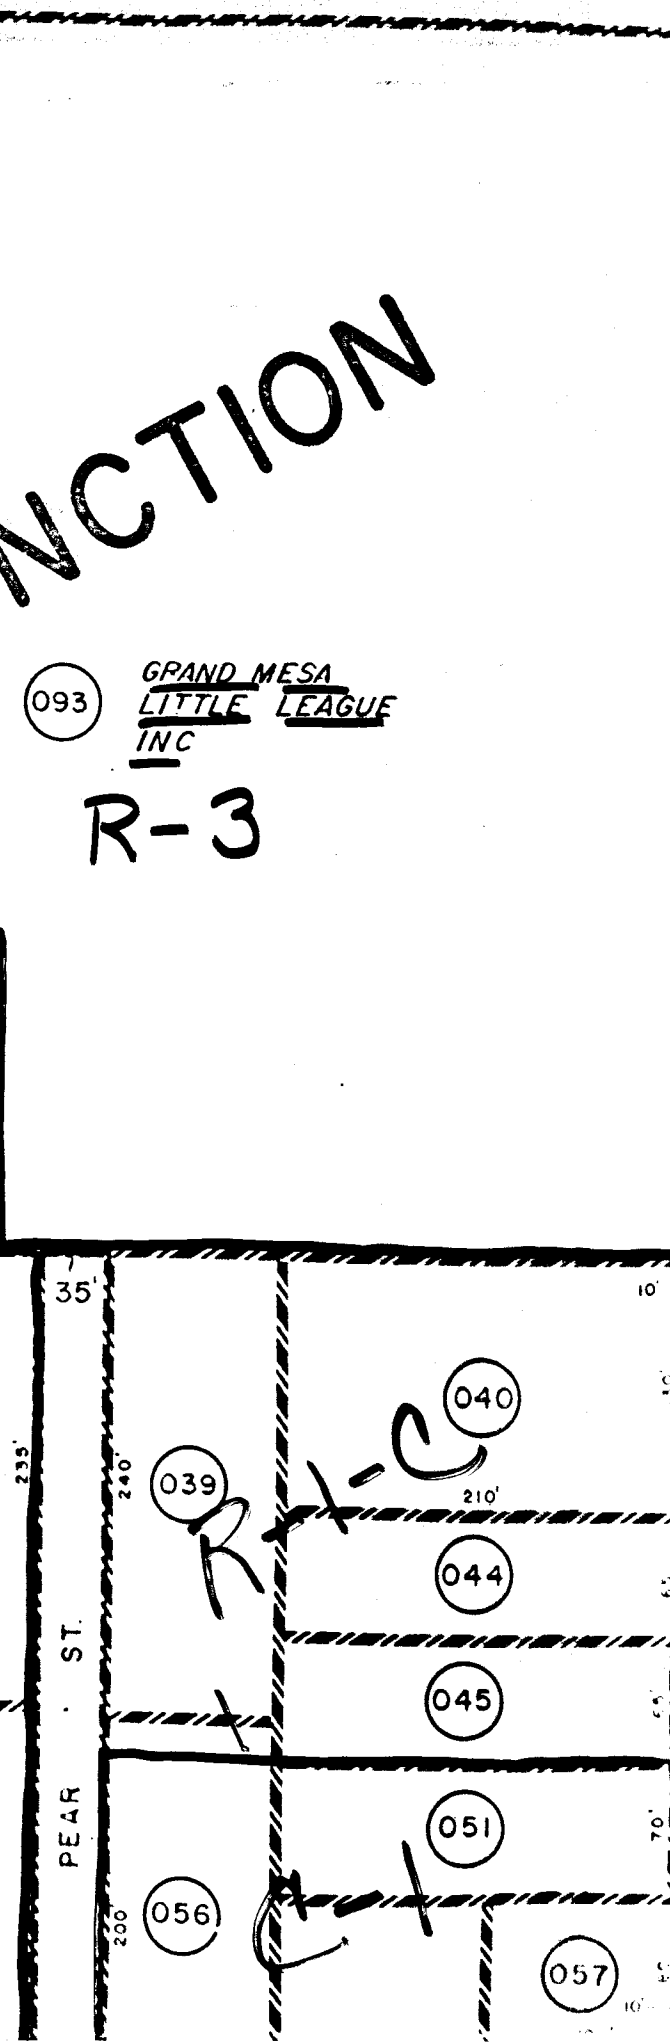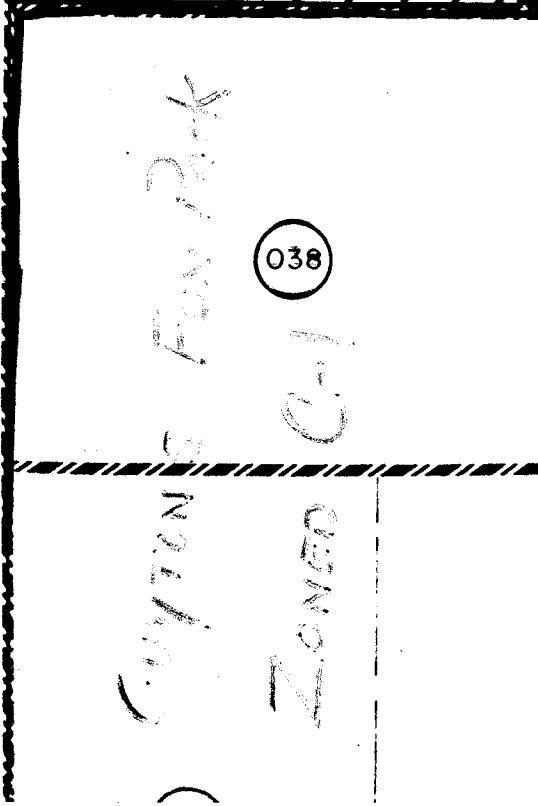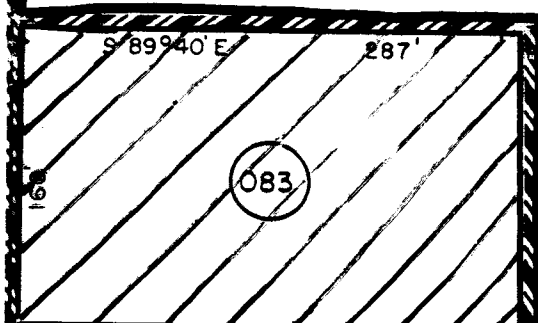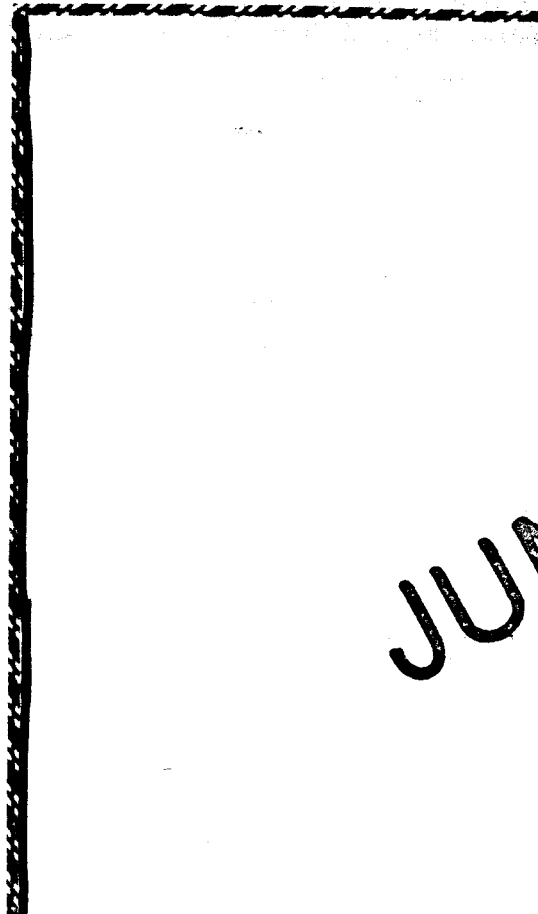

JUNCTION

093 GRAND MESA LITTLE LEAGUE INC R-3

PEAR ST.