

REVIEW SHEET SUMMARY

FILE # #5-80

DATE SENT TO REVIEW AGENCIES

ITEM EASEMENT VACATION

DATE DUE

PC MEETING DATE


HCC/CC MEETING DATE

2225 Dogwood Court

<u>DATE REC.</u>	<u>AGENCY</u>	<u>COMMENTS</u>
1-18-80	PUBLIC SERVICE	No objections
1-18-80	CITY UTILITIES	No objections
1-18-80	CITY ENGINEER	No comments
1-18-80	GRAND JUNCTION FIRE	No objections
1-21-80	TRANSPORTATION	No comments.
1-21-80	DESIGN & DEVELOP. PLANNER	No objection.
1-23-80	MOUNTAIN BELL	No objection

STAFF RECOMMENDATION: Recommend approval of easement vacation as there is no objection from staff.

GJPC/1-29-80/FLAGLER/GRAHAM PASSED 6-0 A MOTION TO RECOMMEND APPROVAL TO THE CITY COUNCIL OF THE VACATION OF THE EASEMENT AS REQUESTED

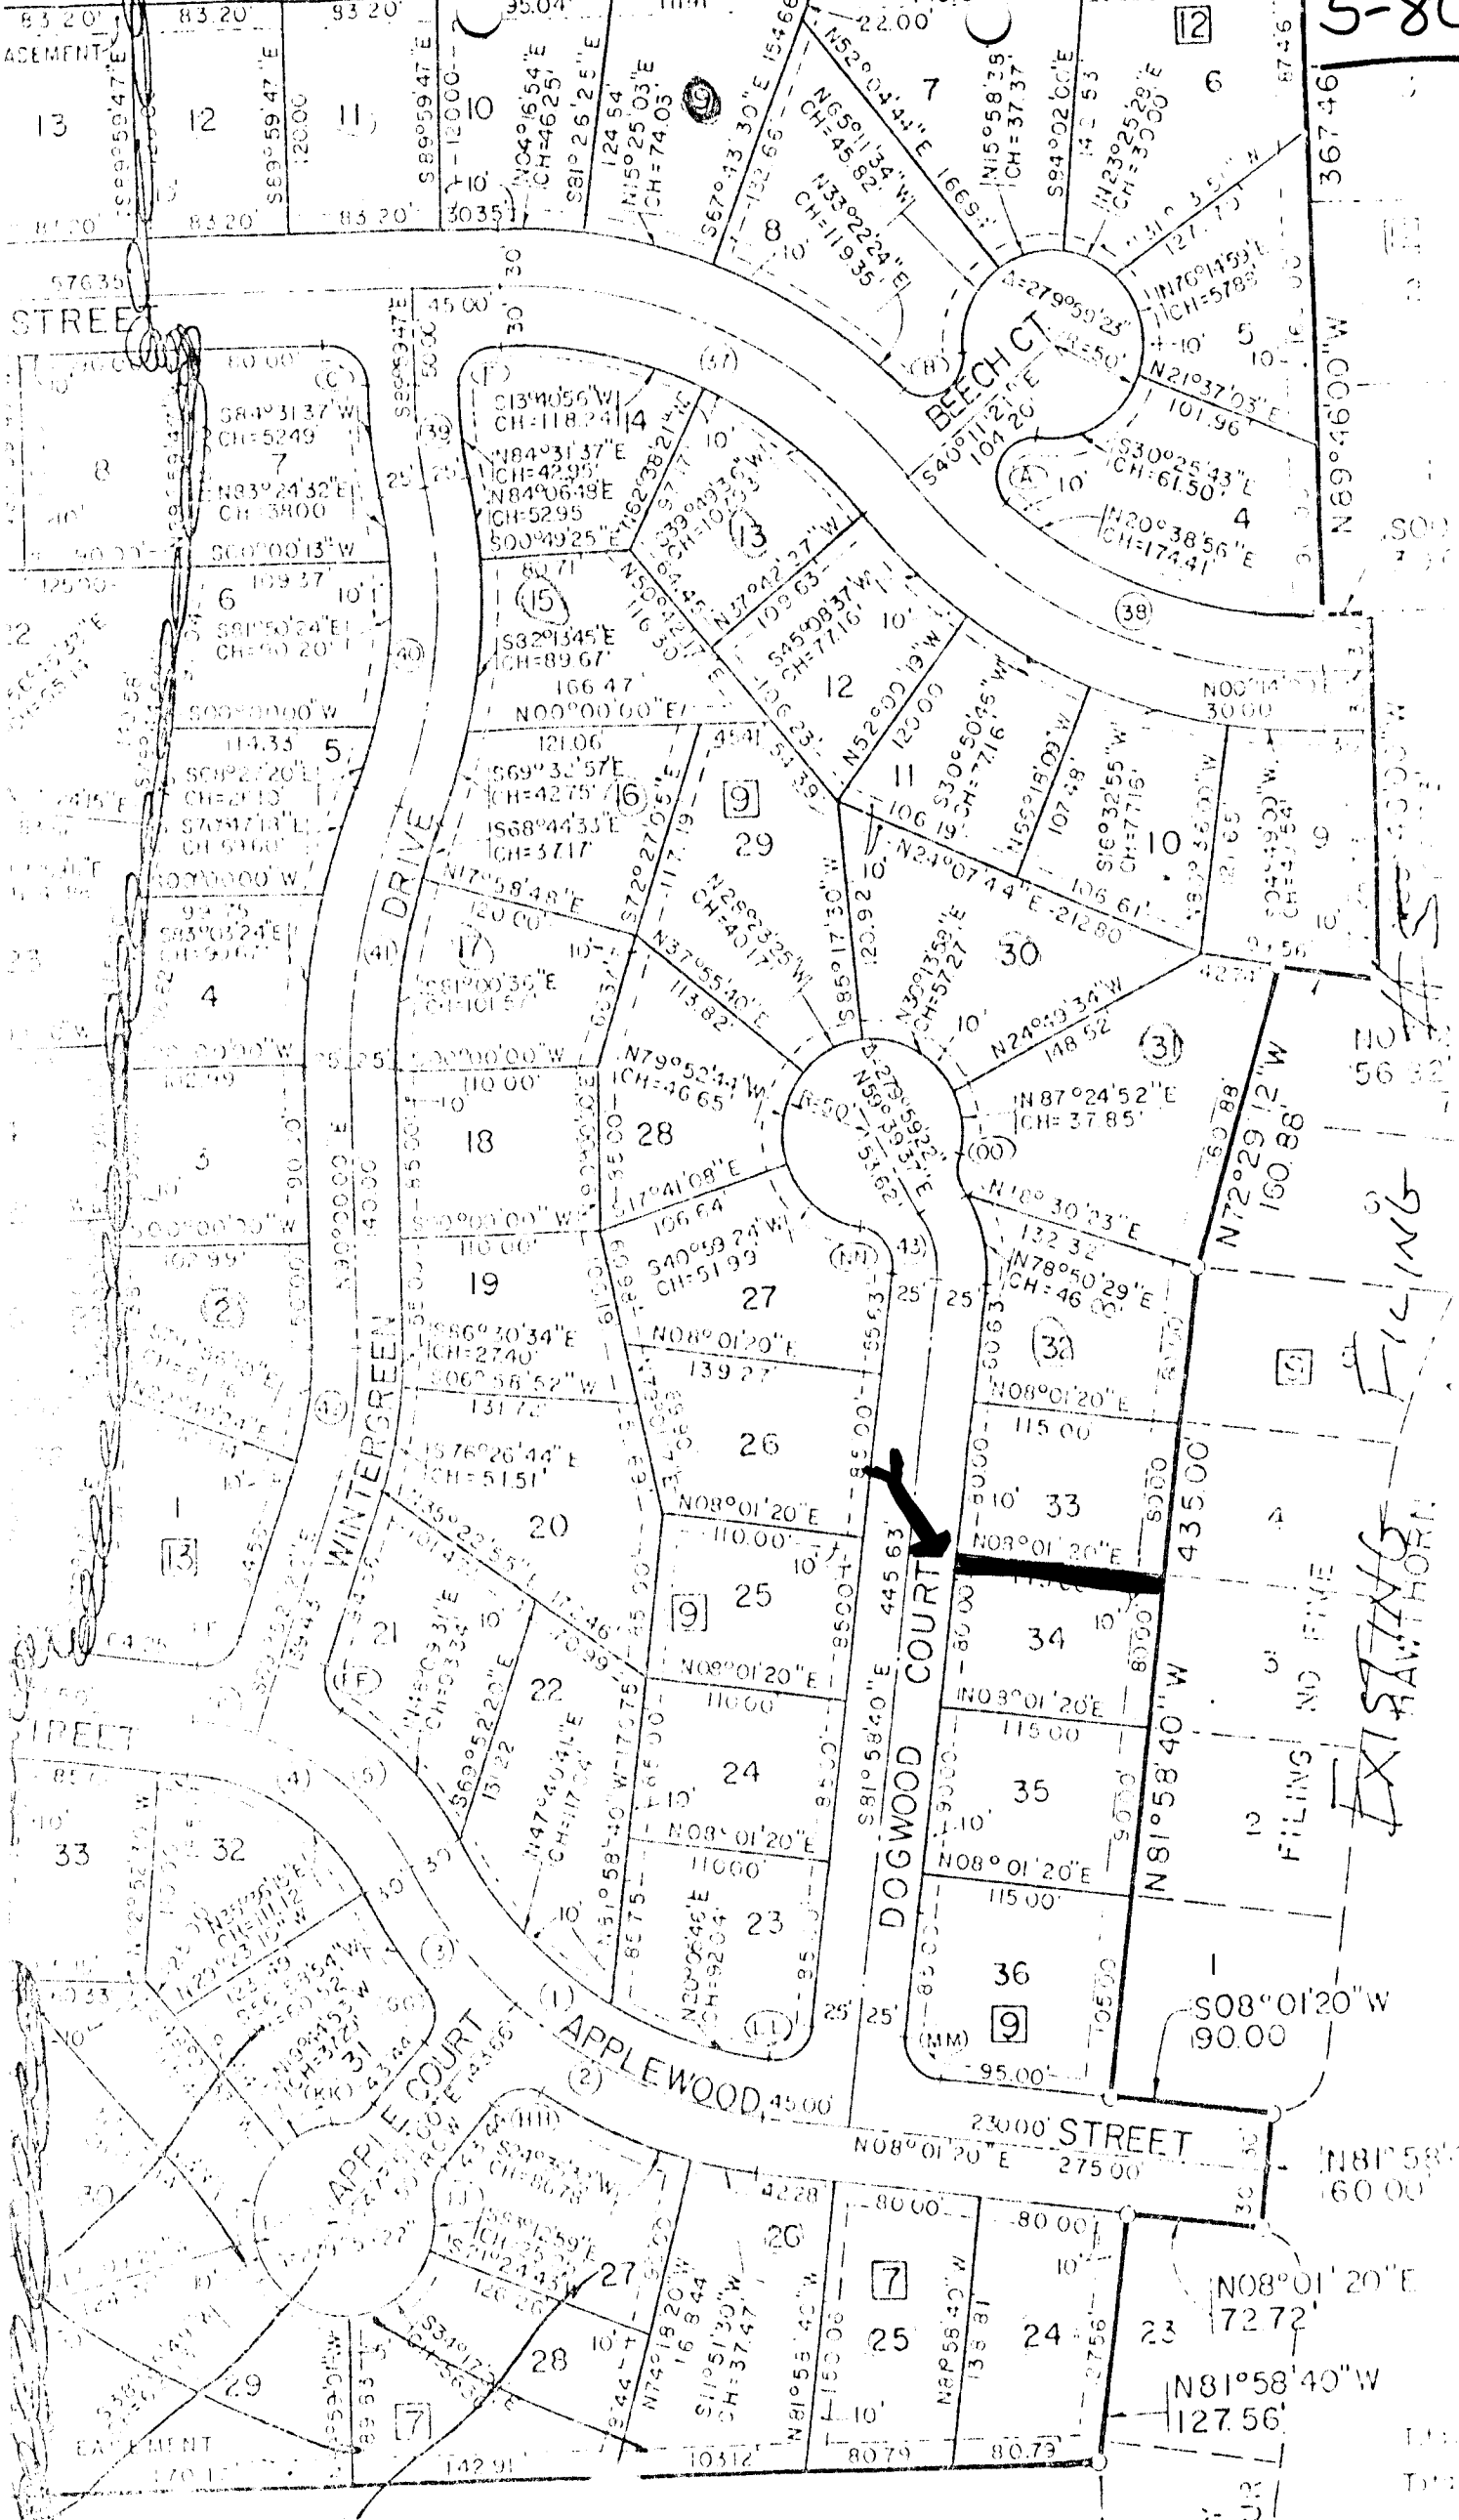

EX 187746
FILING NO FIVE











