

FUTURE 39' DRIVE TO REM

25' DRIVE

PARKING


PARKING

FUTURE EXPANSION

FUTURE EXPANSION

CHUCK WAGON AREA - 200 SEATS AFTER 7:00 PM PHASE I

SERVICE ROAD

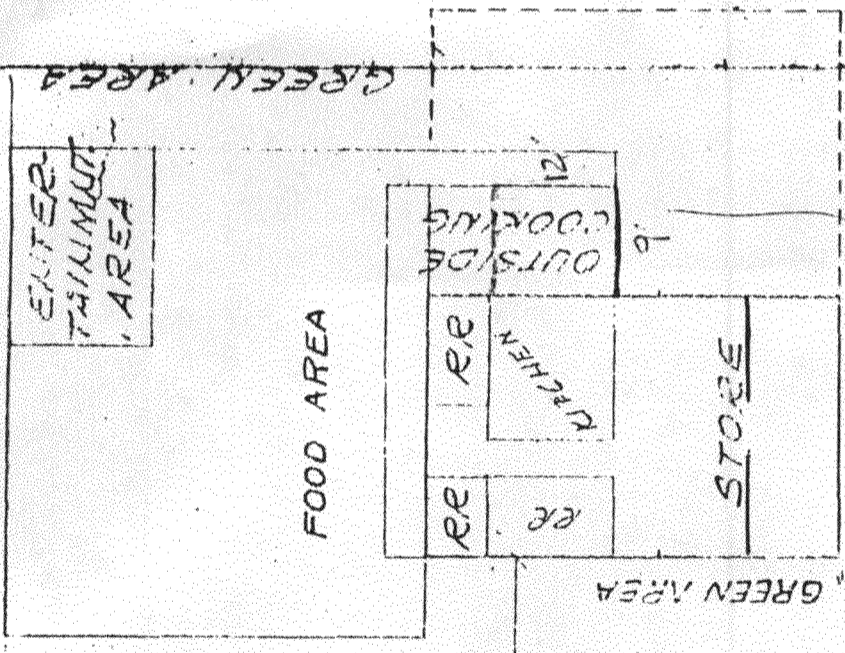

Building within GREEN AREA




ACCEPTED *Jan Dixon* 7-25-94

ANY CHANGE OF SETBACKS MUST BE APPROVED BY THE CITY PLANNING DEPT. IT IS THE APPLICANT'S RESPONSIBILITY TO PROPERLY LOCATE AND IDENTIFY EASEMENTS AND PROPERTY LINES.

I-70

746-231240
2701-334-00-03
#109-94
59-93
who Amusement
file 9022 Tompkins Burger. 243 6067
Road improvements for 40k paid
price to C.O.

ACCEPTED
ANY CHANGE OF SETBACKS MUST BE
APPROVED BY THE CITY PLANNING
DEPT. IT IS THE APPLICANT'S
RESPONSIBILITY TO PROPERLY
LOCATE AND IDENTIFY EASEMENTS
AND PROPERTY LINES.

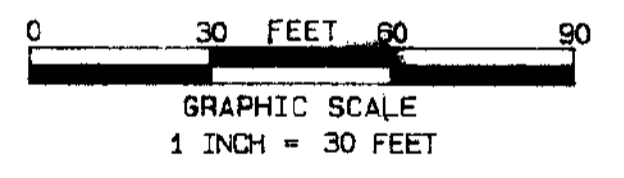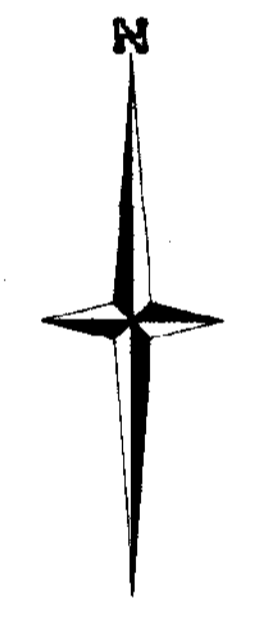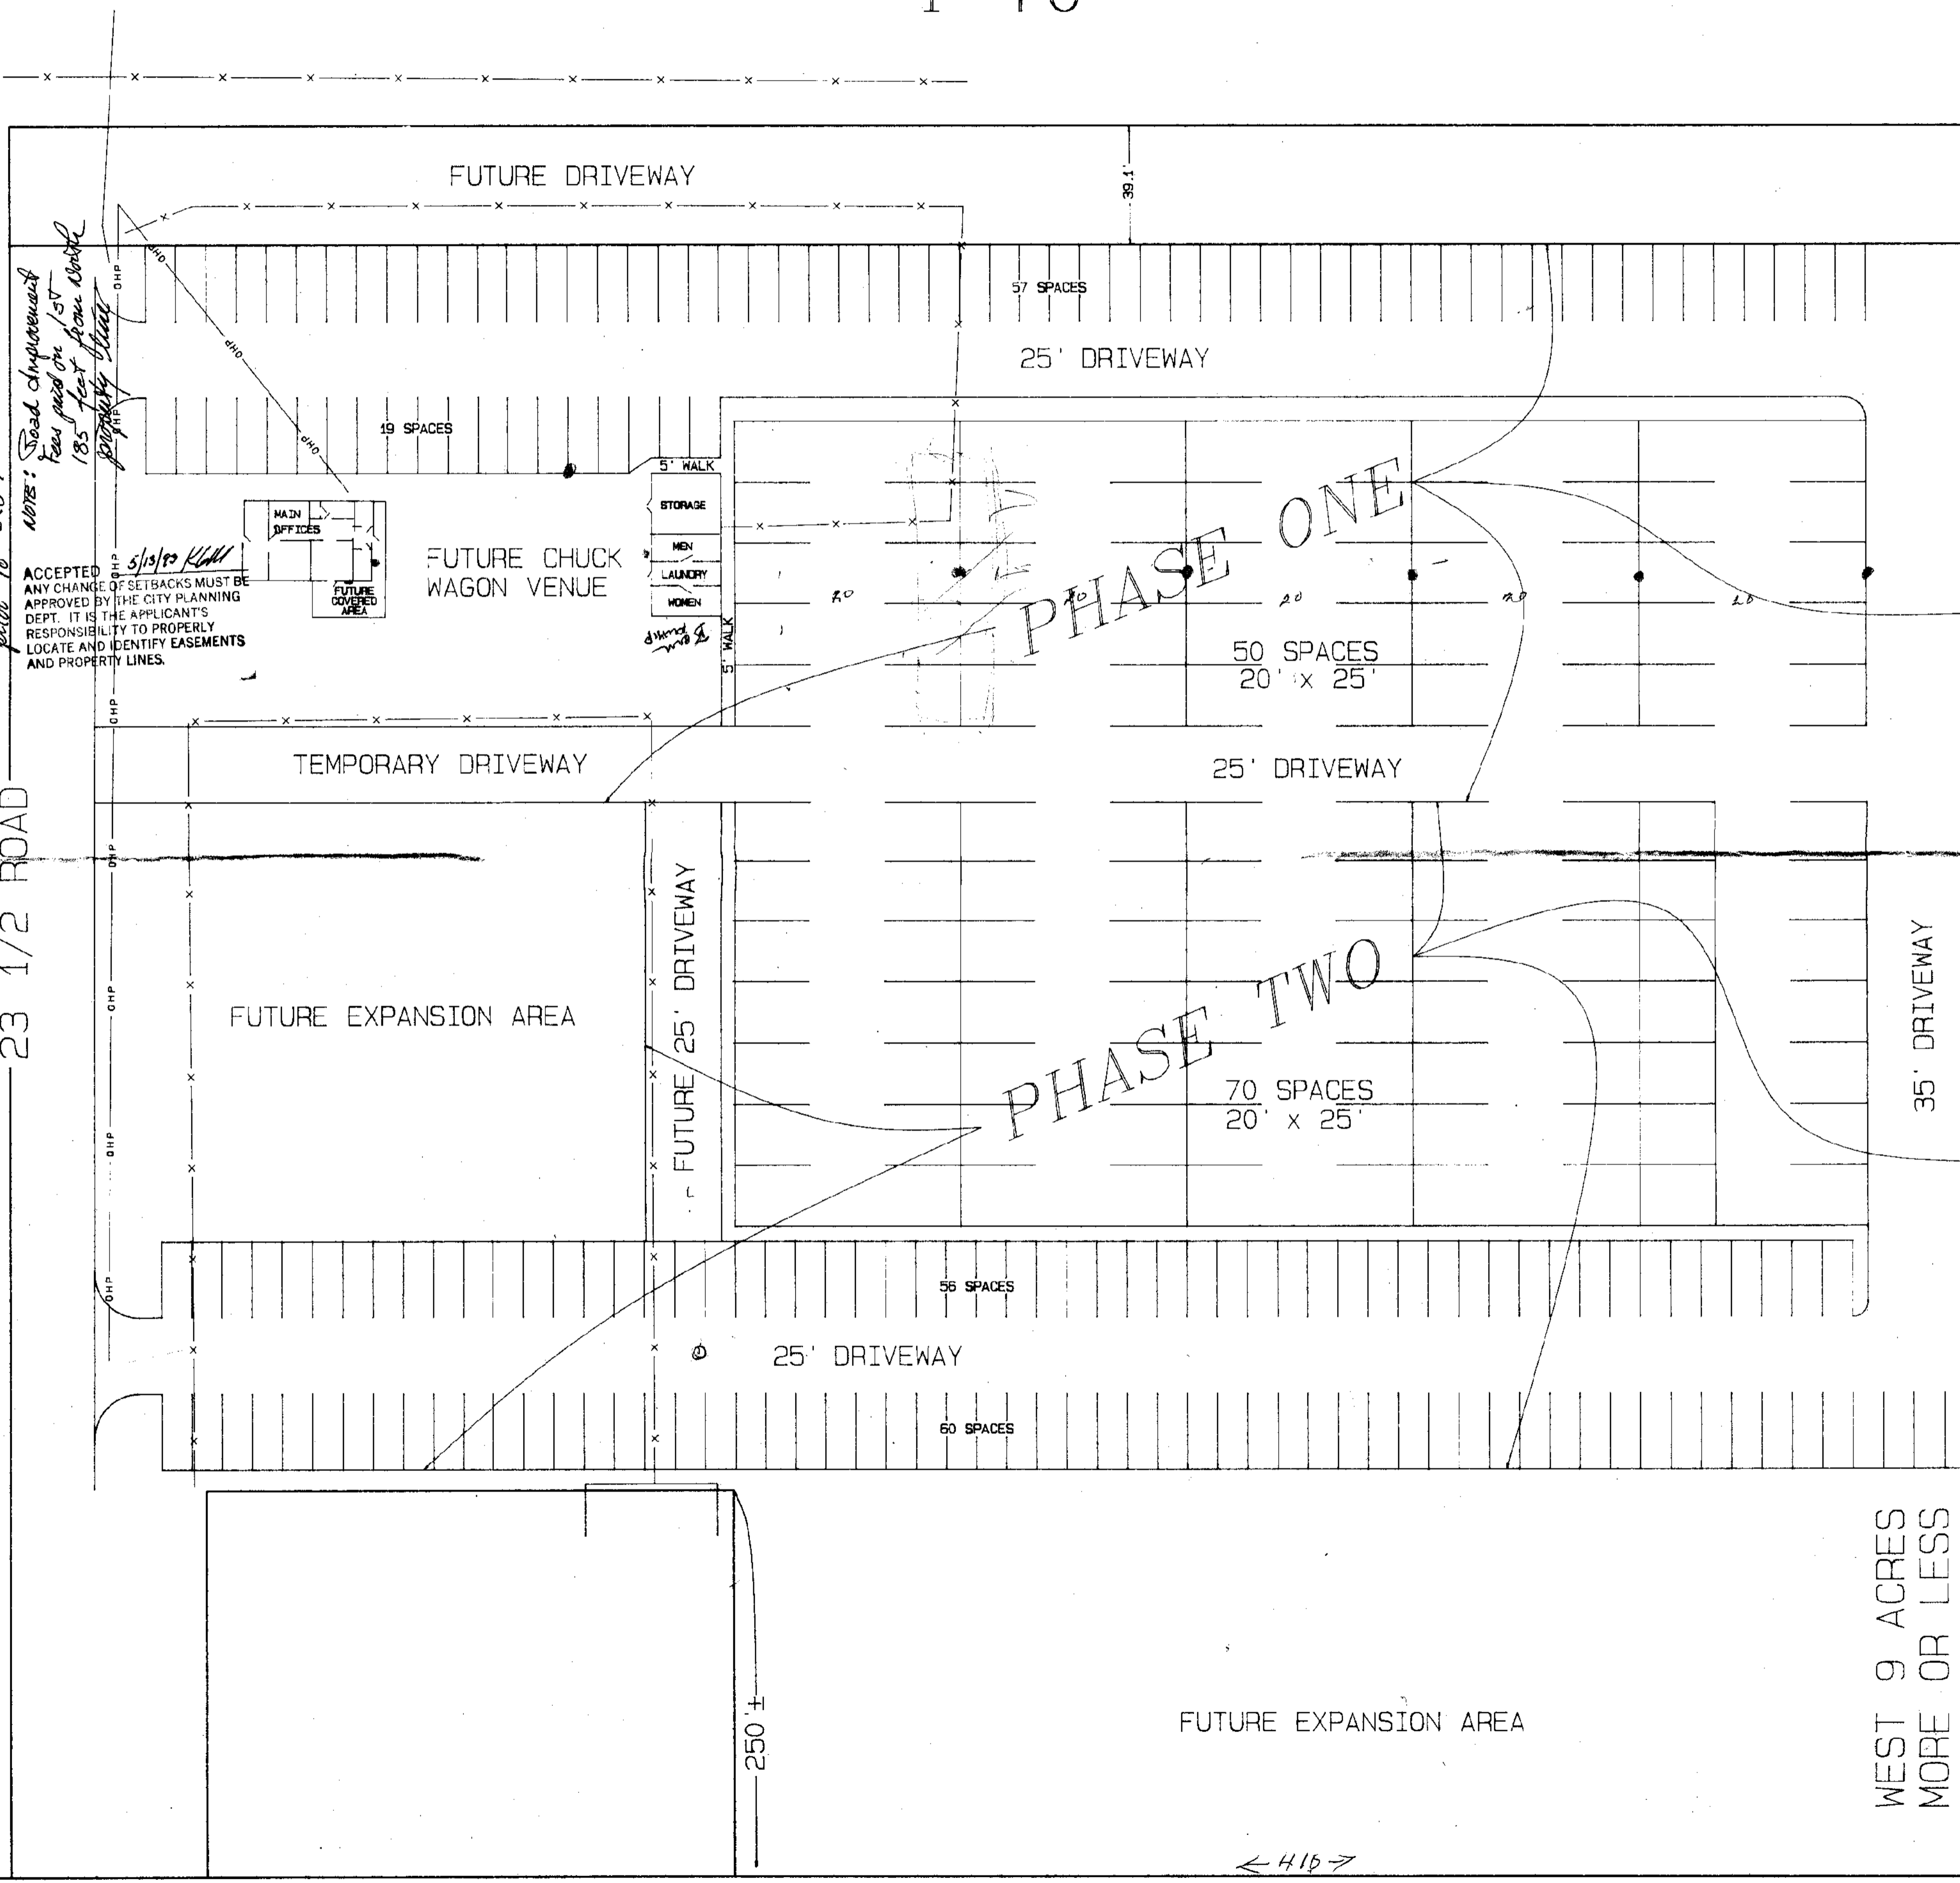

Steven
P. [unclear]

WEST 9 ACRES
MORE OR LESS

EAST 10 ACRES - MORE OR LESS

FUTURE EXPANSION AREA

← 415 →