

SUBMITTAL CHECKLIST

SITE PLAN REVIEW

Location: 2518/2520 Bluchman

Project Name: Unified Technical Center

ITEMS	DISTRIBUTION																			TOTAL REQ'D.										
DESCRIPTION	SSID REFERENCE	● City Community Development	● City Dev. Eng.	● City Utility Eng.	○ City Property Agent	○ City Parks/Recreation	● City Fire Department	● City Attorney	○ City Downtown Dev. Auth.	● County Planning Forecst	● County Bldg. Dept.	○ Irrigation District	○ Drainage District	○ Water District	○ Sewer District	○ U.S. West	○ Public Service	○ GVRP	○ CDOT	○ Corps of Engineers	○ Walker Field	○ Persigo WWT	○ Mesa County Health	○ State Environ. Health	○ City Sanitation	○ School Dist #51				
		● Application Fee <u>\$175.00</u>	VII-1	1																										
● Submittal Checklist *	VII-3	1																												
● Review Agency Cover Sheet*	VII-3	1	1	1	1	1	1	1	1	1	1	1	1	1	1	1	1	1	1	1	1	1	1	1	1	1	1	1	1	
● Planning Clearance*	VII-3	1																												
● 11"x17" Reduction of Assessor's Map	VII-1	1	1	1	1	1	1	1	1	1	1	1	1	1	1	1	1	1	1	1	1	1	1	1	1	1	1	1	1	
● Evidence of Title	VII-2	1		1			1																							
○ Deeds	VII-1	1		1			1																							
○ Easements	VII-2	1	1	1	1		1																							
○ Avigation Easement	VII-1	1		1			1																							
○ ROW	VII-2	1	1	1	1		1																							
○ Improvements Agreement/Guarantee*	VII-2	1	1	1			1																							
○ CDOT Access Permit	VII-3	1	1																											
○ Industrial Pretreatment Sign-off	VII-4	1		1																										
● General Project Report	X-7	1	1	1	1	1	1	1	1	1	1	1	1	1	1	1	1	1	1	1	1	1	1	1	1	1	1	1	1	
● Elevation Drawing	IX-13	1	1																											
● Site Plan	IX-29	2	2	1	1	1	1	1	1	1	1	1	1	1	1	1	1	1	1	1	1	1	1	1	1	1	1	1	1	
○ 11"x17" Reduction of Site Plan	IX-29				1	1	1	1	1	1	1	1	1	1	1	1	1	1	1	1	1	1	1	1	1	1	1	1	1	
● Grading and Drainage Plan	IX-16	1	2										1							1										
○ Storm Drainage Plan and Profile	IX-30	1	2										1		1	1	1													
○ Water and Sewer Plan and Profile	IX-34	1	2	1			1						1	1	1	1	1													
○ Roadway Plan and Profile	IX-28	1	2										1																	
○ Road Cross-Sections	IX-27	1	2																											
○ Detail Sheet	IX-12	1	2																											
● Landscape Plan	IX-20	2	1	1																										
○ Geotechnical Report	X-8	1	1							1																				
● Final Drainage Report	X-5,6	1	2											1																
○ Stormwater Management Plan	X-14	1	2										1							1										
○ Phase I and II Environmental Rerpot	X-10,1	1	1																											
○ Traffic Impact Study	X-15	1	2																	1										

NOTES: * An asterisk in the item description column indicates that a form is supplied by the City.

See also file # 36-91

PRE-APPLICATION CONFERENCE

Date: 9/13/96

Conference Attendance: Kathy P. Lou Grasso

Proposal: 2518/2520 Blichman

Location: Unified Technical Center

Tax Parcel Number: 2943-033-15-964

Review Fee: _____

(Fee is due at the time of submittal. Make check payable to the City of Grand Junction.)

Additional ROW required? _____

Adjacent road improvements required? _____

Area identified as a need in the Master Plan of Parks and Recreation? _____

Parks and Open Space fees required? _____ Estimated Amount: _____

Recording fees required? _____ Estimated Amount: _____

Half street improvement fees/TCP required? ? Estimated Amount: _____

Revocable Permit required? _____

State Highway Access Permit required? _____

On-site detention/retention or Drainage fee required? yes

Applicable Plans, Policies and Guidelines _____

Located in identified floodplain? FIRM panel # _____

Located in other geohazard area? _____

Located in established Airport Zone? Clear Zone, Critical Zone, Area of Influence? _____

Avigation Easement required? _____

While all factors in a development proposal require careful thought, preparation and design, the following "checked" items are brought to the petitioner's attention as needing special attention or consideration. Other items of special concern may be identified during the review process.

Access/Parking Screening/Buffering Land Use Compatibility

Drainage Landscaping Traffic Generation

Floodplain/Wetlands Mitigation Availability of Utilities Geologic Hazards/Soils

Other _____

Related Files: _____

It is recommended that the applicant inform the neighboring property owners and tenants of the proposal prior to the public hearing and preferably prior to submittal to the City.

PRE-APPLICATION CONFERENCE

WE RECOGNIZE that we, ourselves, or our representative(s) must be present at all hearings relative to this proposal and it is our responsibility to know when and where those hearings are.

In the event that the petitioner is not represented, the proposed item will be dropped from the agenda, and an additional fee shall be charged to cover rescheduling expenses. Such fee must be paid before the proposed item can again be placed on the agenda. Any changes to the approved plan will require a re-review and approval by the Community Development Department prior to those changes being accepted.

WE UNDERSTAND that incomplete submittals will not be accepted and submittals with insufficient information, identified in the review process, which has not been addressed by the applicant, may be withdrawn from the agenda.

WE FURTHER UNDERSTAND that failure to meet any deadlines as identified by the Community Development Department for the review process may result in the project not being scheduled for hearing or being pulled from the agenda.

X _____
Signature(s) of Petitioner(s)

X [Signature]
Signature(s) of Representative(s)

**CITY OF GRAND JUNCTION
ADMINISTRATIVE SERVICES
M E M O R A N D U M**

DATE: September 18, 1996
TO: Mark Achen, Dave Varley, Ron Lappi, Jim Shanks, John Shaver, Greg Trainor
CC: Dan Wilson, Kathy Portner, Trent Prall
FROM: Jodi Romero, Customer Service Manager *JR*
RE: UTEC & Resulting Issues

After research into the UTEC situation, I have arrived at the following answers and questions regarding 3 basic issues:

ISSUE #1 -- UTEC-Existing facility at 2508 Blichman Ave.

The answer to everyone's question of how UTEC came to be on our sewer system without paying a PIF and getting a planning clearance is simple (however illegal it may be). UTEC is a cooperative educational effort between Mesa State and School District 51 and when Mesa State College was in charge of this construction project (spring '91) they **circumvented the entire process** by not obtaining a building permit. This means no certificate of occupancy, building permit, planning clearance, or sewer clearance (PIF) were issued for this project. It is my understanding that Mesa State has historically ignored local jurisdictions' procedures, processes, rules, etc.

This brings up the question of *what is the City's position on the past due PIF and monthly sewer charges (4 yrs worth) for this existing UTEC building?* This facility opened in August of 1992. I will wait for direction.

ISSUE #2 --Present and Future Projects by School District 51

At this time UTEC is looking to expand it's campus. Lou Grasso, consultant for School District 51, is the project manager. Grasso now has planning papers but has yet to submit anything in writing. It appears as though this expansion is to accommodate another 200 students and may possibly include a cafeteria. It also appears to be a completely separate structure.

Administrative Services
Memo-Page 2

It is my understanding that the School District has a written agreement with the Building Department that requires them to follow the building permit process. So because the School District is in charge of this UTEC project, they appear to be following the required processes right now?!

Per Kathy Portner, the City (Mark, Dan) is planning a meeting with the School District to come to a "final decision" on both this project and future projects of the District and whether they are within to City jurisdiction.

What is the City's position?? Again I will wait for direction on this issue.

ISSUE #3 -- Mesa State College and other State Projects

The final issue arising out of this is one with more of a legal angle. As I said before Mesa State has historically "ignored" us. *Do they have a legal basis to back them up??* Specifically in the last few years, Mesa has re-modeled their college center and more significantly is now constructing the new dormitories. My initial research into these results in the same scenario, that they did not go through the building permit process and therefore avoided all City processes. The college center is being billed monthly, but I can not find evidence of a PIF being paid. Of course the dormitories are not completed, but there is no evidence of a PIF being paid (which I am sure would be significant) and it brings up the additional problem of even getting the account/address into the system to set up billing for monthly sewer service fees.

The final question....are both the City & County going to continue to allow Mesa State to ignore their processes? What is our legal vs. practical position?

IN CONCLUSION --

We (Customer Service and Community Development) are doing all within our power to regulate construction and connection to the sewer system, but when the entire system is circumvented we obviously lose some ability to do so.

I wanted to include all participants in the E-mail circuit, but I would imagine initial direction would come from you Mark.

Thanks! If anyone wants more information, please contact me.

**FINAL DRAINAGE REPORT
FOR
UTEC SITE IMPROVEMENT**

PREPARED FOR:
SCHOOL DISTRICT 51
GRAND JUNCTION, COLORADO


PRESENTED TO:
THE CITY OF GRAND JUNCTION

ROLLAND ENGINEERING

405 RIDGES BLVD., SUITE A
GRAND JUNCTION, CO 81503
(970)-243-8300

ROLLAND ENGINEERING

405 RIDGES BOULEVARD, SUITE A
GRAND JUNCTION, COLORADO 81503
(970) 243-8300

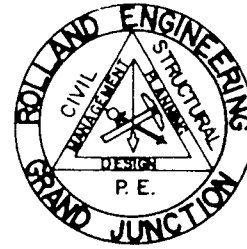

Sep 19, 1996

Ms. Jody Kliska
Development Engineer
250 North 5th Street
Grand Junction, CO 81501

RE: FINAL DRAINAGE REPORT FOR UTEC SITE IMPROVEMENT

Dear Jody;

Enclosed you will find the Final Drainage Report for UTEC SITE IMPROVEMENT. Drainage computations for 2-Year and 100-Year design storms were performed for this report.

Please call us if you have any questions or need any additional information. Thank you very much for your time and consideration regarding this report.

Respectfully submitted


ROLLAND ENGINEERING

WEI LI, EIT

A handwritten signature in black ink, appearing to read 'Wei Li'.

Enclosures

I HEREBY CERTIFY THAT THIS REPORT (PLAN) FOR THE FINAL DRAINAGE
DESIGN OF "UTEC SITE IMPROVEMENT" WAS PREPARED UNDER MY
DIRECT SUPERVISION.


REGISTERED PROFESSIONAL ENGINEER
STATE OF COLORADO, NUMBER 12896



**FINAL DRAINAGE REPORT
FOR
UTEC SITE IMPROVEMENT**

**PREPARED FOR:
SCHOOL DISTRICT 51
GRAND JUNCTION, COLORADO**

**PREPARED BY:

ROLLAND ENGINEERING
405 RIDGES BLVD., SUITE A
GRAND JUNCTION, CO 81503
SEP 19, 1996**

TABLES OF CONTENTS

General Locations and Description.....	Page. 1
Existing Drainage Conditions.....	Page. 1
Proposed Drainage Conditions.....	Page. 1
Design Criteria and Approach.....	Page. 1
Summary.....	Page. 2

Vicinity Map (Figure. 1)

Soil Map (Figure. 2)

Appendix A:

2-Year and 100-Year Design Storm Calculations.....	A. 1
Inlet Capacity Checking.....	A. 3
Storm Sewer Capacity Checking.....	A. 3
Detention Pond Volume Determination.....	A. 3

Appendix B:

Pre-development Drainage Map for UTEC SITE IMPROVEMENT

Post -development Drainage Map for UTEC SITE IMPROVEMENT

Appendix C:

Storage Volume & Depth Relationship

Supplement:

Soil Description (SCS)

Hydrological Soil Groups (SCS)

References:

Intensity Duration Frequency Curves- Figure 401b

Rational Method Runoff Coefficient- Table 402

Determination of Ts-Figure "E-3"

Maximum Inlet Capacity: Sump or Sag Conditions-Table "G-1"

Flow Chart for Pipe Flowing Full

UTEC DRAINAGE

GENERAL LOCATION AND DESCRIPTIONS

UTEC (United Technical Education Center) is an approximate 6.6 acres site located in the Foresight Industrial Park of Grand Junction, Colorado. The project site lies immediately South of F 1/2 Road, North of Blichman Ave, and approximately 700 feet East of 25 road. Access to the site can be gained from Blichman Ave and F 1/2 Road. The ground is covered with sparse short native grasses and some dirt piles.

The site has soils consisting of a Ravola sandy loam (Rf) and a Billings silty clay loam (Bc).

EXISTING DRAINAGE CONDITIONS

The site has a natural slope of 1.0 % to 1.5% on average toward the Southwest. Drainage basin limits for this site are defined by the F 1/2 road just north of the property and site improvement just East of the property line. There is no off-site runoff contribution to this site. At present, the site drains to Southwest to Blichman Ave and Foresight Circle street gutter system. Runoff from this site ultimately drains to the canal on the south side of Patterson Road. There are no previously determined 100-Year floodplain on this site.

PROPOSED DRAINAGE CONDITIONS

Of the 6.6 acres site, approximately only 4.5 acre will be improved with paved parking lot, building or landscaping. Runoff from the entire site will drain to a proposed detention pond at the southwest corner of the property via valley pan, storm inlets and storm sewers. Stormwater will then be released to the street gutter on Blichman and Foresight Circle at historic rates.

DESIGN CRITERIA AND APPROACH

We are not aware of any Master Plan or any other limitations on this site.

The Hydrology and Hydraulic computations conducted for this site utilized the STORMWATER MANAGEMENT MANUAL (JUNE, 1994 Edition). The Rational Method was used to perform the analysis for the 2 and 100 Year Design Events.

UTEC DRAINAGE

SUMMARY

Summarized below are the drainage calculations for this project:

Project Area: $A = 6.6$ acres

Drainage Calculation Method: Rational Method

Design Storm Events: 2-Year and 100-Year Storms

Pre-development Runoff Rates:

2-Year Historic Storm:

$$Q_{2h} = 1.16 \text{ cfs}$$

100-Year Historic Storm:

$$Q_{100h} = 3.81 \text{ cfs}$$

Post-development Runoff Rates:


2-Year Developed Storm:

$$Q_{2d} = 4.09 \text{ cfs}$$

100-Year Developed Storm:


$$Q_{100d} = 11.55 \text{ cfs}$$


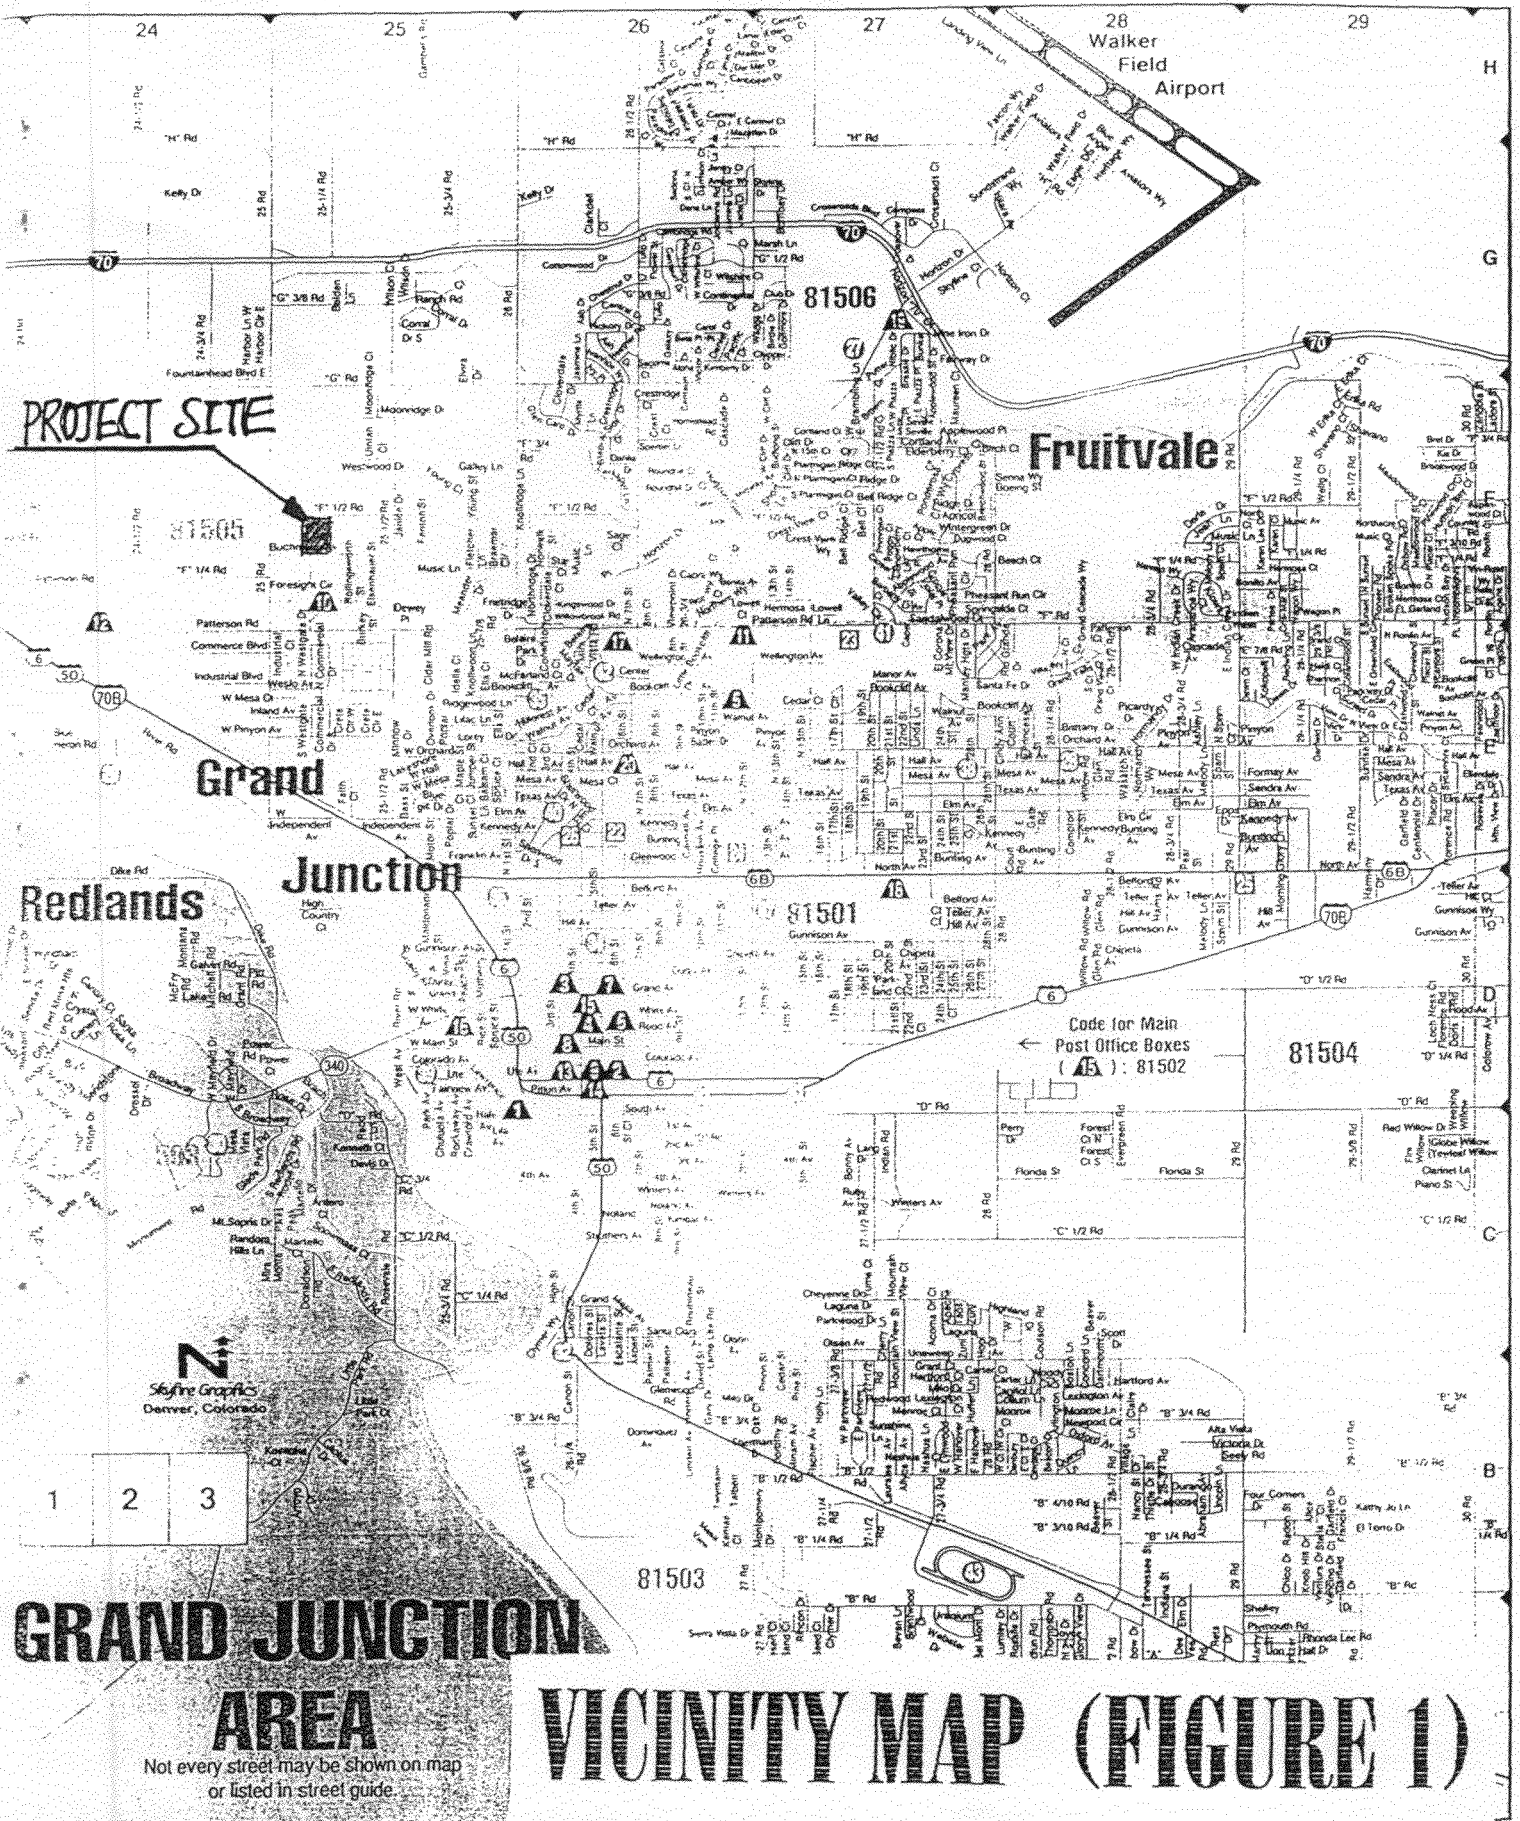

Not every street may be shown on map or listed in street guide.

SOIL MAP (FIGURE 2)

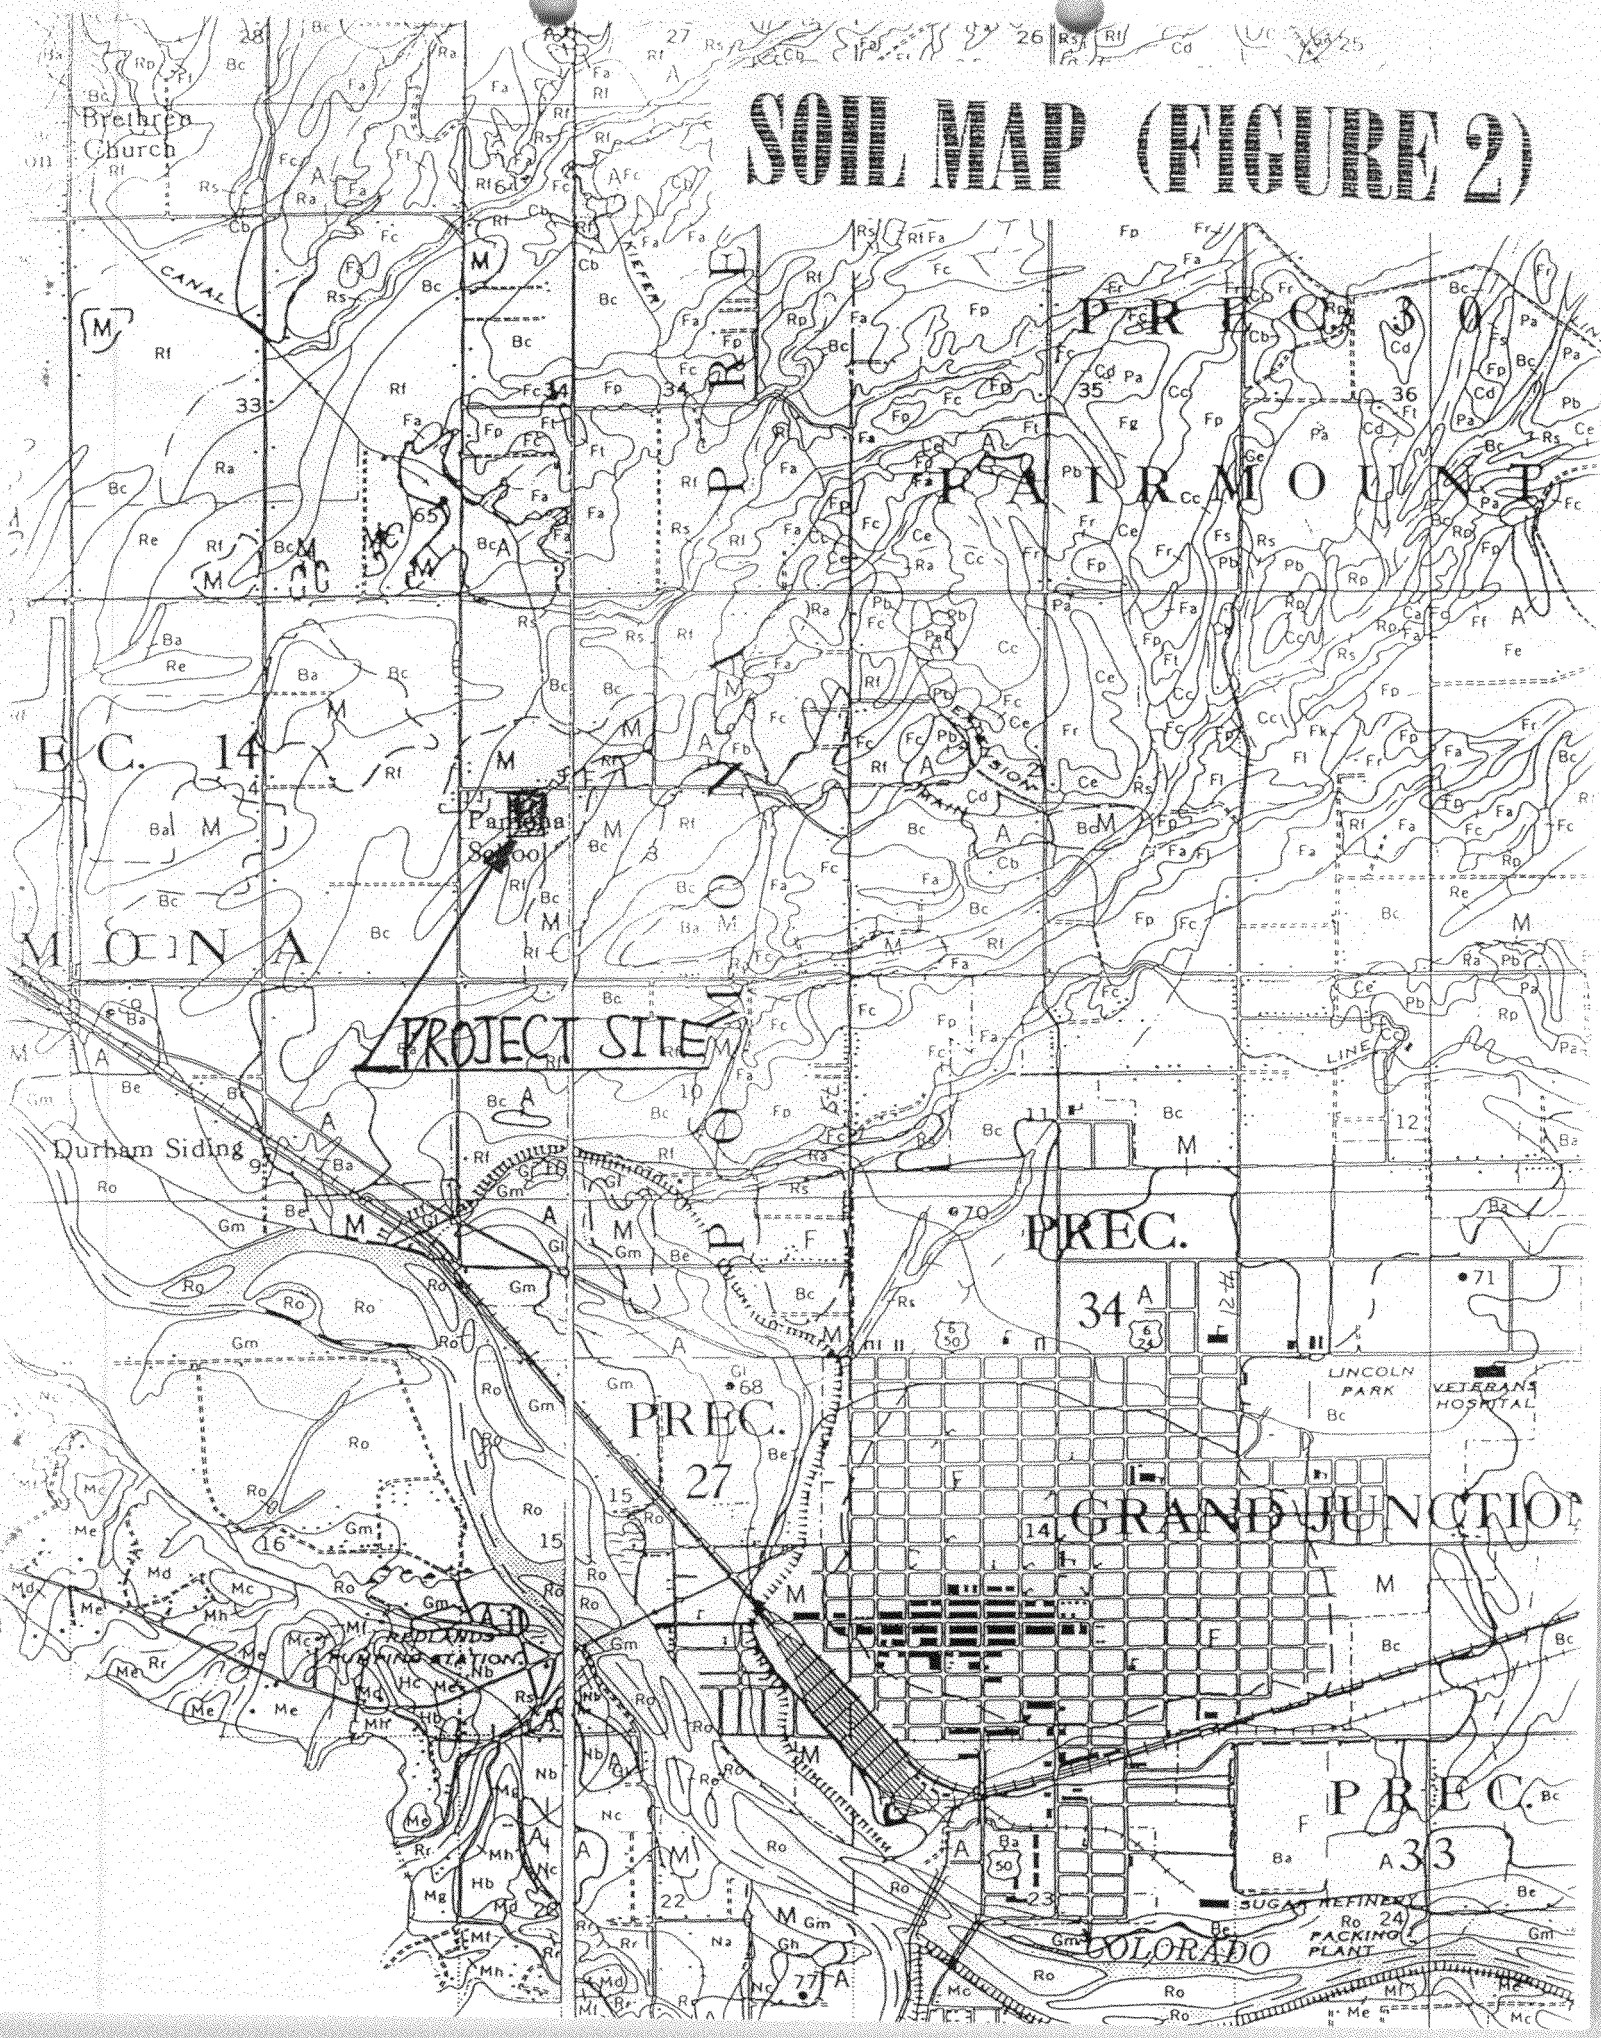

APPENDIX A

UTEC DRAINAGE

HISTORIC CONDITION

1. Drainage Area A = 6.6 Acre

(1) 2-Year Storm:

Hydrological soil group: B

Runoff Coefficient $C_{2h} = 0.20$ (meadow)

Overland Flow Length $L_o = 300$ ft

Overland flow slope $S_o = 1.2\%$

Overland flow time $T_o = 1.8(1.1-C)(L)^{0.5}/(S)^{0.333}$
 $= 1.8(1.1-0.20)(300)^{0.5}/(1.2)^{0.333} \approx 26.4$ min

Shallow concentrated flow length $L_s = 249$ ft

Flow velocity $V = 1.1$ ft/s (nearly bare and untilled)

$T_s = 249/1.1/60 = 3.8$ min

Time of concentration $T_c = 26.4 + 3.8 = 30.2$ min

Intensity $I_{2h} = 0.88$ in/hr

Runoff $Q_{2h} = CIA = 0.20 * 0.88 * 6.6 = \underline{1.16}$ cfs

(2) 100-Year Storm:

Hydrological soil group: B

Runoff Coefficient $C_{100h} = 0.25$ (meadow)

Overland Flow Length $L_o = 300$ ft

Overland flow slope $S_o = 1.2\%$

Overland flow $T_o = 1.8(1.1-C)(L)^{0.5}/(S)^{0.333}$
 $= 1.8(1.1-0.25)(300)^{0.5}/(1.2)^{0.333} \approx 24.94$ min

Shallow concentrated flow length $L_s = 249$ ft

Flow velocity $V = 1.1$ ft/s (nearly bare and untilled)

$T_s = 249/1.1/60 = 3.8$ min

Time of concentration $T_c = 24.94 + 3.8 = 28.7$ min

Intensity $I_{100h} = 2.31$ in/hr

Runoff $Q_{100h} = CIA = 0.25 * 2.31 * 6.6 = \underline{3.81}$ cfs

DEVELOPED CONDITION

1. Drainage Area A = 6.6 Acres

(1) 2-Year Storm:

Hydrological soil group: B

3 acres Pavement & Roof; Runoff Coefficient $C_{2d} = 0.93$

UTEC DRAINAGE

DEVELOPED CONDITION

3.6 acres bare ground & landscaping; Runoff Coefficient $C_{2d} = 0.20$

Composite runoff coefficient $C_{2dc} = (0.2*3.6+0.93*3)/6.6=0.53$

Overland Flow Length $L_o = 300$ ft

Overland flow slope $S_o = 1.2\%$

Overland flow time $T_o = 1.8(1.1-C)(L)^{0.5}/(S)^{0.333} = 1.8(1.1-0.53)(300)^{0.5}/(1.2)^{0.333} = 16.72$ min

Storm sewer flow: 182.5 lf 8" PVC at 1.25%, $V_8 = 5.6$ ft/s

$T_8 = 182.5/5.6 /60 = 0.54$ min

388 lf 15" PVC at 0.55%, $V_{15} = 5.6$ ft/s

$T_{15} = 388/5.6 /60 = 1.15$ min

Time of concentration $T_c = 16.72 + 0.54 + 1.15 = 18.41$

$I_{2d} = 1.17$ in/hr

$Q_{2d} = CIA = 0.53 * 1.17 * 6.6 = 4.09$ cfs

(1) 100-Year Storm:

Hydrological soil group: B

3 acres Pavement & Roof; Runoff Coefficient $C_{2d} = 0.95$

3.6 acres bare ground & landscaping; Runoff Coefficient $C_{2d} = 0.25$

Composite runoff coefficient $C_{2dc} = (0.25*3.6+0.95*3)/6.6=0.57$

Overland Flow Length $L_o = 300$ ft

Overland flow slope $S_o = 1.2\%$

Overland flow time $T_o = 1.8(1.1-C)(L)^{0.5}/(S)^{0.333} = 1.8(1.1-0.57)(300)^{0.5}/(1.2)^{0.333} = 15.56$ min

Storm sewer flow: 182.5 lf 8" PVC at 1.25%, $V_8 = 5.6$ ft/s

$T_8 = 182.5/5.6 /60 = 0.54$ min

388 lf 15" PVC at 0.55%, $V_{15} = 5.6$ ft/s

$T_{15} = 388/5.6 /60 = 1.15$ min

Time of concentration $T_c = 15.56 + 0.54 + 1.15 = 17.25$

$I_{100d} = 3.07$ in/hr

Runoff $Q_{100d} = CIA = 0.57 * 3.07 * 6.6 = 11.55$ cfs

SUMMARY OF RUNOFF RATES

	HISTORIC CONDITION	DEVELOPED CONDITION
10-YEAR STORM:	$Q_{2h} = 1.16$ cfs;	$Q_{2d} = 4.09$ cfs;
100-YEAR STORM:	$Q_{100h} = 3.81$ cfs;	$Q_{100d} = 11.55$ cfs;

UTEC DRAINAGE

INLET CAPACITY CHECKING

According to Table "G-1" (from City of Grand Junction Stormwater Management Manual, June, 1994) attached in the "References" of this report, single combination inlet has a capacity of 6.4 cfs for 2-Year storm and 13 cfs for 100-Year storm which are bigger than the calculated runoffs of $Q_{2d}=4.09$ cfs and $Q_{100d}=11.55$ cfs for this site.

STORM SEWER CAPACITY CHECKING

The 182.5 LF 8" PVC storm sewer from inlet #1 to inlet #2 has a slope of 1.25%, the capacity of this storm sewer is 1.9 cfs. (according to "Flow Chart for Pipe Flowing Full" attached in the "References" of this report). The drainage area for this storm sewer is about 1.2 acres. Runoff from this area are calculated as follows:

$$\begin{aligned}C_{100d} &= 0.25; \text{ Overland flow length } L=300\text{ft}; \text{ Slope } S=1.2\% \\ \text{Time of concentration } T_c &= 1.8(1.1-0.25)(300)^{0.5}/1.2)^{0.33} = 25 \text{ min} \\ I_{100d} &= 2.51 \text{ in/hr} \\ Q_{100d} &= CIA = 0.25 * 2.51 * 1.2 = 0.75 \text{ cfs (OK)}\end{aligned}$$

The 388 LF 15" PVC storm sewer from inlet #2 to the detention pond has a slope of 0.55%, the capacity of this storm sewer is 7.2 cfs. (according to "Flow Chart for Pipe Flowing Full" attached in the "References" of this report). The drainage area for this storm sewer is about half of the site, and half of 100-Year developed runoff for this site is 5.78 cfs.

The 170 LF 8" PVC storm sewer from inlet #4 to inlet #3 has a slope of 0.50%, the capacity of this storm sewer is 1.4 cfs. (according to "Flow Chart for Pipe Flowing Full" attached in the "References" of this report). The drainage area for this storm sewer is about 10% of the site, and 10% of 100-Year developed runoff for this site is 1.2 cfs.

The two (lay side by side) 99.5 LF 8" PVC storm sewer from inlet #3 to the detention pond has slope of 0.4%, the capacity of this storm sewer is 2.6 cfs ($2 * 1.3 = 2.6$ cfs) (according to "Flow Chart for Pipe Flowing Full" attached in the "References" of this report). The drainage area for this storm sewer is about 20% of the site, and 20% of 100-Year developed runoff for this site is 2.31 cfs.

DETENTION VOLUME DETERMINATION

(1) 2-Year Detention Volume

$$T_{2d} = 18.41 \text{ min}; \quad T_{2h} = 30.2 \text{ min}$$

$$K = 30.2/18.41 = 1.64$$

$$Q_{2h} = 1.16 \text{ cfs}; \quad Q_r = 0.82 * 1.16 \text{ cfs} = 0.95 \text{ cfs}$$

$$A = 6.6 \text{ acres}; \quad C_{2d} = 0.53$$

$$T_{d2} = \{633.4 * 0.53 * 6.6 / [0.95 - 0.95^2 * 18.41 / (81.2 * 0.53 * 6.6)]^{0.5} - 15.6\} = 34.3 \text{ min}$$

$$I_{d2} = 40.6 / (34.3 + 15.6) = 0.81 \text{ in/hr}$$

$$Q_{d2} = CIA = 0.53 * 0.81 * 6.6 = 2.83 \text{ cfs}$$

$$\begin{aligned}V_{d2} &= 60 \{2.83 * 34.3 - 0.95 * 34.3 - 0.95 * 18.41 + 1.64 * 0.95 * 18.41 / 2 + 0.95 * 0.95 * 18.41 / (2 * 2.83)\} \\ &= 3846 \text{ CF}\end{aligned}$$

UTEC DRAINAGE

DETENTION VOLUME DETERMINATION

(1) 100-Year Detention Volume

$$T_{100d} = 17.25 \text{ min};$$

$$T_{100h} = 28.7 \text{ min}$$

$$K = 28.7/17.25 = 1.66$$

$$Q_{100h} = 3.81 \text{ cfs};$$

$$Q_r = 0.82 * 3.81 \text{ cfs} = 3.12 \text{ cfs}$$

$$A = 6.6 \text{ acres};$$

$$C_{100d} = 0.57$$

$$T_{d100} = \{1832 * 0.57 * 6.6 / [3.12 - 3.12 * 17.25 / (213 * 0.57 * 6.6)]^{0.5} - 17.2\} = 31.5 \text{ min}$$

$$I_{d100} = 106.5 / (31.5 + 17.2) = 2.18 \text{ in/hr}$$

$$Q_{d100} = CIA = 0.57 * 2.18 * 6.6 = 8.20 \text{ cfs}$$

$$V_{d100} = 60 \{ 8.20 * 31.5 - 3.12 * 31.5 - 3.12 * 17.25 + 1.66 * 3.12 * 17.25 / 2 + 3.12 * 3.12 * 17.25 / (2 * 8.20) \} = 9635 \text{ CF}$$

DETENTION VOLUME AVAILABLE

Bottom of pond area=3880 sf; Bottom of pond elevation=4579.5

Top of pond area=12344 sf; Top of pond elevation=4581.5

The detention pond has a inside side slope 3:1

Detention volume available = $\{3880 + 12344 + (3880 * 12344)^{0.50}\} * 2/3 = 15430 \text{ CF}$

DETENTION POND RELEASE PIPES DESIGN

2-Year stormwater level in the detention pond is 4580.05

100-Year stormwater level in the detention pond is 4580.8

(1) 2-Year Release Pipe Size Determination

Try 8" PVC, Invert Elevation=4579.40; Cross-section area=0.35 sf

2-Year storm water depth=4580.05-4579.40=0.65 ft

Since 8" PVC diameter is 8"/12 = 0.67 ft, the pipe is flowing close to full. The capacity of the 8" PVC at 0.52% flowing full is 1.3 cfs ($>Q_{2h} = 1.16 \text{ cfs}$, OK)

(2) 100-Year Release Pipe Size Determination

Water depth above the centerline of 8" PVC $H = 4580.8 - 4579.4 - 0.67/2 = 1.07 \text{ ft}$

8" PVC release rate $Q_8 = CA(2gH)^{0.5} = 0.6 * 0.35(2 * 32.2 * 1.07)^{0.5} = 1.74 \text{ cfs}$


Try 12" PVC, Invert elevation=4580.2, slope $S = 1\%$, Cross-section area=0.79 sf
water depth above the invert of the pipe=4580.8-4580.2=0.6 ft (flowing half full)

For flowing half full, Hydraulic radius $R = 0.13 \text{ ft}$,

then the release rate $Q = 1.49 * A * R^{2/3} * S^{1/2} / n$

$$= 1.49 * (0.79/2) * (0.13)^{2/3} * (0.11)^{1/2} / 0.009 = 5.5 \text{ cfs (OK)}$$

APPENDIX B

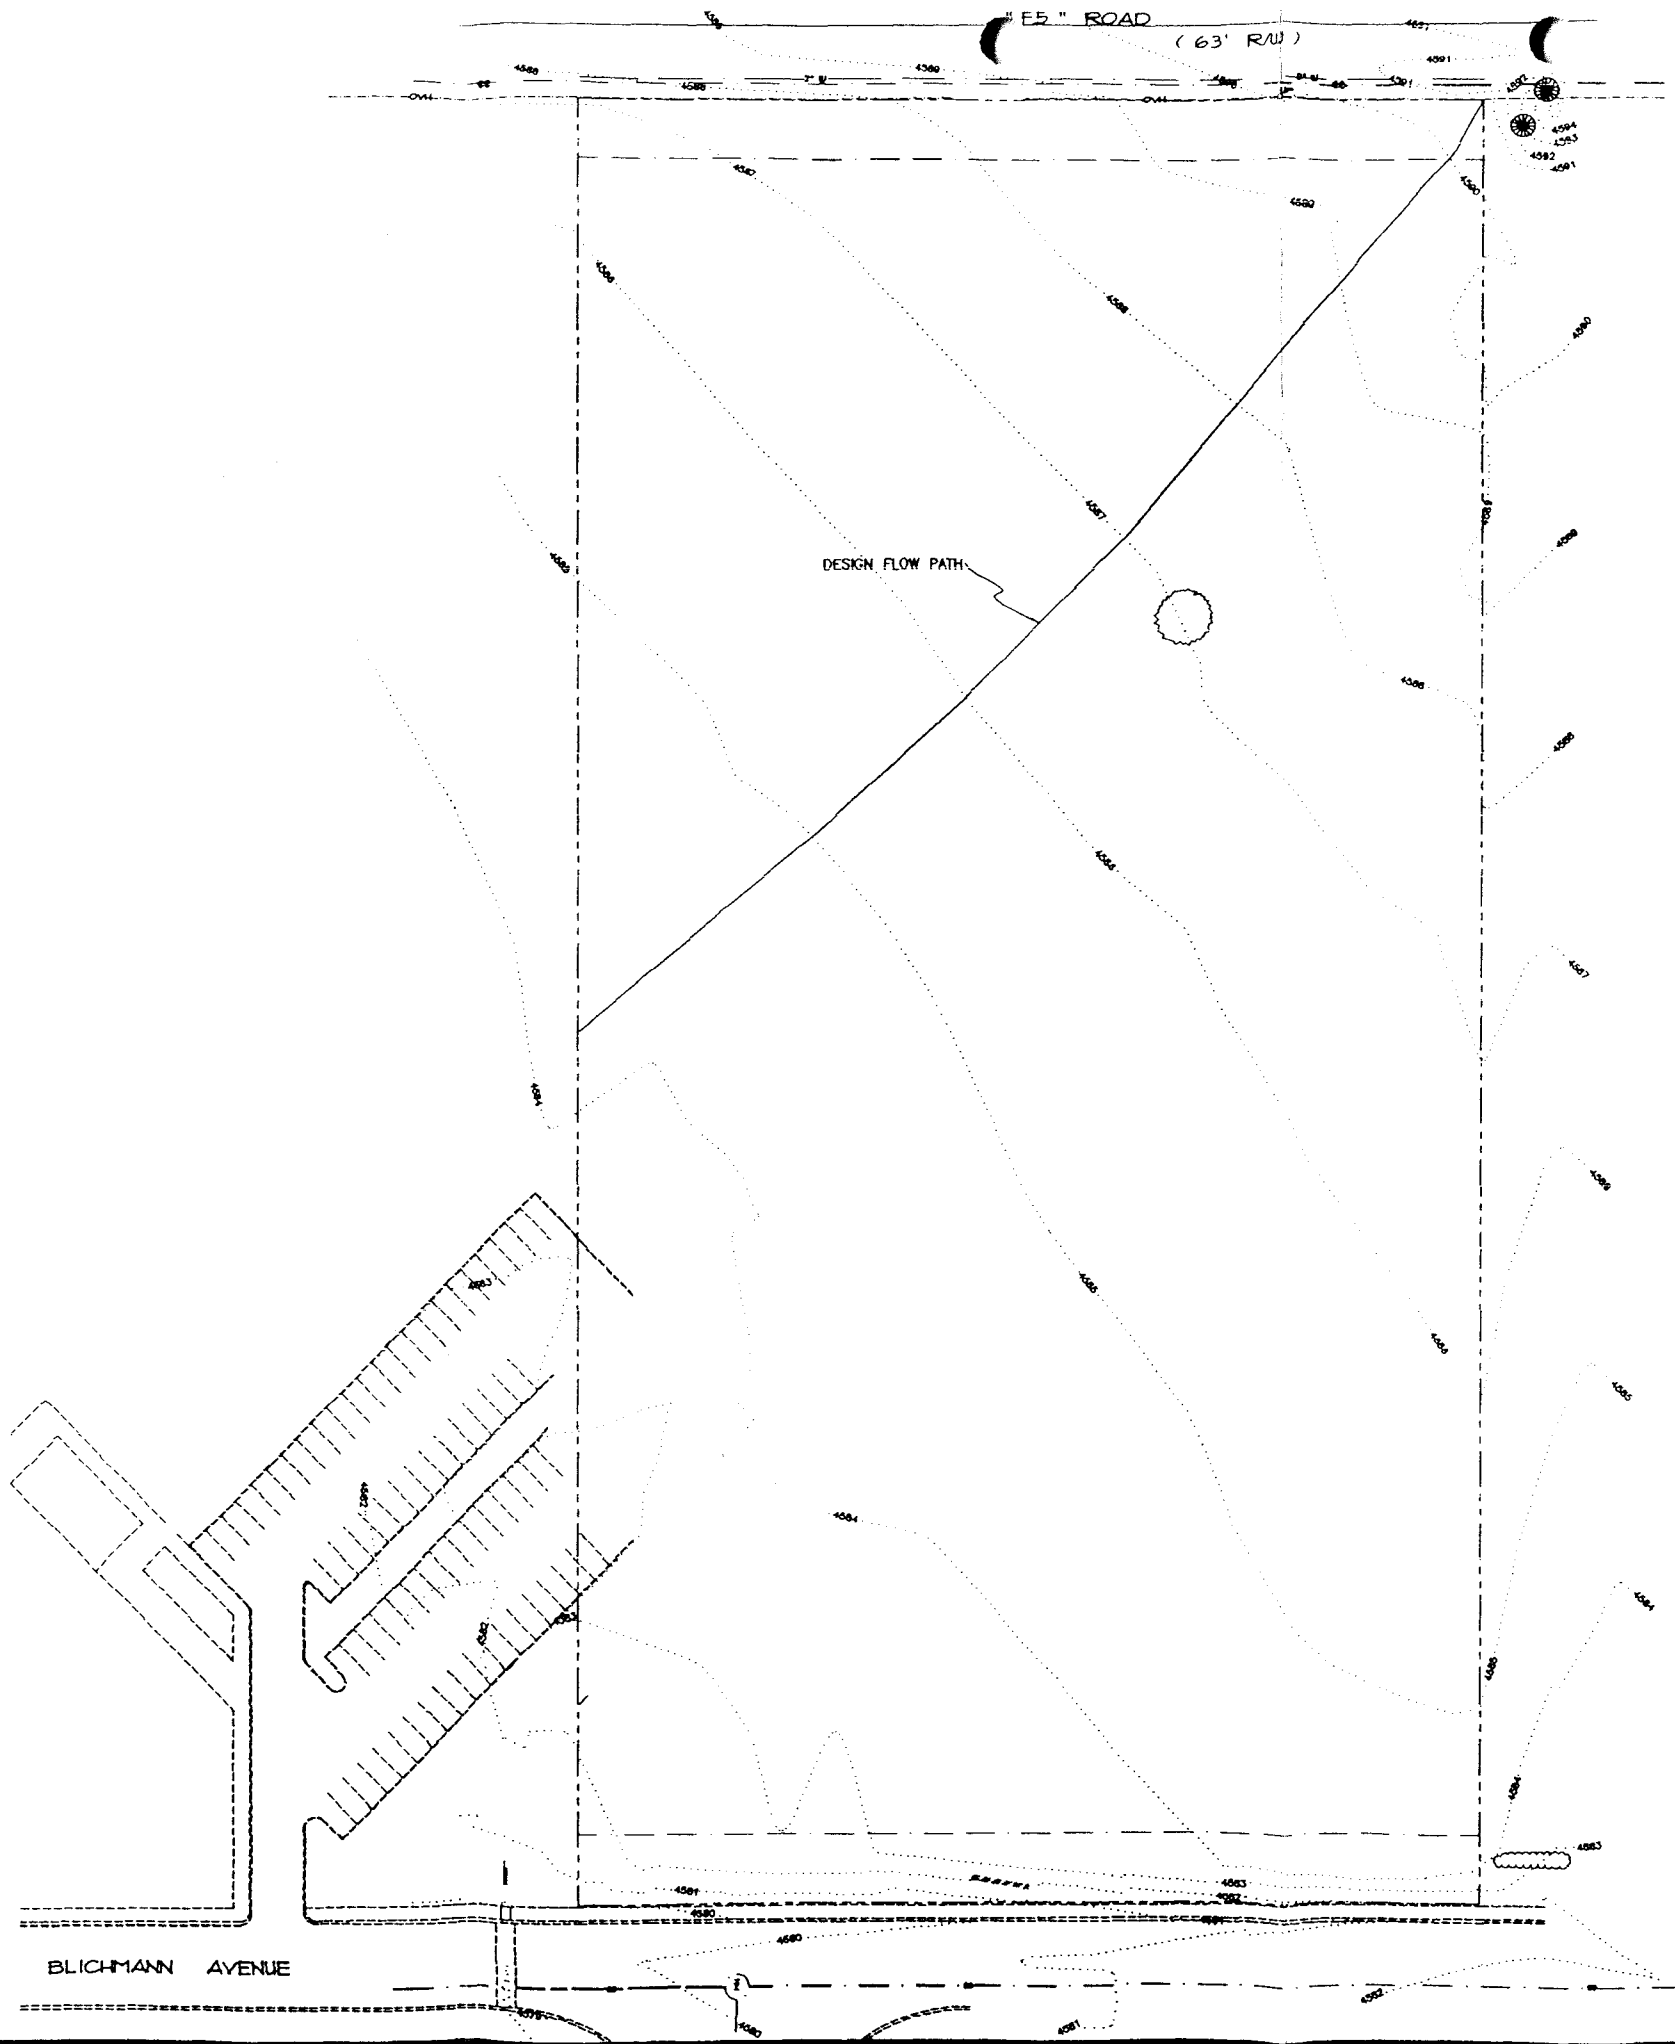

DILLON-HUNT P.C.
 ARCHITECTURE
 AND FACILITY
 MANAGEMENT
 804 BRANG AVENUE
 COLORADO SPRINGS,
 CO 80901
 PHONE 303-586-7883
 (FAX) 303-586-7437

H-HL ARCHITECTURE
 1825 10TH STREET
 SUITE 110
 DENVER, COLORADO 80202
 (303) 296-4782
 (303) 292-6437 (FAX)

PROJECT NAME
FRAME
 DRAWN BY
 CHECKED BY

VERSION

NOT FOR CONSTRUCTION
 PDATE

PROJECT NO.
 DATE
 SCALE
 SHEET NO.

TITLE1 WEC Site Improvement
TITLE2
TITLE3 pre-development Drainage Map




SHEET NO.
8HT
 of TOTAL

C:\UTEC\GDPLAN Fri Sep 20 13:58 1996 ROLLAND ENGINEERING


APPROVED FOR CONSTRUCTION
CITY DEVELOPMENT ENGINEER
DATE
CITY UTILITY ENGINEER
DATE

ACCEPTED AS CONSTRUCTED
CITY DEVELOPMENT ENGINEER
DATE
CITY UTILITY ENGINEER
DATE


- NOTES:
1. THE CONTRACTOR SHALL BE RESPONSIBLE FOR LOCATING ALL UTILITIES IN THE FIELD PRIOR TO PERFORMING ANY WORK AFFECTING THEM.
 2. ALL STORM SEWER SHALL BE C-900 PVC PIPE.
 3. STORM INLET #2 AND #3 SHALL BE SINGLE GRATE WITH CURB OPENING NEEDHAM R-3248. STORM INLET #1 & #4 SHALL BE AREA INLET. CONSTRUCT STORM INLETS, FRAMES AND INLET BOXES PER CITY OF GRAND JUNCTION STDS.
 4. PLEASE REFER TO THE ARCHITECTURAL SITE PLANS PER CURB, CURB GUTTER V-PAN DETAILS.
 5. ALL WORKMANSHIP, MATERIAL AND ANY OTHER CONSTRUCTION REQUIREMENTS SHALL BE IN COMPLIANCE WITH THE CITY OF GRAND JUNCTION CONSTRUCTION SPECIFICATIONS.

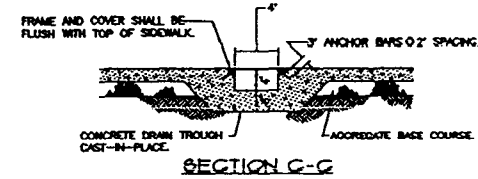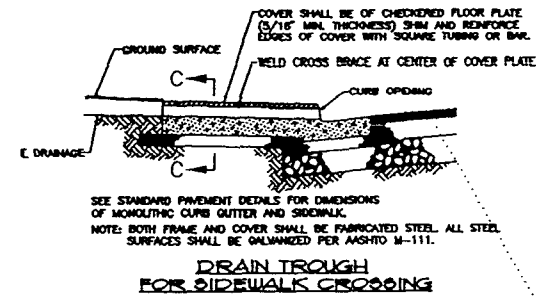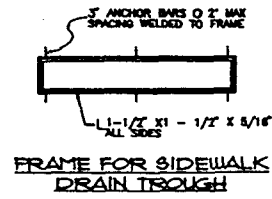


SIDEWALK CROSSING DETAILS

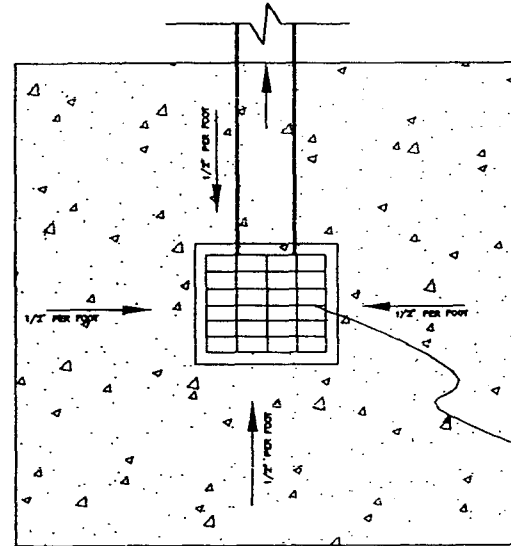

INLET #1 & #4 PLAN VIEW

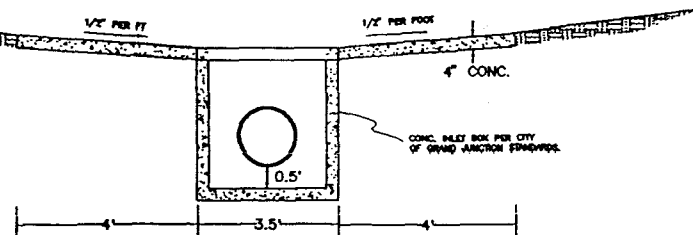


INLET A-A SECTION
AREA INLET DETAILS

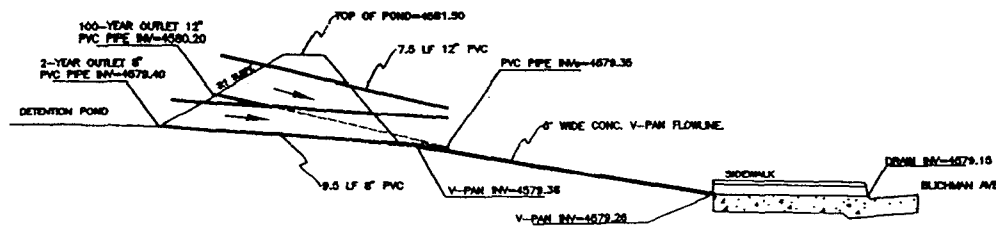

SCHEMATIC HYDRAULIC PROFILE

BLICHMANN AVENUE

BLICHMANN AVENUE (60' RAW)

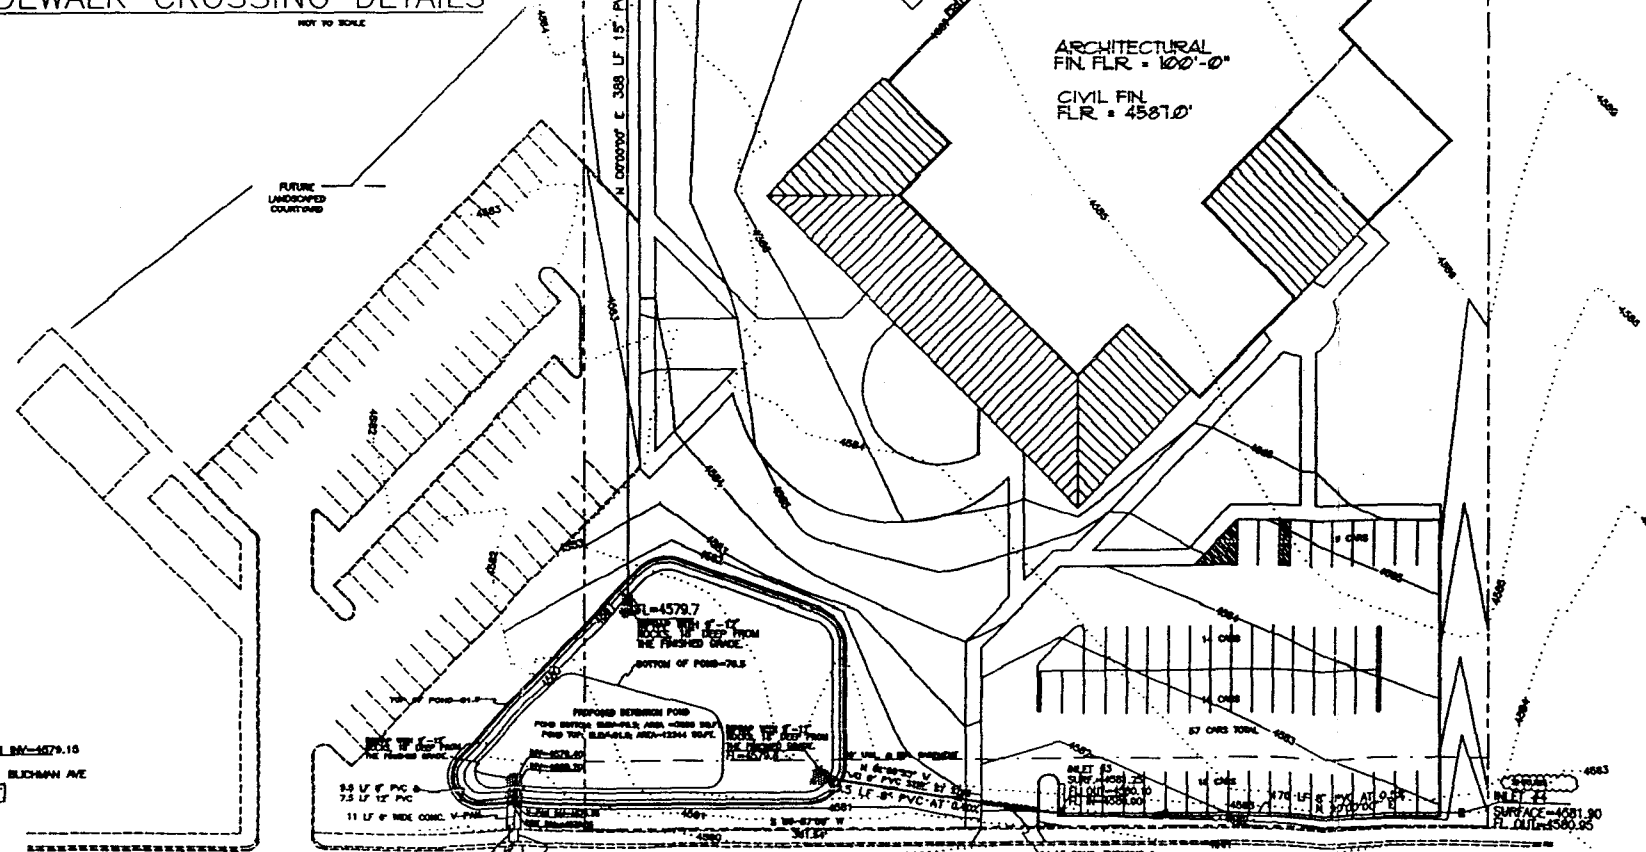

DILLON-HUNT P.A.
ARCHITECTURE AND FACILITY MANAGEMENT
804 SPRING AVENUE
GRAND JUNCTION, CO 81502
(970) 246-1283
(970) 246-7437 (FAX)

H.H. ARCHITECTURE
1221 19TH STREET
SUITE 110
DENVER, COLORADO 80202
(303) 230-1765
(303) 230-4451 (FAX)

PROJECT NAME: **UTEC**
DATE: **9/19/96**
DRAWN BY: **RL**
CHECKED BY: **RL**
SCALE: **AS SHOWN**
SHEET NO.: **9HT**
OF TOTAL: **9**

VERSION: **1.0**

NOY FOR CONSTRUCTION


TITLE1 UTEC SITE IMPROVEMENT
TITLE2
TITLE3 POST-DEVELOPMENT DRAINAGE MAP

SHEET NO. **9HT**
OF TOTAL

APPENDIX C

VOLUME & DEPTH RELATIONSHIP

UTEC SITE PLAN

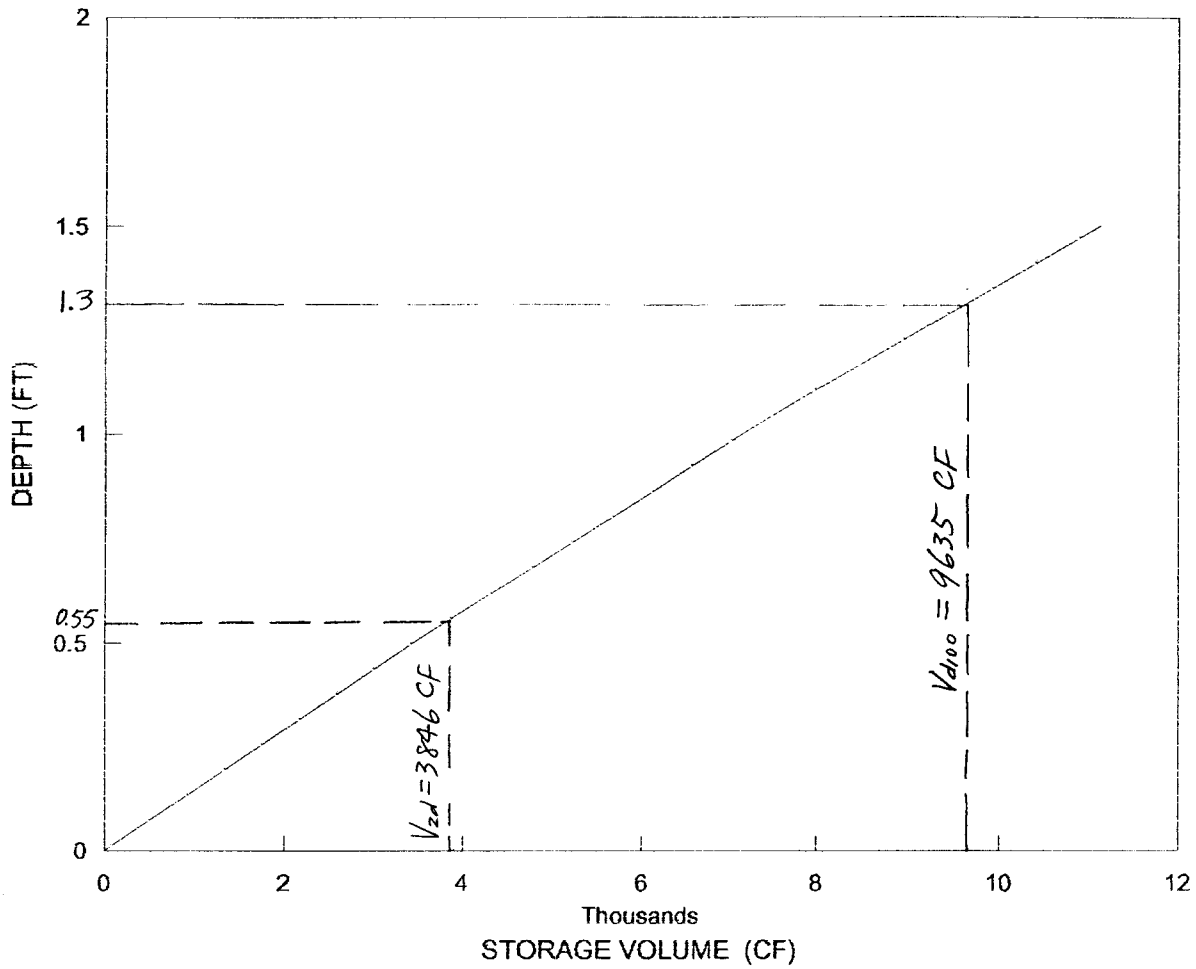

- D

SUPPLEMENT

5. Hydrologic Soil Group In addition to values being listed by ARC classification, they are also listed according to a hydrologic soil group (HSG). Infiltration varies considerably with soil type, and the difference is accounted for by selecting a CN value under the appropriate soil type. The four HSGs are defined by SCS TR-55 as follows:

Group A soils have low runoff potential and high infiltration rates even when thoroughly wetted. They consist chiefly of deep, well to excessively drained sands or gravels and have a high rate of water transmission (greater than 0.30 in/hr).

Group B soils have moderate infiltration rates when thoroughly wetted and consist chiefly of moderately deep to deep, moderately well to well drained soils with moderately fine to moderately coarse textures. These soils have a moderate rate of water transmission (0.15-0.30 in/hr).

Group C soils have low infiltration rates when thoroughly wetted and consist chiefly of soils with a layer that impedes downward movement of water and soils with moderately fine to fine texture. These soils have a low rate of water transmission (0.05-0.15 in/hr).

Group D soils have high runoff potential. They have low infiltration rates when thoroughly wetted and consist chiefly of clay soils with a permanent high water table, soils with a claypan or clay layer at or near the surface, and shallow soils over nearly impervious material. These soils have a very low rate of water transmission (0.-0.05 in/hr).

The SCS has published Soil Surveys for most areas, which map out soil "names" along with hydraulic properties allowing one to classify the HSG. Most soil surveys already contain a listing of the HSG, however. Another source that classifies the HSG once the soil "name" is known is the SCS TR-55 or NEH-4 (SCS 1972 & 1986).

In initial selection of the Hydrologic Soil Group (A, B, C, or D), care should be taken in matching soil profile conditions. Hydrologic Soil Groups (HSGs) taken from SCS Soil Surveys generally consider the profile to a depth to 60 inches, which is adequate. But they only reflect information found at the time of the survey. Earthwork in the area may have changed conditions, and there may have been changes in groundwater levels as well. These should be considered.

Some areas may not be mapped by an SCS Soil Survey. HSG must be selected by other general descriptions such as those summarized below.

HSG	Soil textures
A	Sand, loamy sand, or sandy loam
B	Silt loam or loam
C	Sandy clay loam
D	Clay loam, silty clay loam, sandy clay, silty clay, or clay

Billings silty clay loam, 0 to 2 percent slopes (Bc)—This soil, locally called adobe, is one of the most important and extensive in the Grand Valley. It covers nearly one-fifth of the Grand Junction Area. The areas occur on the broad flood plains and very gently sloping coalescing alluvial fans along streams. Many large areas are north of the Colorado River.

The soil is derived from deep alluvial deposits that came mainly from Mancos shale but in a few places from fine-grained sandstone materials. The deposits ordinarily range from 4 to 40 feet deep but in places exceed 40 feet. The deposits have been built up from thin sediments brought in by the streams that have formed the coalescing alluvial fans or have been dropped by the broad washes that have no drainage channel. The thickest deposit, near Grand Junction, was built up by Indian Wash.

The color and texture of the soil profile vary from place to place. The 8- to 10-inch surface soil normally consists of gray, light-gray, light olive-gray, or light brownish-gray silty clay loam. This layer grades into material of similar color and texture that extends to depths of 3 or 4 feet. Below this depth the successive depositional layers show more variation. Although the dominant texture is silty clay loam, the profile may have a loam, clay loam, fine sandy loam, or a very fine sandy loam texture.

Where there are fairly uniform beds of Mancos shale and where the soil is not influenced by materials deposited by adjoining drainage courses, the profile varies only slightly within the upper 3 or 4 feet. In areas bordering drainage courses, however, the soil varies more in texture and color from the surface downward.

One small area about 1½ miles southeast of Loma consists of light grayish-brown or pale-brown heavy silty clay loam that shows only slight variation in texture to depths of 4 to 6 feet. The underlying soil material is more variable. Below depths of 6 to 10 feet the layers generally are somewhat thicker and have a higher percentage of coarse soil material.

Also included with this soil are several small areas totaling about 3 square miles that are dominantly pale yellow. These are located 2½ to 3½ miles northeast of Fruita, 5 miles north of Fruita, 2½ miles northeast of Loma, 3 to 5 miles north of Loma, 1½ miles northwest of Loma, and 4 miles northwest of Mack. In these areas the 8- or 10-inch surface soil is pale-yellow silty clay loam, and the subsoil is a relatively uniform pale-yellow silty clay loam to depths of 4 to 8 feet. The accumulated alluvial layers are difficult to distinguish, but in a few places transitional to Fruita soils there are small areas having a pale-brown to light-yellowish brown color. These transitional areas are included with Billings silty clay loam because they have a finer textured subsoil than is characteristic of the Ravola soils.

Although moderately fine textured, this Billings soil permits successful growth of deep-rooted crops such as alfalfa and tree fruits. Its permeability is normally not so favorable as that of the Mesa, Fruita, and Ravola soils. Its tilth and workability are fair, but it puddles so quickly when wet and bakes so hard when dry that good tilth can be maintained only by proper irrigation and special cultural practices. Runoff is slow and internal drainage is very slow.

Like all other soils in the area, this one has a low organic-matter content. Under natural conditions it contains a moderate concen-

tration of salts derived from the parent rock (Mancos shale). In places, however, it contains so much salt that good yields cannot be obtained. Some large areas are so strongly saline they cannot be used for crops. Generally, this soil is without visible lime, but it is calcareous. In many places small white flecks or indistinct light-colored streaks or seams indicate that lime, gypsum, or salts are present.

Use and management.—About 80 percent of this soil is cultivated. The chief irrigated crops are alfalfa, corn, dry beans, sugar beets, small grains, and tomatoes and other truck crops. Where the soil is located so as to avoid frost damage, tree fruits are grown.

Most of the field crops are grown in the central and western parts of the valley, or from Grand Junction westward. The entire acreage in tree fruits—approximately 3 square miles—lies between Grand Junction and Palisade. Because the climate is more favorable near Palisade, the acreage in orchard fruits is greater there. A few small orchards are located northeast of Grand Junction in the direction of Clifton. The main fruit acreage is between Clifton and Palisade. Peach orchards predominate, but a considerable acreage is in pears, especially near Clifton. Yields depend on the age of the trees and other factors, including management, but the estimated potential yield is somewhat less on this soil than on Mesa soils. This takes into account the slower internal drainage of this soil and its susceptibility to salinity if overirrigated. Yields of other crops vary according to the length of time the land has been irrigated, internal drainage or subdrainage, salt content of the soil, management practices, and local climate.

The uncultivated areas of this soil are mostly inaccessible places adjoining the larger washes, which occur mainly in the western part of the area, and those places that cannot be cropped profitably because they have inadequate drainage and a harmful concentration of salts. The uncultivated land supports a sparse growth of greasewood, saltbush, shadscale, rabbitbrush, ryegrass, peppergrass, and saltgrass. From 70 to 90 acres are required to pasture one animal during a season.

A number of places shown on the map by small marsh symbols are low and seepy. They could be ditched, but their acreage is likely too small to justify the expense. Left as they are, their salt content makes them worthless for any use except pasture.

Sizeable acreages of this soil apparently were overirrigated in the past. Irrigation water applied at higher levels to the north seeps upward in this soil where it occurs in low areas toward the river. Even now, new saline areas are appearing, and existing areas are getting larger. The total acreage affected by salts has remained more or less the same for the last two decades, but affected areas will continue to change in size and shape because of seepage.

Most fields are ditched where necessary. Some uncultivated areas require both leveling and ditching. In places subdrainage is inadequate because irregularities in the underlying shale tend to create pockets and prevent underground water from flowing into the drainage ditches. Also, in some areas where the alluvial mantle is 30 to 40 feet thick, the ditches are not always deep enough to drain the soil. Some areas are seepy because there are no ditches running in an east-west direction to intercept lateral flow of ground water from the over-

irrigated, permeable, medium-textured, stratified soils on the upper parts of the fan to the north. After being leveled, uncultivated areas would have to be cropped for 3 years before their salt content would be reduced enough to permit good yields.

Farmers can increase the organic-matter content of this soil by applying manure liberally and by growing alfalfa or clovers at least part of the time. A combination field crop and livestock type of farming favors improvement of this soil. Many of the small imperfectly drained areas may be kept in pasture. Strawberry clover and sweetclover are well suited, and mixtures of pasture grasses grow well.

Billings silty clay loam, 2 to 5 percent slopes (B_D).—This soil covers a relatively small acreage in the Grand Valley. The areas are widely scattered. Except for its stronger slope, the soil is almost the same as Billings silty clay loam, 0 to 2 percent slopes. In a few places, notably north of Loma, there are areas having a pale-yellow color rather than the gray typical of the Billings soils.

Use and management.—Only about 15 percent of this soil is cultivated. Many of the areas lie along large drainageways or washes where they are difficult to reach. Even a larger number have such an uneven surface that considerable leveling would have to be done before they could be cropped. The cost of leveling, together with the expense of controlling erosion and gullying, discourages farmers from using them.

Many of the uncultivated areas have moderate concentrations of salts, but they are not particularly difficult to reclaim because they border natural ditches or washes which afford free disposal of irrigation water. Furthermore, for the most part, they have a porous substratum.

About the same crops are grown on this soil as on Billings silty clay loam, 0 to 2 percent slopes. The average yields are approximately the same.

Billings silty clay, 0 to 2 percent slopes (B_A).—This soil, locally called heavy adobe, occurs well toward the Colorado River. It is on alluvial materials—4 to about 40 feet thick—that largely came from Mancos shale. Most of this soil lies east and southeast of Grand Junction and along the railroad between Grand Junction and Fruita.

The 8- or 10-inch surface soil consists of light brownish-gray, gray, or olive-gray silty clay. The layer is similar to the surface layer of Billings silty clay loam soils but it is harder and, in many places, darker. The subsoil consists of similarly colored layers of silty clay loam, silt loam, and silty clay. In places the soil is silty clay to depths exceeding 4 feet.

The entire profile is firm when moist and has a massive structure. The subsoil has many small irregularly shaped light-gray specks or indistinct mottles. Poorly defined light-colored streaks indicate the presence of lime, gypsum, or salts. The surface soil and subsoil are calcareous, the lime being well distributed. The fine texture of the soil greatly retards penetration of roots, moisture, and air.

Surface runoff is very slow to slow where the slope is less than 1 percent. Internal drainage is very slow because the subsoil is massive and very slowly permeable. Even with ample drainage ditches, the discharge of irrigation water is slow.

Tilth and workability are not good, because the soil has a fine texture and a low content of organic matter. Moreover, some fields contain areas 20 to 60 feet across that have excessive amounts of salts. Slick spots also occur. These salty areas and slick spots produce low or negligible yields of most crops and are extremely difficult to eliminate.

Use and management.—About 75 percent of this soil is cultivated. Most of the rest is affected by salts. Small grains, beans, sugar beets, and alfalfa are the chief crops. They yield less than on Billings silty clay loam, 0 to 2 percent slopes. Ordinarily, newly broken fields are cropped to oats or other small grains the first few seasons so that excess salts can be removed. Afterwards, if drainage is adequate, they may be planted to pinto beans, sugar beets, corn, or alfalfa. The very slow permeability of this soil makes it unsuitable for orchard crops. Also, it is located mainly in areas where the frost hazard is great. Probably the greater part of the irrigable acreage is used for sugar beets. Small grains, alfalfa, and pinto beans usually follow in the order named.

Billings silty clay, 2 to 5 percent slopes (B_B).—This soil is similar to Billings silty clay, 0 to 2 percent slopes. It differs mainly in having greater slopes and a slightly finer textured and darker gray surface soil. In places, below depths of 3 or 4 feet, the silty clay or clay material is light olive gray.

The tilth and workability are poor. Surface runoff is medium, and internal drainage is very slow. The soil is better suited to irrigation than most of the larger nearly level areas of Billings silty clay, 0 to 2 percent slopes, many of which are affected by salts. Approximately 12 acres of this soil is in peach orchards. All the rest is normally used for cultivated crops, principally corn, pinto beans, and alfalfa. This soil is suited to about the same crops as Billings silty clay, 0 to 2 percent slopes, but it generally produces better yields.

Billings silty clay, moderately deep over Green River soil material, 0 to 2 percent slopes (B_E).—This soil occurs on the outer margin of coalescing alluvial fans where 1 to 4½ feet of fine-textured deposits derived from shale overlies Green River soil materials.

Except for a few strips only a few rods wide that adjoin low-lying areas of Green River soils, this soil has not been altered by high overflows from the Colorado River. It is not likely that the main part of the soil will be covered by floodwaters from the Colorado River, as it lies well above the level of normal overflow.

Use and management.—About 85 percent of this soil is cultivated. The principal crops are alfalfa, corn, sugar beets, and pinto beans. A few peach orchards are on this soil near Clifton. Because the underlying strata are coarser, crops produce better on this soil than on most areas of the other Billings silty clay soils. Drainage and saline conditions have to be corrected before the soil will produce well.

Uncultivated acreages of this soil northwest of Grand Junction are saline, imperfectly drained, or both. Their tilth and workability are poor because they have a fine texture and a low content of organic matter.

comparatively sharp rises or undulations having slopes of more than 5 percent that extend 4 to 6 feet above the prevailing level or in small irregularly shaped bodies on relatively smooth topography. Wherever the areas of Chipeta soil occur, they are too small and too intricately associated with the Persayo soil to be mapped separately.

Use and management.—About 25 percent of this complex is cultivated, but practically all of it could be. The Chipeta soil is not difficult to level, but the expense of leveling and the isolated location of the areas have not favored development for irrigation and cropping. The kinds of crops grown, the management practiced, and the yields produced are approximately the same as for Persayo-Chipeta silty clay loams, 0 to 2 percent slopes.

Ravola clay loam, 0 to 2 percent slopes (RA).—This soil, the second most extensive in the area, has developed in material that consists largely of reworked Mancos shale but includes an appreciable amount of sandy alluvium from the higher Mesaverde formation. The surface of these deposits is relatively level, but the depth of the deposits ranges from 5 to 30 feet. The soil is associated with the Billings silty clay loams and the Ravola fine sandy loams. The most important areas are east, northeast, and southeast of Fruita, north and northwest of Palisade, and north and northwest of Clifton.

The soil is much like the Billings silty clay loams but more porous because it contains more fine sand, especially in the subsoil. Ordinarily, the 10- or 12-inch surface layer consists of light brownish-gray to very pale-brown light clay loam. The underlying layers vary from place to place in thickness and texture and become more sandy below depths of 4 to 5 feet. The range in the subsoil is from fine sandy loam to clay loam.

Small fragments of shale and sandstone are common from the surface downward and are especially noticeable in areas nearest the source of the soil material. The entire profile is calcareous and friable, so internal drainage is medium and development of plant roots is not restricted. The surface is smooth. Most areas are at slightly higher levels than the associated areas of Billings silty clay loams and therefore have better drainage and a lower content of salts. The soil, however, is slightly saline under native cover, and in places it has strongly saline spots and a high water table.

Use and management.—About 95 percent of this soil is cultivated. The chief crops are alfalfa, corn, pinto beans, small grains, and, where climate is favorable, orchard fruits. Practically all the acreage used for tree fruits is near Clifton and Palisade. The acreage used for field crops varies from year to year, but by rough estimate about 30 percent is cropped to corn, 25 percent to alfalfa, 15 percent to pinto beans, 13 percent to orchard fruits, 10 percent to small grains, and the rest to sugar beets, tame hay, tomatoes, and various vegetable crops.

In general, the tilth and workability of this soil are favorable. The content of organic matter is generally less than 1 percent, but many farmers are improving the supply by growing more alfalfa and by using other improved management.

Ravola clay loam, 2 to 5 percent slopes (RB).—This soil differs from Ravola clay loam, 0 to 2 percent slopes, mainly in having greater slopes. Although the combined areas total only seven-tenths of a square mile, this soil is important because the largest single area—

approximately 300 acres—is located southeast of Palisade in the Vinelands and is used for peach growing. The remaining areas, widely scattered over the valley, total about 150 acres and are of minor importance.

The large area occupies a position intermediate between the Green River soils and the higher Mesa soils. Its underlying gravel and stone strata consist not only of sandstone but also of granite, schist, basalt, and lava. Much of the lava was deposited by drainage from the southeast. This large area was included with the soil unit largely because its color was similar to that of the other soil areas. Not many years ago subdrainage became inadequate for existing tree fruits and it was not until a number of tile drains were laid, as deep as 7 to 8 feet in places, that subdrainage was corrected in parts of this particular area.

Use and management.—All of the large soil area is in peaches. On it peach yields average as high as in any section of the valley, primarily because the danger of frost damage is negligible. Some of the orchards are now more than 50 years old but have produced steadily and still yield more than 400 bushels an acre according to reports from local growers. About half of the small scattered areas are cultivated. They are used largely for field crops because climatic conditions are not so favorable for peach growing. In building up the organic matter content, the growing of legumes, application of manure in large amounts, and use of commercial fertilizer generally are practiced.

Ravola very fine sandy loam, 0 to 2 percent slopes (RE).—This extensive and important soil occurs either along washes or arroyas extending from the north or on broad coalescing alluvial fans. The alluvial material from which the soil has developed was derived from sandstone and shale and ranges from 4 to 20 feet deep. The principal areas of the soil are north and northwest of Grand Junction and north, northwest, and southwest of Fruita.

This soil is much like Ravola fine sandy loam, 0 to 2 percent slopes, but is generally more uniformly level. The texture is prevailingly very fine sandy loam, but the percentage of silt is noticeably higher in some places. A few small areas that have a loam texture are included.

The 10- or 12-inch surface layer consists of light brownish-gray to very pale-brown very fine sandy loam. In some places the underlying thin depositional layers vary only slightly in color or texture. In other places, especially near drainage courses, the layers are more variable and may grade to loam, silt loam, or fine sandy loam. Nevertheless, layers of very fine sandy loam are more numerous. Below depths of 4 to 5 feet, the texture is sandier, and at depths of 8 to 12 feet strata of loamy fine sand, gravel, and scattered sandstone rock are common.

Disseminated lime occurs from the surface downward. Owing to the friable consistence of the successive layers, the tilth, internal drainage, available supply of moisture for plants, permeability to plant roots, and other physical properties are favorable and assure a wide suitability range for crops. The organic-matter content, however, is low. The soil is slightly saline under native cover and has a few strongly saline spots. Occasionally the water table is high.

Use and management.—More than 99 percent of this soil is cultivated. The chief crops are alfalfa, corn, pinto beans, small grains,

and truck crops. Corn is planted on an estimated 35 percent of the area, alfalfa on 20 percent, beans on 20 percent, small grains on 10 percent, and potatoes, tomatoes, sugar beets, and irrigated pasture on the rest. The percentage of land planted to the various crops fluctuates considerably. Yields have been increased by using improved soil management, such as application of barnyard manure; the growing of clovers and alfalfa frequently after corn, potatoes, sugar beets, and other crops; and the more liberal use of treble superphosphate and mixed commercial fertilizer.

Ravola very fine sandy loam, 2 to 5 percent slopes (Rc).—This soil, of minor importance because of its limited extent, occurs chiefly in the northwestern part of the county. Except for greater slope, it is very similar to Ravola very fine sandy loam, 0 to 2 percent slopes. Most of it is not cultivated. If it were leveled and cultivated, it would need about the same management as Ravola very fine sandy loam, 0 to 2 percent slopes, and should produce approximately the same yields.

Ravola fine sandy loam, 0 to 2 percent slopes (Rc).—This soil, fairly important agriculturally, occurs mostly east, northeast, and north of Fruita. The soil-forming material is derived largely from sandstone but has some admixture of silt or finer sediments of shale origin.

The 10- or 12-inch surface layer consists of light brownish-gray, pale-brown, or very pale-brown fine sandy loam. The underlying depositional layers generally range from 1 to 3 inches thick; they may have a fine sandy loam, fine sandy clay, very fine sandy loam, or loam texture. The gradation in texture from one layer to another is almost imperceptible in some places, but fairly distinct in others. In most places the material below 4 feet is more sandy and slightly lighter grayish brown than that above.

The soil is calcareous from the surface downward, but the lime is not visible. Because the successive layers are friable, deep-rooted crops are well suited. Internal drainage is medium to rapid, and moisture relations are favorable. Though the organic-matter content is low, other physical properties are favorable and allow good tilth, good drainage, and moderate permeability for deep-rooted crops. The soil is slightly saline under native cover and strongly saline in a few spots. It is subject to an occasional high water table.

Use and management.—About 98 percent of this soil is cultivated. The most important field crops are potatoes, corn, alfalfa, and pinto beans. Comparatively smaller acreages are in sugar beets, small grains, and tomatoes, cucumbers, and other truck crops. An estimated 30 percent of the cultivated acreage is cropped to corn, 25 percent to alfalfa, 20 percent to potatoes, 15 percent to pinto beans, 5 percent to small grains, and the rest to truck crops, largely tomatoes.

The trend in recent years has been toward larger acreages of potatoes, tomatoes, and pinto beans. In earlier days, a considerable acreage was used for tree fruits, mainly pears. Severe blight, excessive cost of growing and marketing the fruit, and unsuitable climate have caused gradual conversion to field crops.

With proper management, this soil should remain productive indefinitely. Definite rotations normally are not followed. Frequently, alfalfa is grown 4 or 5 years, corn 1 or 2 years, then oats or wheat, and

finally pinto beans. Manure, if available, generally is applied to the corn crop. The most common fertilizer is treble superphosphate, applied at the rate of 100 to 150 pounds an acre for field crops and truck crops. Some potato growers use commercial fertilizer at the rate of about 150 pounds an acre.

Ravola fine sandy loam, 2 to 5 percent slopes (Rd).—Except for scattered areas totaling about 25 acres, most of this soil is in the Vinelands section east of Palisade. The soil-forming material is mostly local alluvium derived from shale and sandstone that has been brought down the drainage courses from the southeast. In areas east of Palisade a few scattered, rounded igneous gravel, cobbles, stones, and boulders in the lower subsoil indicate that there has been some admixture of sediments deposited in the past by the Colorado River.

The 10- or 12-inch surface layer is light brownish-gray or very pale-brown loam. The subsoil layers are similarly colored and dominantly of a fine sandy loam texture. Nevertheless, in places fine sandy loam, loam, and clay loam textures are represented in the subsoil. The soil is calcareous throughout. Although the organic-matter content is low, other physical properties insure good tilth, drainage, and permeability to deep-rooted crops. The soil is slightly saline under native cover and includes some strongly saline spots. Occasionally the water table is high.

Use and management.—Practically all of this soil is cultivated; deep-rooted crops are well suited. The two areas east of Palisade are in peach orchards and produce yields comparing favorably with those on Ravola clay loam soils in the same area. These two areas are small but valuable because they are located where the climate is ideal for tree fruits. The productivity of this soil, especially for orchard fruits, is practically the same as that of Mesa clay loam soils.

Ravola loam, 0 to 2 percent slopes (Re).—This soil is not extensive, but it is important agriculturally. It occupies relatively broad alluvial fans and flood plains along streams. It is at a slightly higher elevation than the bordering areas of Billings silty clay loam soils. It has developed in an alluvial deposit derived largely from Mancos shale and to lesser extent from the fine-grained sandstone of the Mesaverde formation. The soil is very similar to Ravola very fine sandy loam, 0 to 2 percent slopes, but it contains less very fine sand and a definitely larger amount of silt. In a number of small areas the texture approaches, or may be, a silt loam. From the Ravola clay loam soils, this soil differs in being coarser textured and not so gritty.

In the larger areas near Clifton, the 10- or 12-inch surface layer consists of light brownish-gray to pale-yellow, calcareous, heavy loam. The subsoil, similar to the surface soil in color, invariably contains a higher percentage of silt than the subsoil of the Ravola very fine sandy loams. Differences among the thin alluvial layers in the subsoil are almost imperceptible to depths of 3 to 4 feet. At depths greater than this, however, 1- to 3-inch layers of either silt or very fine sandy loam commonly occur among the more numerous layers of loam. The thin layers of silt or very fine sandy loam are most noticeable in the larger and broader areas west of Palisade.

Northeast of Fruita, northwest of Mack, and southeast and northeast of Loma, this soil consists of pale-yellow to light-gray surface

REFERENCES

TABLE "A-1"
INTENSITY-DURATION-FREQUENCY (IDF) TABLE

Time (min)	2-Year Intensity (in/hr)	100-Year Intensity (in/hr)	Time (min)	2-Year Intensity (in/hr)	100-Year Intensity (in/hr)
5	1.95	4.95	33	0.83	2.15
6	1.83	4.65	34	0.82	2.12
7	1.74	4.40	35	0.81	2.09
8	1.66	4.19	36	0.80	2.06
9	1.59	3.99	37	0.79	2.03
10	1.52	3.80	38	0.78	2.00
11	1.46	3.66	39	0.77	1.97
12	1.41	3.54	40	0.76	1.94
13	1.36	3.43	41	0.75	1.91
14	1.32	3.33	42	0.74	1.88
15	1.28	3.24	43	0.73	1.85
16	1.24	3.15	44	0.72	1.82
17	1.21	3.07	45	0.71	1.79
18	1.17	2.99	46	0.70	1.76
19	1.14	2.91	47	0.69	1.73
20	1.11	2.84	48	0.68	1.70
21	1.08	2.77	49	0.67	1.67
22	1.05	2.70	50	0.66	1.64
23	1.02	2.63	51	0.65	1.61
24	1.00	2.57	52	0.64	1.59
25	0.98	2.51	53	0.63	1.57
26	0.96	2.46	54	0.62	1.55
27	0.94	2.41	55	0.61	1.53
28	0.92	2.36	56	0.60	1.51
29	0.90	2.31	57	0.59	1.49
30	0.88	2.27	58	0.58	1.47
31	0.86	2.23	59	0.57	1.45
32	0.84	2.19	60	0.56	1.43

Source: Mesa County 1991


LAND USE OR SURFACE CHARACTERISTICS	SCS HYDROLOGIC SOIL GROUP (SEE APPENDIX "C" FOR DESCRIPTIONS)											
	A			B			C			D		
	0-2%	2-6%	6%+	0-2%	2-6%	6%+	0-2%	2-6%	6%+	0-2%	2-6%	6%+
UNDEVELOPED AREAS Bare ground	.10 - .20	.16 - .26	.25 - .35	.14 - .22	.22 - .30	.30 - .38	.20 - .28	.28 - .36	.36 - .44	.24 - .32	.30 - .38	.40 - .48
	.14 - .24	.22 - .32	.30 - .40	.20 - .28	.28 - .36	.37 - .45	.26 - .34	.35 - .43	.40 - .48	.30 - .38	.40 - .48	.50 - .58
Cultivated/Agricultural	.08 - .18	.13 - .23	.16 - .26	.11 - .19	.15 - .23	.21 - .29	.14 - .22	.19 - .27	.26 - .34	.18 - .26	.23 - .31	.31 - .39
	.14 - .24	.18 - .28	.22 - .32	.16 - .24	.21 - .29	.28 - .36	.20 - .28	.25 - .33	.34 - .42	.24 - .32	.29 - .37	.41 - .49
Pasture	.12 - .22	.20 - .30	.30 - .40	.18 - .26	.28 - .36	.37 - .45	.24 - .32	.34 - .42	.44 - .52	.30 - .38	.40 - .48	.50 - .58
	.15 - .25	.25 - .35	.37 - .47	.23 - .31	.34 - .42	.45 - .53	.30 - .38	.42 - .50	.52 - .60	.37 - .45	.50 - .58	.62 - .70
Meadow	.10 - .20	.16 - .26	.25 - .35	.14 - .22	.22 - .30	.30 - .38	.20 - .28	.28 - .36	.36 - .44	.24 - .32	.30 - .38	.40 - .48
	.14 - .24	.22 - .32	.30 - .40	.20 - .28	.28 - .36	.37 - .45	.26 - .34	.35 - .43	.44 - .52	.30 - .38	.40 - .48	.50 - .58
Forest	.05 - .15	.08 - .18	.11 - .21	.08 - .16	.11 - .19	.14 - .22	.10 - .18	.13 - .21	.16 - .24	.12 - .20	.16 - .24	.20 - .28
	.08 - .18	.11 - .21	.14 - .24	.10 - .18	.14 - .22	.18 - .26	.12 - .20	.16 - .24	.20 - .28	.15 - .23	.20 - .28	.25 - .33
RESIDENTIAL AREAS 1/8 acre per unit	.40 - .50	.43 - .53	.46 - .56	.42 - .50	.45 - .53	.50 - .58	.45 - .53	.48 - .56	.53 - .61	.48 - .56	.51 - .59	.57 - .65
	.48 - .58	.52 - .62	.55 - .65	.50 - .58	.54 - .62	.59 - .67	.53 - .61	.57 - .65	.64 - .72	.56 - .64	.60 - .68	.69 - .77
1/4 acre per unit	.27 - .37	.31 - .41	.34 - .44	.29 - .37	.34 - .42	.38 - .46	.32 - .40	.36 - .44	.41 - .49	.35 - .43	.39 - .47	.45 - .53
	.35 - .45	.39 - .49	.42 - .52	.38 - .46	.42 - .50	.47 - .55	.41 - .49	.45 - .53	.52 - .60	.43 - .51	.47 - .55	.57 - .65
1/3 acre per unit	.22 - .32	.26 - .36	.29 - .39	.25 - .33	.29 - .37	.33 - .41	.28 - .36	.32 - .40	.37 - .45	.31 - .39	.35 - .43	.42 - .50
	.31 - .41	.35 - .45	.38 - .48	.33 - .41	.38 - .46	.42 - .50	.36 - .44	.41 - .49	.48 - .56	.39 - .47	.43 - .51	.53 - .61
1/2 acre per unit	.16 - .26	.20 - .30	.24 - .34	.19 - .27	.23 - .31	.28 - .36	.22 - .30	.27 - .35	.32 - .40	.26 - .34	.30 - .38	.37 - .45
	.25 - .35	.29 - .39	.32 - .42	.28 - .36	.32 - .40	.36 - .44	.31 - .39	.35 - .43	.42 - .50	.34 - .42	.38 - .46	.48 - .56
1 acre per unit	.14 - .24	.19 - .29	.22 - .32	.17 - .25	.21 - .29	.26 - .34	.20 - .28	.25 - .33	.31 - .39	.24 - .32	.29 - .37	.35 - .43
	.22 - .32	.26 - .36	.29 - .39	.24 - .32	.28 - .36	.34 - .42	.28 - .36	.32 - .40	.40 - .48	.31 - .39	.35 - .43	.46 - .54
MISC. SURFACES Pavement and roofs	.93	.94	.95	.93	.94	.95	.93	.94	.95	.93	.94	.95
	.95	.96	.97	.95	.96	.97	.95	.96	.97	.95	.96	.97
Traffic areas (soil and gravel)	.55 - .65	.60 - .70	.64 - .74	.60 - .68	.64 - .72	.67 - .75	.64 - .72	.67 - .75	.69 - .77	.72 - .80	.75 - .83	.77 - .85
	.65 - .70	.70 - .75	.74 - .79	.68 - .76	.72 - .80	.75 - .83	.72 - .80	.75 - .83	.77 - .85	.79 - .87	.82 - .90	.84 - .92
Green landscaping (lawns, parks)	.10 - .20	.16 - .26	.25 - .35	.14 - .22	.22 - .30	.30 - .38	.20 - .28	.28 - .36	.36 - .44	.24 - .32	.30 - .38	.40 - .48
	.14 - .24	.22 - .32	.30 - .40	.20 - .28	.28 - .36	.37 - .45	.26 - .34	.35 - .43	.42 - .52	.30 - .38	.40 - .48	.50 - .58
Non-green and gravel landscaping	.30 - .40	.36 - .46	.45 - .55	.45 - .55	.42 - .50	.50 - .58	.40 - .48	.48 - .56	.56 - .64	.44 - .52	.50 - .58	.60 - .68
	.34 - .44	.42 - .52	.50 - .60	.50 - .60	.48 - .56	.57 - .65	.46 - .54	.55 - .63	.64 - .72	.50 - .58	.60 - .68	.70 - .78
Cemeteries, playgrounds	.20 - .30	.26 - .36	.35 - .45	.35 - .45	.32 - .40	.40 - .48	.30 - .38	.38 - .44	.46 - .54	.34 - .42	.40 - .48	.50 - .58
	.24 - .34	.32 - .42	.40 - .50	.40 - .50	.38 - .46	.47 - .55	.36 - .44	.45 - .53	.54 - .62	.40 - .48	.50 - .58	.60 - .68

- NOTES: 1. Values above and below pertain to the 2-year and 100-year storms, respectively.
 2. The range of values provided allows for engineering judgement of site conditions such as basic shape, homogeneity of surface type, surface depression storage, and storm duration. In general, during shorter duration storms ($T_c \leq 10$ minutes), infiltration capacity is higher, allowing use of a "C" value in the low range. Conversely, for longer duration storms ($T_c > 30$ minutes), use a "C" value in the higher range.
 3. For residential development at less than 1/8 acre per unit or greater than 1 acre per unit, and also for commercial and industrial areas, use values under MISC SURFACES to estimate "C" value ranges for use.

RATIONAL METHOD RUNOFF COEFFICIENTS
 (Modified from Table 4, UC-Davis, which appears to be a modification of work done by Rawls)

TABLE "B-1"

REPRODUCED FROM FIGURE 15.2, SCS 1972

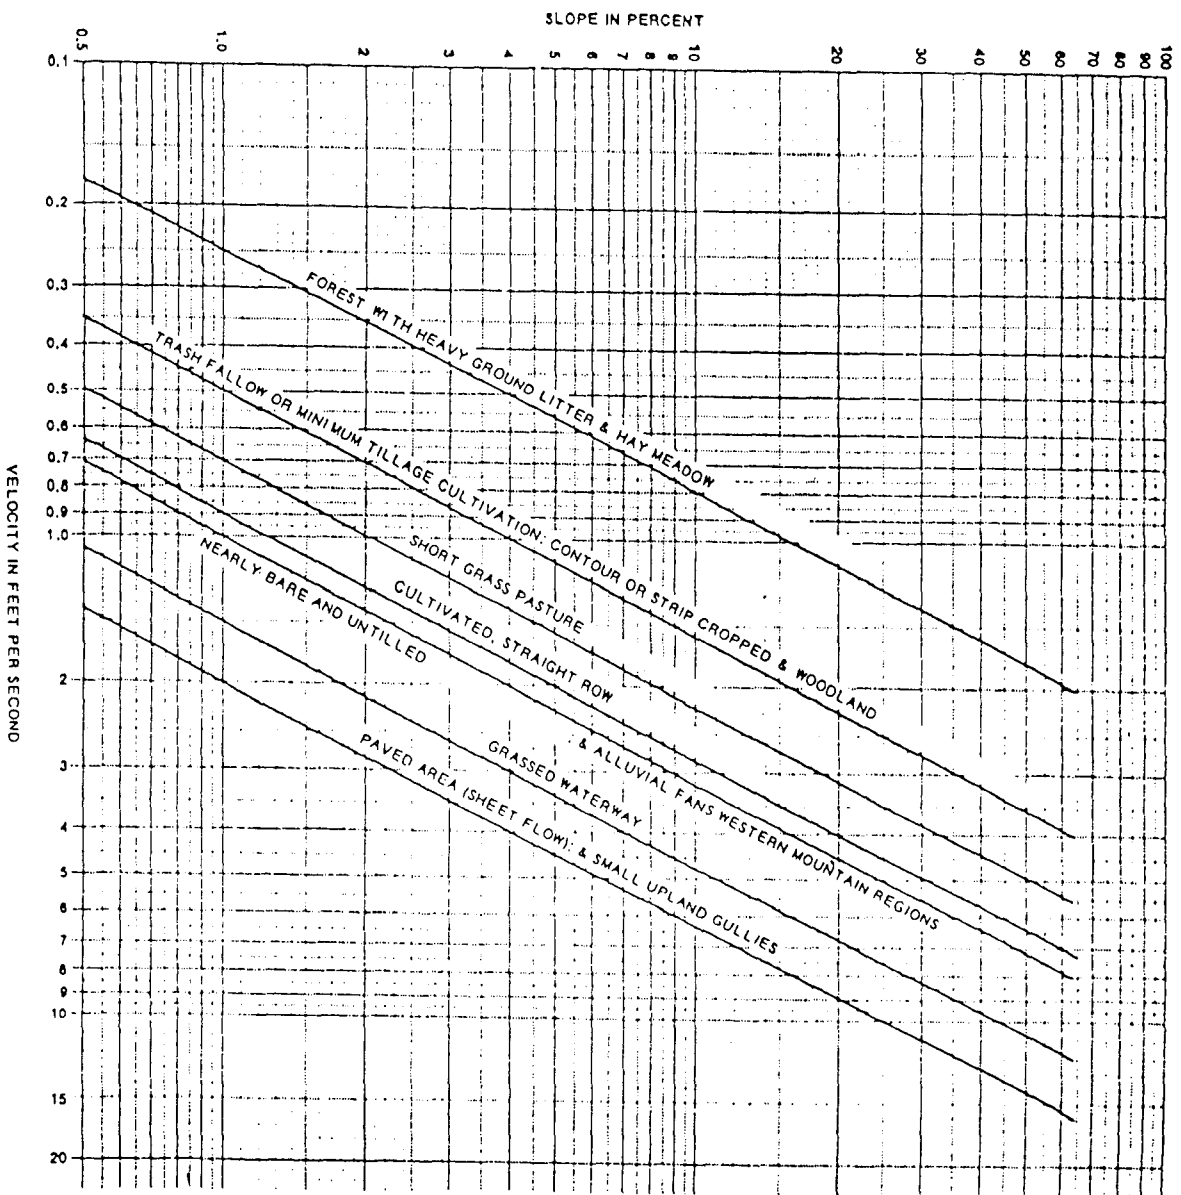

DETERMINATION OF "TS"

FIGURE "E-3"

ROAD TYPE	COMBINATION INLET CAPACITY (CFS)					
	SINGLE		DOUBLE		TRIPLE	
	2-YR	100-YR	2-YR	100-YR	2-YR	100-YR
Urban Residential (local)	6.4	13	9.5	22	12.7	31
Residential Collector, Commercial and Industrial Streets	3.2	13	4.9	22	6.5	31
Collector Streets (3000 - 8000 ADT)	2.7	13	4.0	22	5.3	31
Principal and Minor Arterials	6.0	13	9.0	22	12.0	31
<p>Inlet capacities shown above are based upon: 1) use of non-curved vane grates (similar to HEC-12 P-17$\frac{1}{8}$-4 grates; 2) HEC-12 procedures; 3) clogging factors per Section VI; and 4) City/County standard inlets with 2-inch radius on curb face and type C grates. Capacities shown for 2-year storms are based upon depths allowed by maximum street inundation per Figure "G-3". The 100-year capacities are based upon a ponded depth of 1.0 foot. Note that only combination inlets are allowed in sag or sump conditions.</p>						
<p>MAXIMUM INLET CAPACITIES: SUMP OR SAG CONDITION</p>					<p>TABLE "G-1"</p>	


Flow Chart for
Pipe Flowing Full

Coefficient of Flow
 $n = 0.009$

Derived from the MANNING Formula
 $v = \frac{1.486}{n} R^{2/3} S^{1/2}$

PVC Gravity Sewer Pipes have a
coefficient of $n = 0.009$. Their high
carrying capacities may often result

in the use of flatter grades or in the
use of smaller diameter pipe.

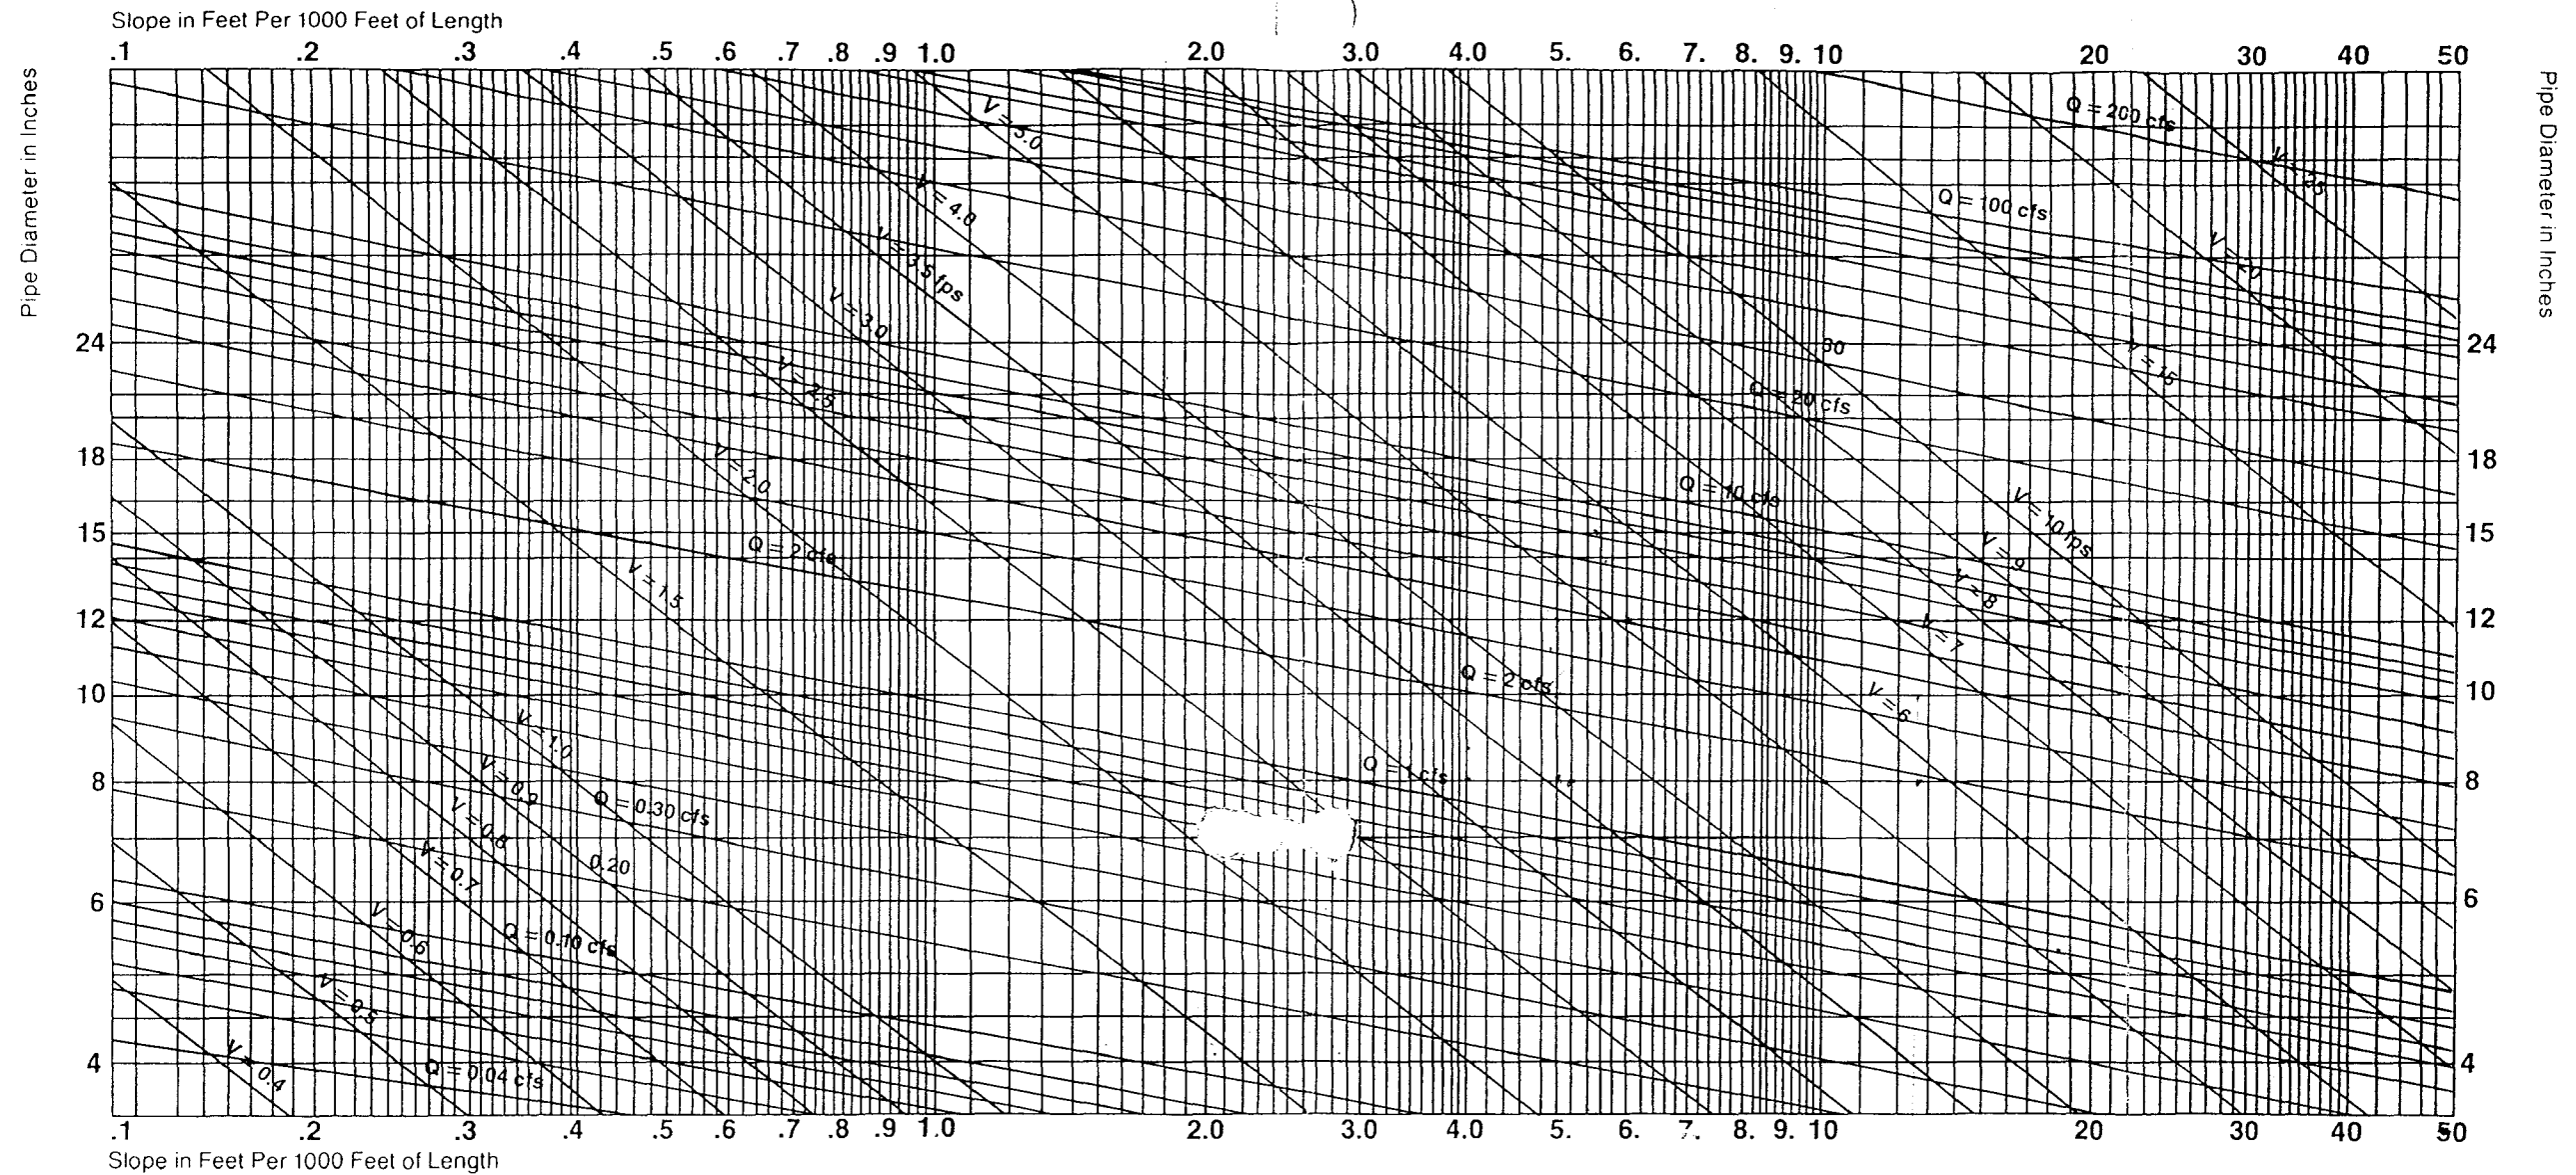

Conversion Chart
Table 1

Slope Values
Slope values derived from this chart are for coefficient of flow $n = 0.009$. They may be converted to slopes for other coefficients of flow by means of the following multiplying factors:

0.79 for $n = 0.008$	1.77 for $n = 0.012$
1.00 for $n = 0.009$	2.086 for $n = 0.013$
1.23 for $n = 0.010$	2.42 for $n = 0.014$
1.494 for $n = 0.011$	2.778 for $n = 0.015$

Conversion Chart
Table 2

Diameters
Diameters derived from this chart are for coefficient of flow $n = 0.009$. These may be converted to diameters for other coefficients of flow by means of the following multiplying factors:

0.956 for $n = 0.008$	1.114 for $n = 0.012$
1.000 for $n = 0.009$	1.147 for $n = 0.013$
1.040 for $n = 0.010$	1.180 for $n = 0.014$
1.078 for $n = 0.011$	1.211 for $n = 0.015$

Conversion Factors
CES, MGD, GPM

To convert cubic feet per second (cfs) to million gallons per day (MGD), multiply cfs by 0.646. To convert cubic feet per second (cfs) to gallons per minute, multiply cfs by 448.83.

One cubic foot of water = 7.48 gallons

Example 1

Assume:
Flow Coefficient $n = 0.009$
Length = 2800 ft.
Pipe Size = 8 inch
Elevations—Upstream = 215'-0"
Downstream = 213'-0"

Required:
1) Flow rate when flowing full
2) Velocity

Difference in elevation divided by length of pipe line equals slope in ft./ft. Multiplying by 1000 = slope 0.7 ft./1000 ft. Enter graph at 0.7 slope and also at 8 inch diameter pipe. At intersection, lines for velocity and flow rate also intersect. These give flow rate of 0.5 cu. ft. per second and velocity of 1.3 feet per second.

Example 2

Assume:
Flow Coefficient $n = 0.013$
Pipe Size = 8 inch
Flow rate = 0.5 cu. ft./sec.

Required:
Slope

First solve for slope based on flow coefficient $n = 0.009$, then multiply result by the correcting factor as follows: Enter graph at 8" diameter and at flow rate 0.5 cu. ft./sec. At intersection find slope 0.71 ft./1000 ft. Correcting factor for $n = 0.013$ is 2.086 (See Table 1). Multiply 0.71 by factor 2.086 for corrected slope of 1.481 ft./1000 ft. for $n = 0.013$.

(Must use approximately twice the slope)

Example 3

Assume:
Flow Coefficient $n = 0.013$
Slope = 0.7 ft./1000 ft.
Flow rate = 0.5 cu. ft./sec.

Required:
Pipe Size

First find pipe size for flow coefficient $n = 0.009$, then convert result as follows: Enter flow chart at 0.7 slope and also at flow rate 0.5 cu. ft./sec. At intersection also find pipe diameter 8". Converting factor for $n = 0.013$ is 1.147 (See Table 2). Multiply 8" x factor 1.147 for corrected pipe diameter = 9.17" (Must use next size larger.)

Example 4

Assume:
An 8-inch diameter pipe with $n = 0.009$ installed at a slope of 1.6 ft./1000 ft. will give a minimum full flow velocity of 2 fps and flow rate of 0.698 cfs.

Required:

What will be the flow rate and velocity if the pipe is flowing 3/10ths full?

At $Y/D = 0.3$ $V_p/V_f = 0.77$ and $Q_p/Q_f = .19$ from the hydraulic elements chart on cover. Therefore $V_p = .77 V_f$ or 1.54 fps and $Q_p = .19 Q_f$ or 0.132 cfs.

Kathy,

I have turned in the packets for the UTEC project. With regard to the fire department, I did give them a copy of the plans and specifications about ten days ago so one of the packets does not include said plans.

You did indicate that you would speed up this process and I am most appreciative of that. We hope to obtain our building permit Friday, September 27, 1996.

As we have not involved in this process in the past, please feel free to contact me if you need something else or you can give me direction in some area.

Again, because of the short time frame to have this project ready for the start of school next year, I am hopeful that everything will be in order.

Thank you for your time and effort.

Lou

UNIFIED TECHNICAL EDUCATION CAMPUS - PHASE II PROJECT
2508 Blichmann Ave.
Grand Junction, Colorado 81505

The Phase II UTEC project will consist of a building approximately forty thousand square feet(40,000s/f). Design and external materials will be similar to the current facility. Landscaping will also be consistent with the current facility and the guidelines established for Foresight.

Programs in the new structure include:

Culinary Arts	Computer Technology
Public Television	Bio-Health
CAD	Executive Development
Foods Incubator	Support Functions

Approximately two hundred students will be accommodated in the facility at any given time. Opening of the facility is scheduled for the 1997-98 school year. In addition to the current parking areas, new paved areas to accommodate 144 vehicles will be constructed. A new drive will be established on F1/2 road to access a new student parking area. This will alleviate a great deal of the traffic now occurring on Blichmann avenue. The current center parking area will be dedicated to visitor parking. Another area to the east of the new structure will be a new parking area for persons using the Public Television and Executive Development areas of the building.

As indicated in the building plans and specifications, drainage of the site has been addressed.

Total cost of the facility including construction, professional fees, utilities, fixed equipment and administrative costs is anticipated to be approximately \$3,550,000

Submitted by: Louis A. Grasso Jr.
Project Administrator.

REVIEW COMMENTS

Page 1 of 2

FILE #SPR-96-210

TITLE HEADING: UTEC Expansion

LOCATION: 2518 / 2520 Blichmann

PETITIONER: Mesa County Valley School District #51

PETITIONER'S ADDRESS/TELEPHONE: 2115 Grand Avenue
Grand Junction, CO 81501
245-2422 / 242-8500

PETITIONER'S REPRESENTATIVE: Lou Grasso

STAFF REPRESENTATIVE: Kathy Portner

NOTE: THE PETITIONER IS REQUIRED TO SUBMIT FOUR (4) COPIES OF WRITTEN RESPONSE AND REVISED DRAWINGS ADDRESSING ALL REVIEW COMMENTS.

CITY COMMUNITY DEVELOPMENT

10/3/96

Kathy Portner

244-1446

1. The plan must show the existing curb cuts on Blichman to be closed.
2. The landscaping plan must include a note indicating an underground, pressurized irrigation system will be provided for all landscaped areas.
3. A parking lot lighting plan must be provided as per section 5-5-1.F.2.i of the Zoning and Development Code.
4. Please show location and size of all proposed signage.
5. Please indicate the maximum number of employees using the facility at any given time. The parking requirement is one space per two students, plus one space for each employee.
6. The parking lot and street landscaping requirements are as follows (section 5-5-1.F):
 - a. one street tree for each 50' of street frontage.
 - b. a landscape barrier between the parking lot and the street is required to shield the lot from the street. The barrier cannot exceed 3 ½ feet in height at maturity, but must be at least 2 ½ feet at the time of planting. The barrier can be achieved either with plantings and/or berming.
 - c. the parking areas must provide a minimum of 5% of the net interior area as landscaping and must meet the requirements of 5-5-1.F.c of the Zoning and Development Code.

I suggest we set up a time to meet and discuss the comments. Please call our main number at 244-1430 to set up an appointment.

CITY DEVELOPMENT ENGINEER

10/1/96

Jody Kliska

244-1591

1. Access to F ½ Road will not be allowed. The new parking lot needs to connect with the existing lot for efficient and sensible site circulation.

2. The entrance to the east parking lot needs to be relocated east away from the street intersection and line up with the entrance to Refrigeration Industries.
3. Please show the existing curb cuts on the site plan. It appears several existing curb cuts will need to be closed and replaced with curb, gutter and sidewalk.
4. The Transportation Capacity Payment is calculated at \$25,740.00.
5. A permit from the City Engineer's office is required for any work in the public right of way.
6. The 15" storm sewer pipe running under the parking lot appears to have minimal cover. You may want to either use heavier pipe or increase the cover.

CITY FIRE DEPARTMENT

10/1/96

Hank Masterson

244-1414

If the proposed new building does not include an approved fire sprinkler system our requirements are:

1. Fire Department emergency vehicle access is required to within 150' of all exterior portions of the building. The existing site plan does not provide this access and must be revised.
2. On-site fire hydrants will be required and they must be located no more than 225' from required fire truck access. A fire hydrant is required at the north entrance to the site along F ½ Road. The total number of on-site hydrants required is three.
3. Fire flow requirements for a 40,000 square foot Type II one-hour building is 3,000 gallons per minute. The existing looped 8" fire line along Blichman will provide about 1800 gpm. Additional water supply must be provided-this can be accomplished by extending an 8" line west from 25 Road along F ½ Road to the north entrance to the site and supplying the required hydrant.

If the proposed building does include a complete fire sprinkler system:

1. The requirements for Fire Department access may be modified if the building is fully fire sprinkled-the Fire Department will accept the proposed site plan and the existing fire hydrants along Blichman as adequate for a fully sprinkled building.
2. The building type of construction can be Type II, non rated rather than Type II, One-hour.
3. The area separation wall can be eliminated.
4. The fire flow requirement for a fully sprinkled 40,000 square foot Type II, One-hour building is 1,100 gpm (fire flow can be reduced 75% in a sprinkled building). The number of required hydrants is one. The existing hydrants along Blichman are adequate and will provide the needed flows.

CITY UTILITY ENGINEER

10/3/96

Trent Prall

244-1590


CONTACT DAI TOSELLO AT THE PERSICO WASTEWATER TREATMENT PLANT FOR AN INDUSTRIAL WASTE REVIEW AT 244-1487,

SEWER PLANT INVESTMENT FEES APPEAR TO BE IN ORDER.

SEWER SERVICE LINE NOT SHOWN ON PLAN, IF LATERAL IS TO BE A 6" LINE A MANHOLE IS REQUIRED ON MAINLINE.

*NO FURTHER OBJECTIONS.
TCP*

Foresight Park

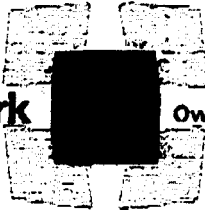

Owner & Tenants Association
P.O. Box 1509
604 25 Road
Grand Junction,
Colorado 81502

SPR-96-210

October 16, 1996

Mr. Lou Grasso
School District 51
2115 Grand Ave.
Grand Junction, CO 81501

Post-It™ brand fax transmittal memo 7671		# of pages > 2	
To	Ms. Kathy Portner	From	Bud Haupt
Co.	Comm. Dev. Dept.	Co.	POMA
Dept.		Phone #	241-4442
Fax #	244-1599	Fax #	241-3023

Re: Unified Technical Education Campus - Phase II project

Dear Mr. Grasso :

The Foresight Park Architectural Control Committee (ACC) has reviewed the plans you submitted for the above project. We have the following comments and suggestions:


- The drawings indicate an access road from F 1/2 Road that is 30 feet wide. While the covenants require access roads have a maximum width of 26 feet, the ACC has agreed to grant you this variance.
- The covenants require that up to 20% of a front yard can be devoted to parking. The plans indicate that over 20% of the front yard is used for parking. The ACC has reviewed this and agreed to grant you this variance.
- We suggest that consideration be given to providing an unloading strip of pavement off of Blichmann to allow safer and easier loading and unloading of students from buses (an insert in the street may be enough to remove the buses from traffic). This would be a safety measure to protect people popping out from behind a bus to cross a street. This is just a suggestion and not mandated by the committee.

Before giving our final approval, the committee needs to review the following additional information:

1. A detailed landscape plan has been submitted for the south area. Could you please provide this plan for the north?

RECEIVED GRAND JUNCTION
PLANNING DEPARTMENT

OCT 16 1996

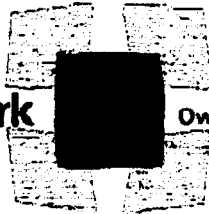Foresight Park

Owner & Tenants Association
P.O. Box 1509
604 25 Road
Grand Junction,
Colorado 81502

Mr. Lou Grasso
October 16, 1996
Page 2

2. What will be the maximum number of employees working at one time? We need this information to verify that the amount of parking conforms with the covenants.
3. We eventually need plans for proposed signs. While this is not needed immediately, we need to review plans for signs before they are installed.

If you have any questions, please contact me at 241-4442 or by fax at 241-3023. I look forward to receiving the requested information.

Sincerely,


Bud Haupt
President
Foresight Park Owners & Tenants Association

cc: Ms. Kathy Portner - via fax #244 - 1599
Community Development Department
250 No. 5th Street
Grand Junction, CO 81501

July 29, 1997

To: Community Development Department
250 N.5th st.,
Grand Junction, Colo. 81501

From: Lou Grasso
Mesa County Valley School District No. 51
2115 Grand Avenue,
Grand Junction, Colo. 81501

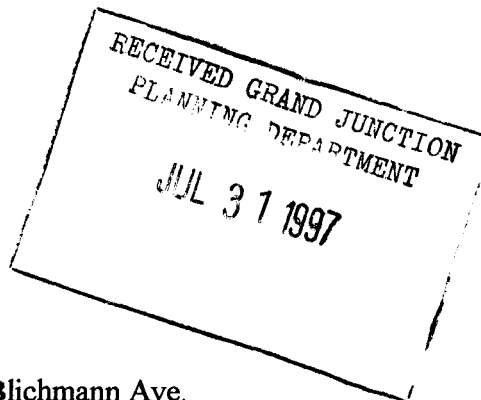

Subject: TCP fee for UTEC Phase II project: 2520 Blichmann Ave.

Please be advised that the invoice for the TCP fee in the amount of \$6,000.00 has been submitted to the purchasing department. You should receive payment within the next twenty days.

Thank you for your time and consideration in this matter. I feel the amount is an appropriate one.

Respectfully,

A handwritten signature in black ink, appearing to be "L. Grasso Jr.", written in a cursive style.

Louis A. Grasso Jr.

RESPONSE: REVIEW COMMENTS

UTEC EXPANSION

October 7, 1996

City Community Development-Kathy Portner

1. Propose to use the existing curb cut to the east for entry to the parking area and close the existing curb cut to the west by installing curb/gutter and sidewalk.
2. An underground irrigation system is planned for the landscaped areas. Control boxes are indicated on page P-10 of the project plans.
3. Parking lot lighting has been provided for in the plans. Please see page E.1.1.
4. Existing campus signage will be used.
5. It is anticipated that ten employees will be assigned to this facility at any given time. Please note that several of these employees are already on campus and working in the temporary units. Using a 200 student number and ten employees, 110 spaces are required. 144 spaces have been incorporated into the plan.
6. (a) and (b) will be provided for. For safety reasons we do not wish to include raised concrete areas in the interior areas of the parking lots. As you will note on the plans, the north area parking is only slightly visible from Blichmann Avenue.

City Development Engineer-Jody Kliska

1. We are requesting that the plan as presented be allowed. It is not efficient or safe to connect the new north area to the existing lot. If necessary we would sign the north area lot to indicate a "No Right Turn" when exiting the lot to prevent traffic from proceeding east on F ½ road.
2. Please see the response to #1 under City Community Development.
3. Please see the response to #1 under City Community Development.
4. We do not believe this fee should be charged to the project. **We are not a developer and we are not a commercial venture.**
5. This will occur.
6. This will be reviewed by our engineer.

City Fire Department-Hank Masterson

The building will include a fire sprinkler system. Plans and specifications with a 1,100gpm are now being developed and will be submitted to your office as soon as possible.

City Utility Engineer-Trent Prall

1. Mr. Tonello has submitted a clearance to the building department.
2. The sewer PIF has been paid to Ms. Jody Romero.
3. A manhole will be installed as requested.



DILLON-HUNT P.C.

ARCHITECTURE AND FACILITY MANAGEMENT

854 GRAND AVENUE
GRAND JUNCTION,
CO 81501
(970) 248-7383
(970) 248-7433 (FAX)

HLL ARCHITECTURE

1821 18TH STREET
8476, 110
DENVER, COLORADO 80202
(303) 295-1782
(303) 292-8437 (FAX)

APPROVED FOR CONSTRUCTION

CITY DEVELOPMENT ENGINEER

DATE 11-13-96

CITY UTILITY ENGINEER

DATE

ACCEPTED AS CONSTRUCTED

CITY DEVELOPMENT ENGINEER

DATE


CITY UTILITY ENGINEER

DATE



PROJECT NO. 9514
DATE 10-28-96
DRAWN BY
SCALE 1"=20'-0"
SHEET NO. 42x30

UNIFIED TECHNICAL
EDUCATION CAMPUS
PHASE II REVISED FIELD ORDER #3

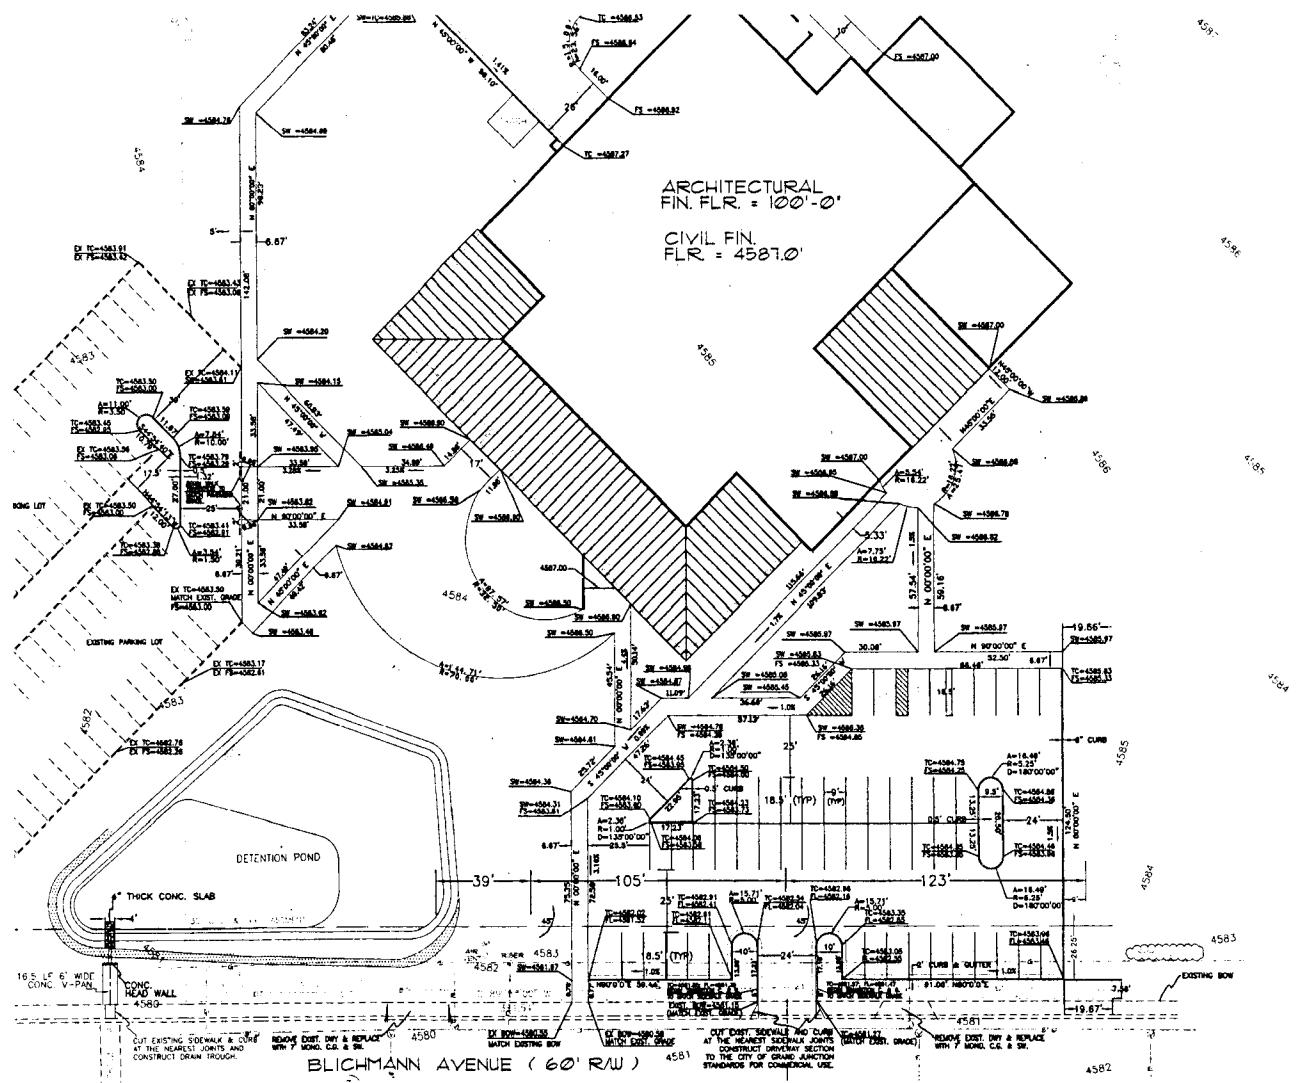

LEGENDS

- FL: FLOW LINE
- TC: TOP OF CURB
- SW: SIDEWALK
- FS: FINISHED SURFACE
- BT: BURIED TELEPHONE
- BE: BURIED ELECTRICAL
- IRR: IRRIGATION LINE
- G: GAS LINE
- W: WATER LINE
- V: VALVE

THICK CONC. SLAB
165 LF 6" WIDE CONC. V-PAN
CONC. WALL
MATCH EXIST. DRIVEWAY SECTION TO THE CITY OF GRAND JUNCTION STANDARDS FOR COMMERCIAL USE.
BLICHMANN AVENUE (60' R/W)

SHEET NO.
C12R

SPR. 1996-20



DILLON-HUNT P.C.

ARCHITECTURE AND FACILITY MANAGEMENT

804 GRAND AVENUE



PROJECT NO. 2214
DATE 10-28-96
BY 11-38
CHECKED BY





PROJECT NO. 2214
DATE 10-28-96
BY 11-38
CHECKED BY

UNIFIED TECHNICAL
EDUCATION CAMPUS
PHASE II REVISED FIELD ORDER #3

SHEET NO.
C1.3R
OF

W 1/4 COR.
S. 3715 R/W
UM

S 02°17'00" W
1307.76
BASIS OF BEARING

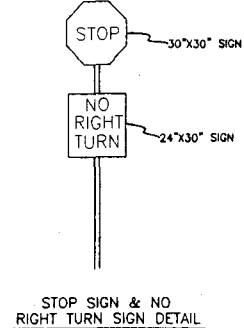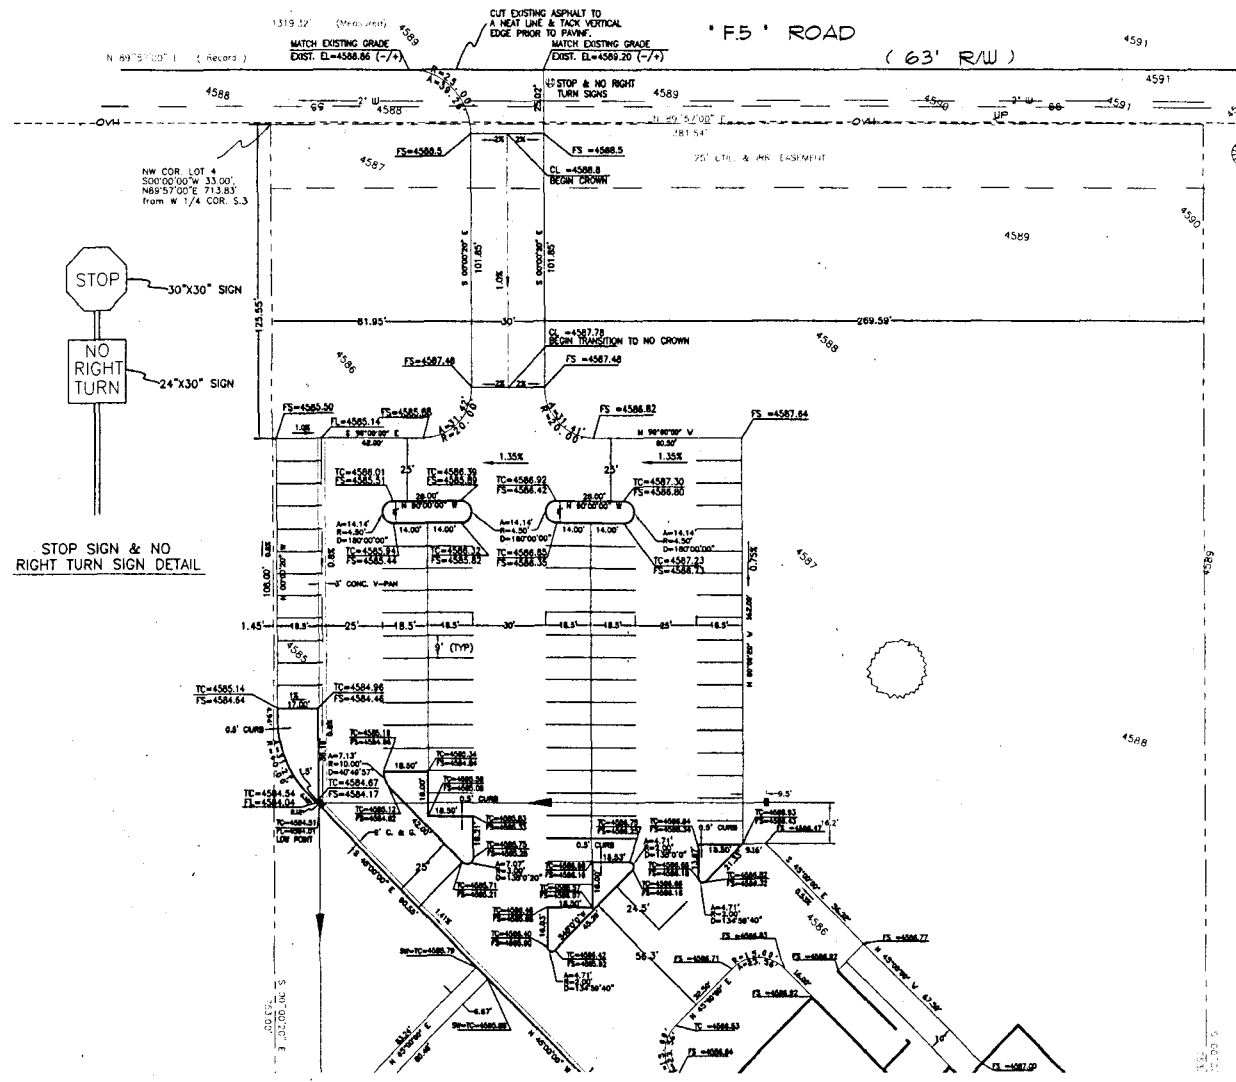

- LEGENDS
- FL: FLOW LINE
 - TC: TOP OF CURB
 - SW: SIDEWALK
 - FS: FINISHED SURFACE
 - OVH: OVERHEAD UTILITY LINE
 - SS: SANITARY SEWER
 - W: WATER LINE
 - UP: UTILITY POLE

APPROVED FOR CONSTRUCTION
CITY DEVELOPMENT ENGINEER
DATE _____
CITY UTILITY ENGINEER
DATE _____
ACCEPTED AS CONSTRUCTED
CITY DEVELOPMENT ENGINEER
DATE _____
CITY UTILITY ENGINEER
DATE _____




DILLON-HUNT P.C.
ARCHITECTURE
AND FACILITY
MANAGEMENT




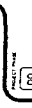

PROJECT NO. 10-28-20
DATE 11-13-16
SCALE 1" = 30'-0"
DRAWN BY J.H.H.
CHECKED BY J.H.H.

UNIFIED TECHNICAL
EDUCATION CAMPUS
PHASE II REVISED FIELD ORDER #3

SHEET NO.
C14R

SPR-1994-210




ACCEPTED AS CONSTRUCTED
CITY DEVELOPMENT ENGINEER
DATE
CITY UTILITY ENGINEER
DATE

APPROVED FOR CONSTRUCTION
CITY DEVELOPMENT ENGINEER
DATE 11-13-16
CITY UTILITY ENGINEER
DATE


- NOTES
1. THE CONTRACTOR SHALL BE RESPONSIBLE FOR OBTAINING ALL UTILITIES IN THE FIELD PRIOR TO PERFORMING ANY WORK AFFECTING THEM.
 2. ALL STORM SEWERS SHALL BE 30" DIA. PVC PIPE.
 3. STORM INLET AT 10 AND 15 SHALL BE SINGLE GRATE WITH CONCRETE BENCHING. INLET AT 21 AND 22 SHALL BE DOUBLE GRATE WITH CONCRETE BENCHING. STORM INLET, FRAMES AND INLET BENCHES SHALL BE CONCRETE.
 4. INLET BENCHES TO THE ARCHITECTURAL SITE PLANS ARE CONCRETE BENCHES.



FRAMES FOR SIDEWALKS DRAIN TROUGH

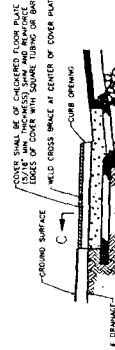

COVER SHALL BE OF CHECKERED FLOOR PLATE

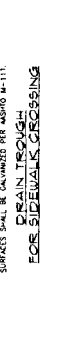


DRAIN TROUGH FOR SIDEWALKS CROSSING




FRAME AND COVER SHALL BE 1/2" x 1/2" x 1/2"

SIDEWALK CROSSING DETAILS
NOT TO SCALE

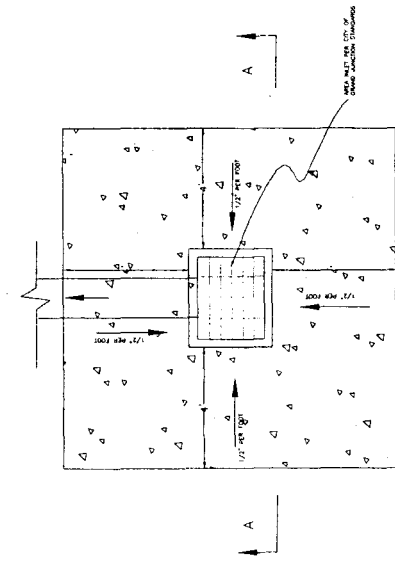


INLET #1 & #4 PLAN VIEW
NOT TO SCALE

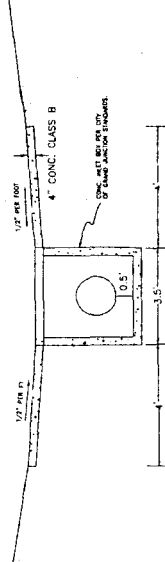

INLET A-A SECTION
NOT TO SCALE

AREA INLET DETAILS
NOT TO SCALE

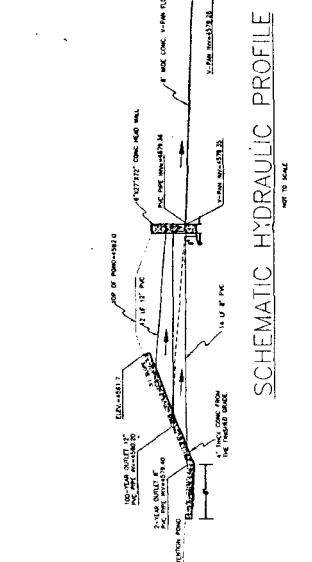

SCHEMATIC HYDRAULIC PROFILE
NOT TO SCALE




DILLON-HUNT P.C.
 ARCHITECTURE AND FACILITY MANAGEMENT
 804 GRAND AVENUE
 GRAND JUNCTION, CO 81501
 (970) 243-7365
 (970) 243-7437 (FAX)

HHL ARCHITECTURE
 1421 18TH STREET
 SUITE 110
 DENVER, COLORADO 80202
 (303) 292-1732
 (303) 292-6437 (FAX)

PROJECT NO. 9514
 DATE ISSUED 10-28-95
 DATE REVISION 11-18-95
 DRAWN BY WJ
 CHECKED BY WJ
 SCALE 1"=30'-0"
 SHEET NO. 42A30

UNIFIED TECHNICAL
 EDUCATION CAMPUS
 PHASE II REVISED FIELD ORDER #3

SHEET NO.
C1.1R

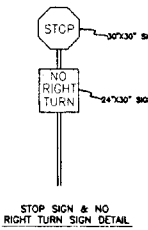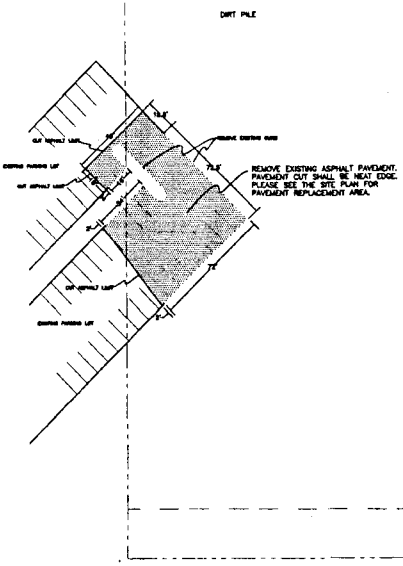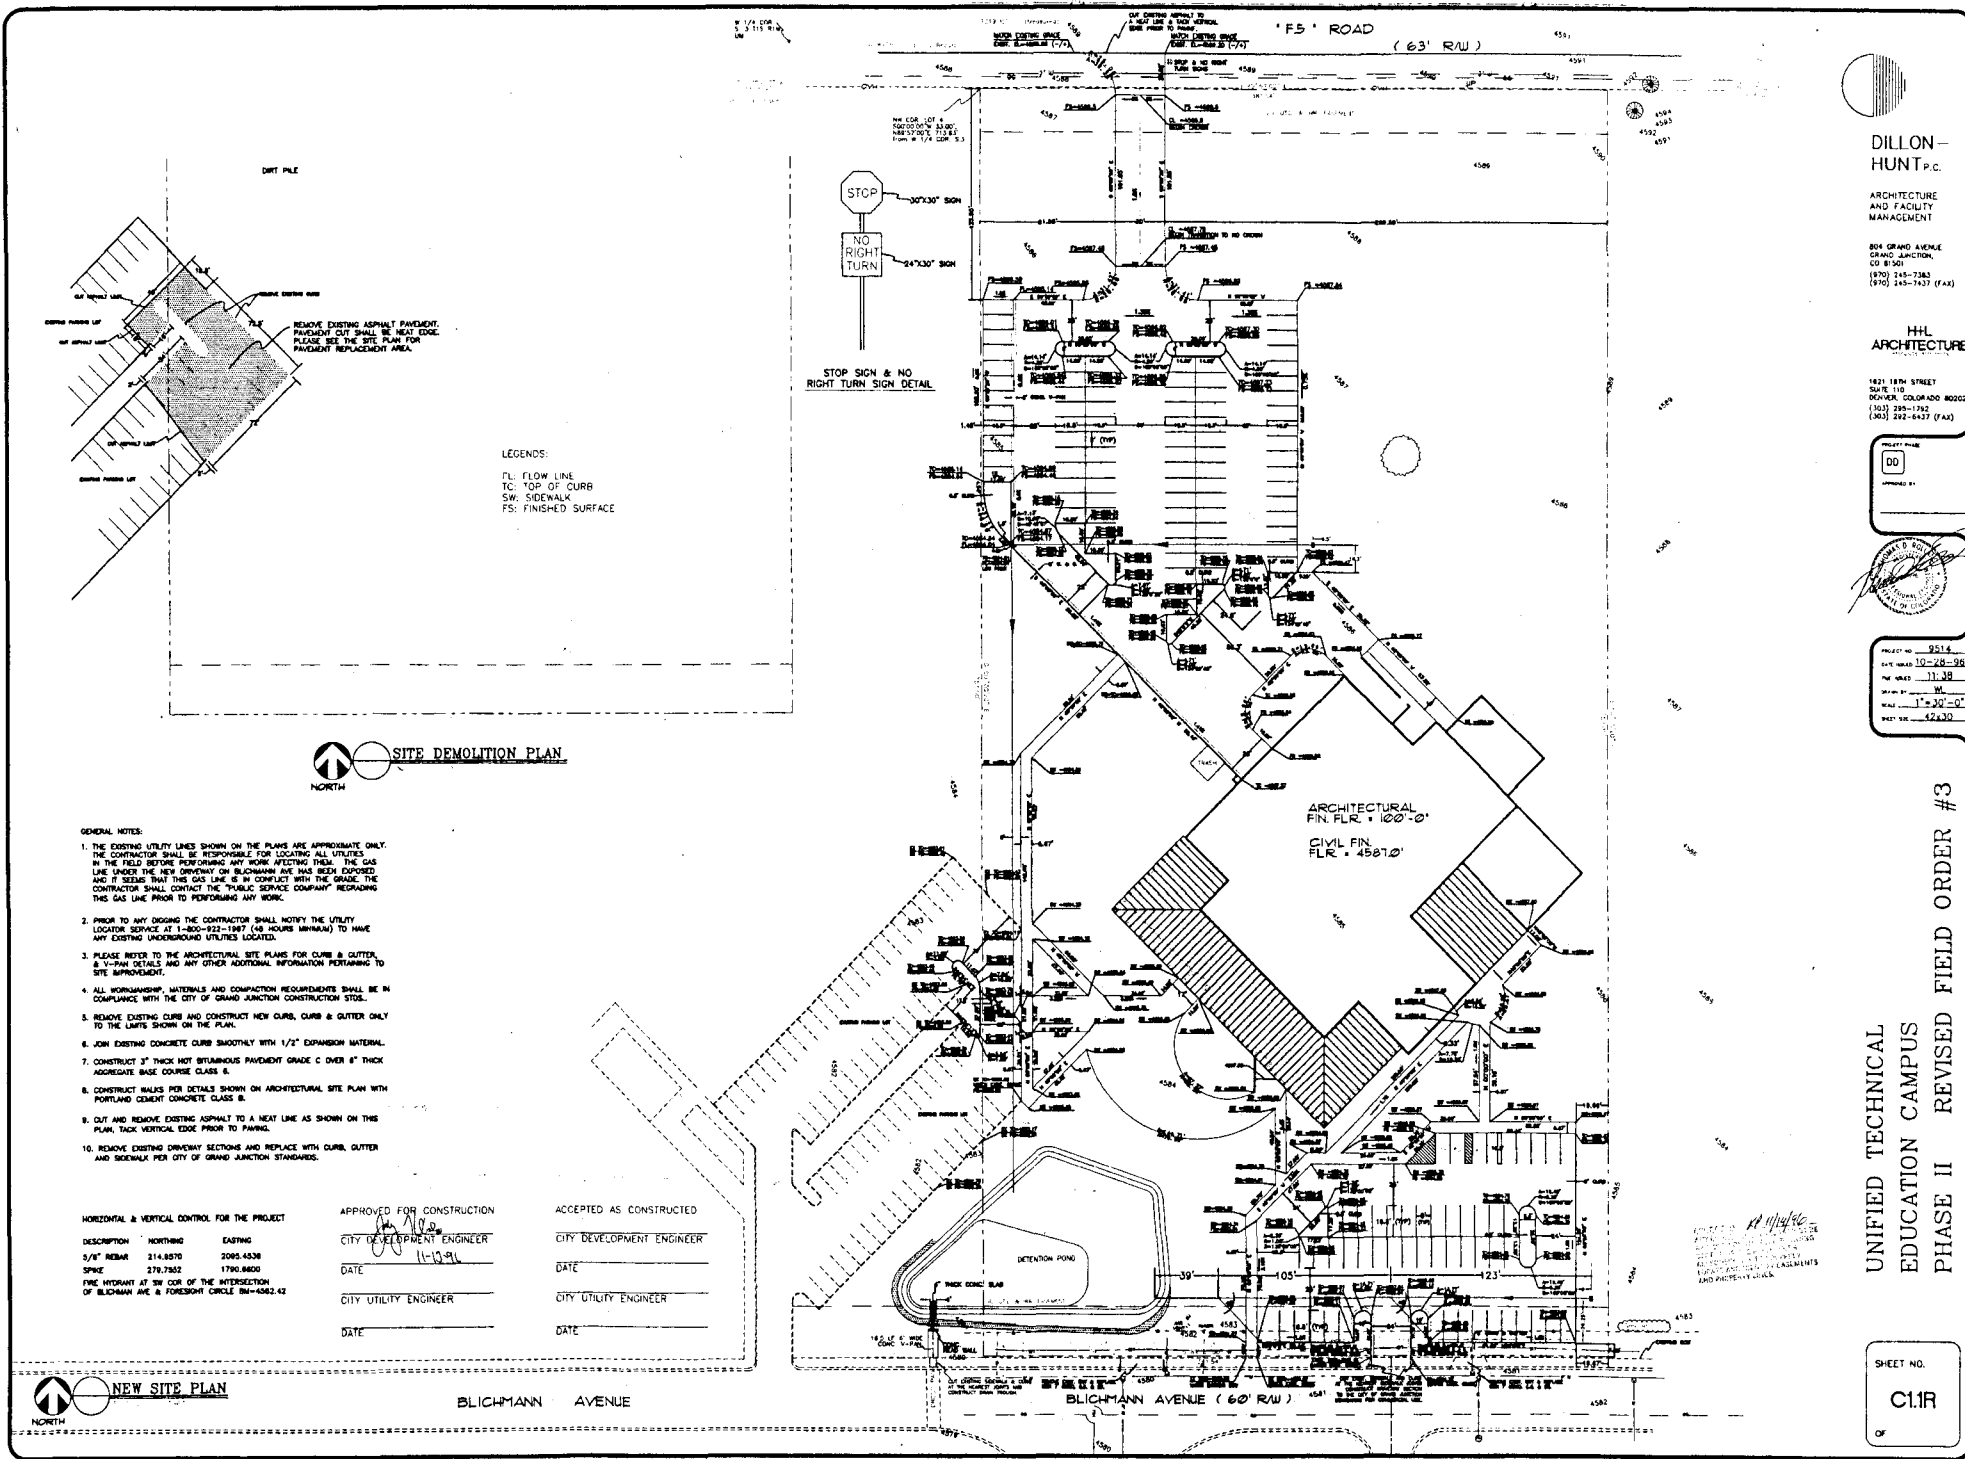

LEGENDS:
 FL: FLOW LINE
 TC: TOP OF CURB
 SW: SIDEWALK
 FS: FINISHED SURFACE

SITE DEMOLITION PLAN
 NORTH

- GENERAL NOTES:**
1. THE EXISTING UTILITY LINES SHOWN ON THE PLANS ARE APPROXIMATE ONLY. THE CONTRACTOR SHALL BE RESPONSIBLE FOR LOCATING ALL UTILITIES IN THE FIELD BEFORE PERFORMING ANY WORK AFFECTING THEM. THE GAS LINE UNDER THE NEW DRIVEWAY ON Blichmann Ave HAS BEEN EXPLORED AND IT SEEMS THAT THIS GAS LINE IS IN CONFLICT WITH THE GRADE. THE CONTRACTOR SHALL CONTACT THE "PUBLIC SERVICE COMPANY" REGARDING THIS GAS LINE PRIOR TO PERFORMING ANY WORK.
 2. PRIOR TO ANY DIGGING THE CONTRACTOR SHALL NOTIFY THE UTILITY LOCATOR SERVICE AT 1-800-922-1987 (48 HOURS MINIMUM) TO HAVE ANY EXISTING UNDERGROUND UTILITIES LOCATED.
 3. PLEASE REFER TO THE ARCHITECTURAL SITE PLANS FOR CURBS & GUTTERS & V-TURN DETAILS AND ANY OTHER ADDITIONAL INFORMATION PERTAINING TO SITE IMPROVEMENT.
 4. ALL WORKMANSHIP, MATERIALS AND COMPACTION REQUIREMENTS SHALL BE IN COMPLIANCE WITH THE CITY OF GRAND JUNCTION CONSTRUCTION SPEC.
 5. REMOVE EXISTING CURBS AND CONSTRUCT NEW CURBS, CURBS & GUTTER ONLY TO THE LIMITS SHOWN ON THE PLAN.
 6. JOIN EXISTING CONCRETE CURBS SMOOTHLY WITH 1/2" EXPANSION MATERIAL.
 7. CONSTRUCT 3" THICK HOT BITUMINOUS PAVEMENT GRADE C OVER 8" THICK AGGREGATE BASE COURSE CLASS B.
 8. CONSTRUCT WALKS FOR DETAILS SHOWN ON ARCHITECTURAL SITE PLAN WITH PORTLAND CEMENT CONCRETE CLASS B.
 9. CUT AND REMOVE EXISTING ASPHALT TO A NEAT LINE AS SHOWN ON THIS PLAN. TACK VERTICAL EDGE PRIOR TO PAVING.
 10. REMOVE EXISTING DRIVEWAY SECTIONS AND REPLACE WITH CURBS, GUTTER AND SIDEWALK PER CITY OF GRAND JUNCTION STANDARDS.

HORIZONTAL & VERTICAL CONTROL FOR THE PROJECT

DESCRIPTION	NORTHING	EASTING
5/8" REBAR	214.8570	2085.4530
SPIKE	279.7302	1790.4600

PRIC HEIGHT AT SW COR OF THE INTERSECTION OF Blichmann Ave & FORESHOULDER CIRCLE SW=4582.42

APPROVED FOR CONSTRUCTION
 CITY DEVELOPMENT ENGINEER
 DATE 11-19-95
 CITY UTILITY ENGINEER
 DATE

ACCEPTED AS CONSTRUCTED
 CITY DEVELOPMENT ENGINEER
 DATE
 CITY UTILITY ENGINEER
 DATE

NEW SITE PLAN
 NORTH


Blichmann Avenue

Blichmann Avenue (60' RAW)


APR 1996-210

UNIFIED TECHNICAL
EDUCATION CAMPUS
PHASE II

10-25-96
1" = 10'-0"

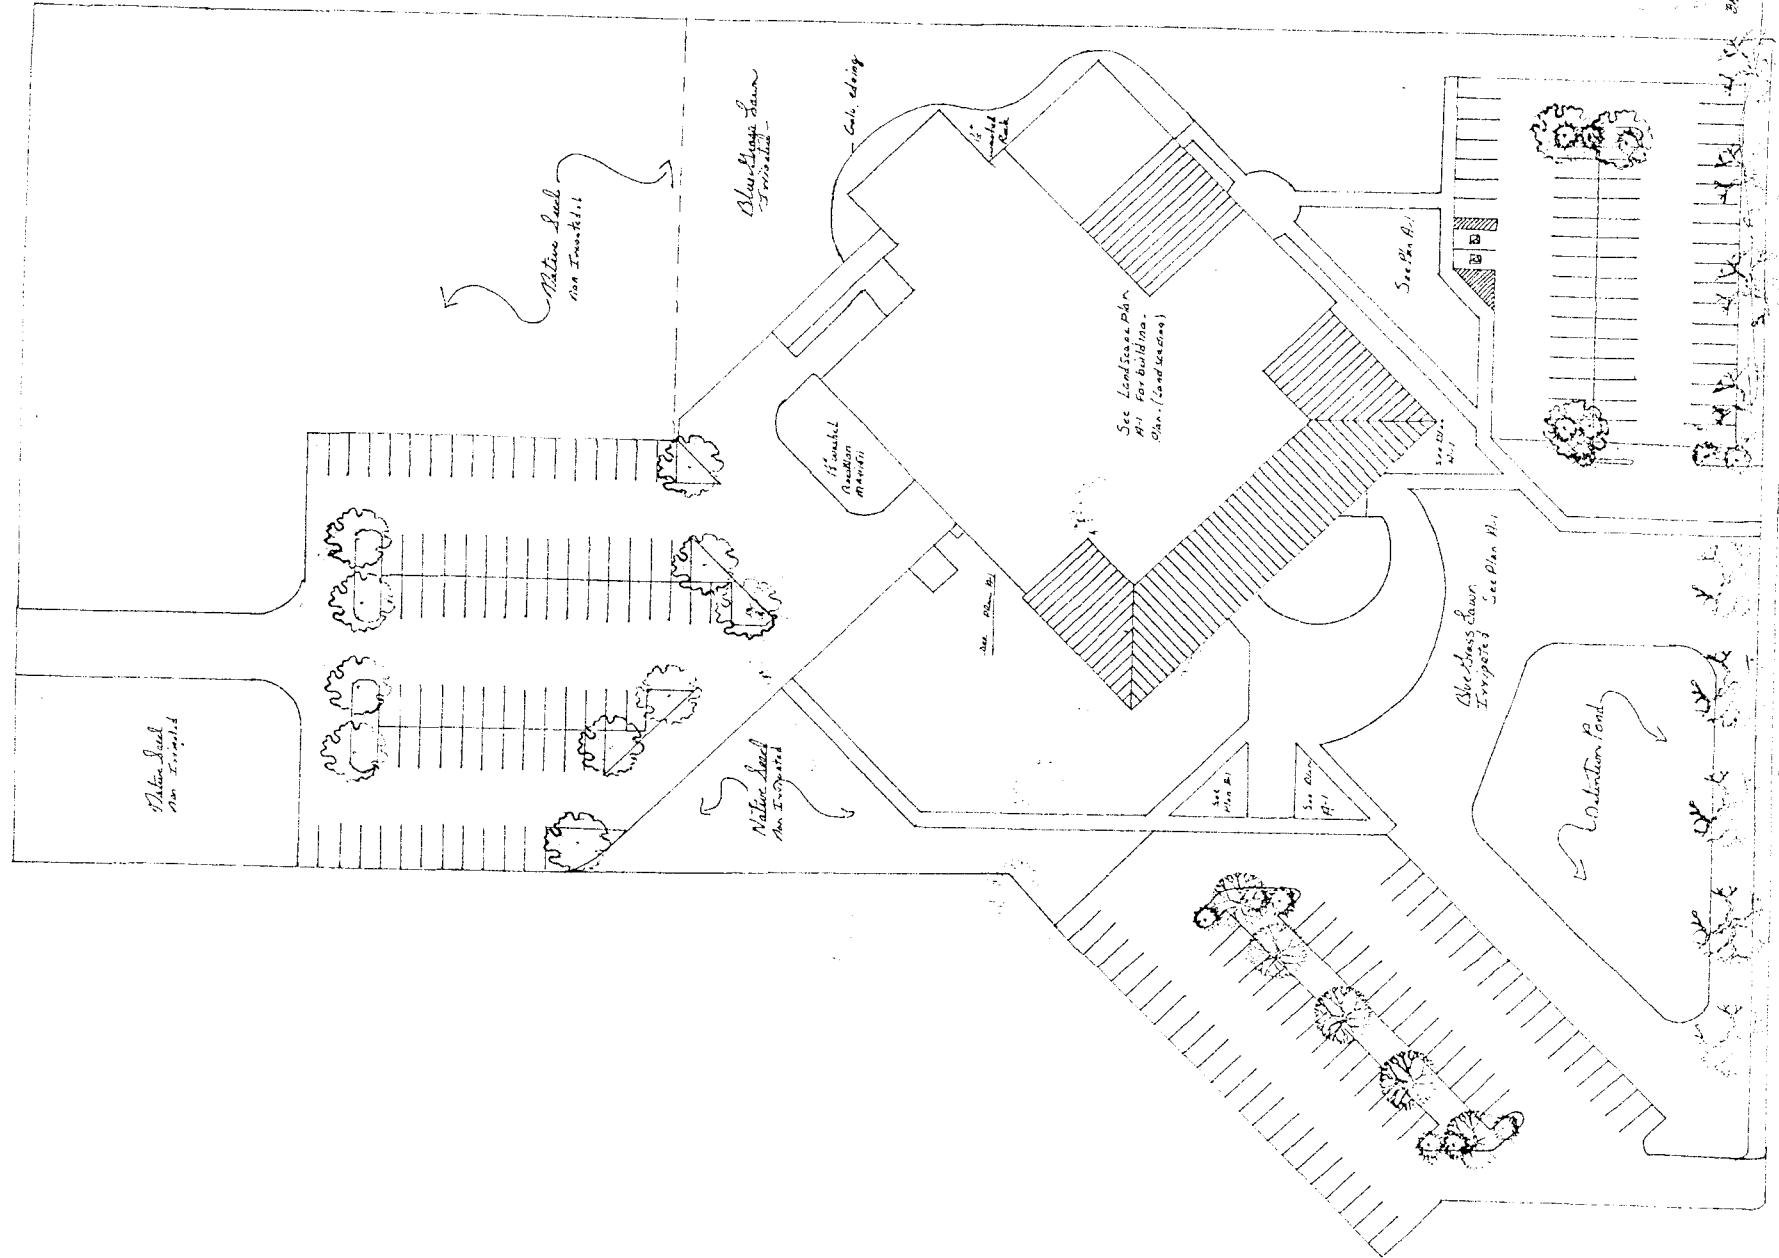


1	AP	AUSTRIAN TINE	PINUS NIGRA	6'	3" x 3"
1	BS	BLUE SPRUCE	PICEA PLUMBOS	6'	3" x 3"
2	APA	AUTUMN PURPLE ASH	FRAXINUS AMERICANA	12"	2" x 2"
6	SL	SHADE MASTER LOCUST	GLEDTISIA TRICANTHOS	2"	8" x 6"
6	SDS	SNOWDRIFT FLOWERING CRAB	MALUS SPP.	2"	2" x 2"
6	APF	NEW YORK FLOWERING TULIP	TRICHS CEMPERSA	1 1/2"	2" x 2"
12	MSA	MISCELLANEOUS SEEDLESS ASH	FRAXINUS TENNYSONIANA	1"	2" x 2"
10	MHG	MADONN CRAB	TRICHOPHYLLUS SIBENSIS	5 GAL.	
24	EMT	EMERALD JUNIPER	JUNIPERUS SABINA	5 GAL.	
6	ZMF	ZULU MIST SPREA	CARYOPHYLLUS X CLAUD	5 GAL.	
6	RTD	RED TWIG DOGWOOD	CORNUS SERICEA	5 GAL.	
5	FS	FORSYTHIA	SPYRACA EUMALZA	5 GAL.	
3	GV	GOLDEN VICARY	LIGUSTRUM X VICARYI	5 GAL.	

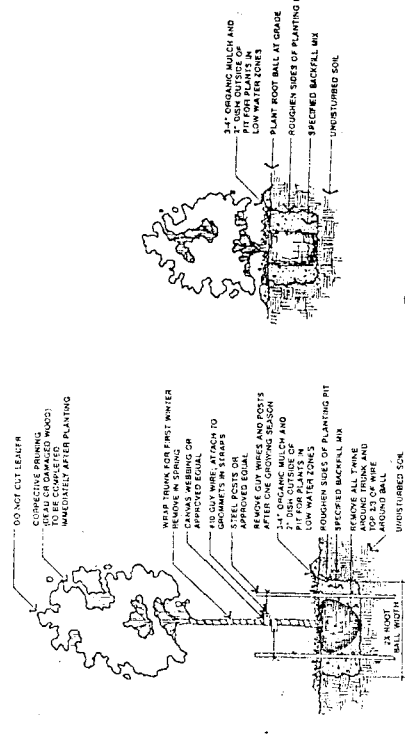




UNIFIED TECHNICAL
EDUCATION CAMPUS

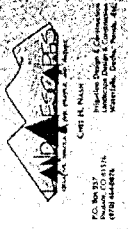


1	AP	Austrian Pine	Pinus nigra	6'	3 x 3
1	BS	Blue Spruce	Picea pungens	6'	3 x 3
2	APA	Autumn Purple Ash	Fraxinus americana	2"	3 x 3
6	SL	Shade Master Locust	Gleditsia triacanthos	2"	8 x 8
6	SDS	Shawdrift Flowering Dog	Mallus spp.	2"	3 x 3
6	APF	Newport Flowering Palm	Phoenix roebelfera	1 1/2"	3 x 3
12	MSA	Mitchell Seedless Ash	Fraxinus dummylamica	2"	8 x 8
10	MHG	Muirhen Gages	Miconia elaeagnis	5 Gal.	
3V	BZM	Bonanza Juniper	Juniperus sabina	5 Gal.	
6	ZMF	Blue Mist Spirea	Carolyopsis x clava	5 Gal.	
6	RTD	Red Twig Dogwood	Cornus sericea	5 Gal.	
5	FS	Fabril Spirea	Spirea bumalda	5 Gal.	
3	GV	Golden Viburnum	Ligustrum x vicaryi	5 Gal.	

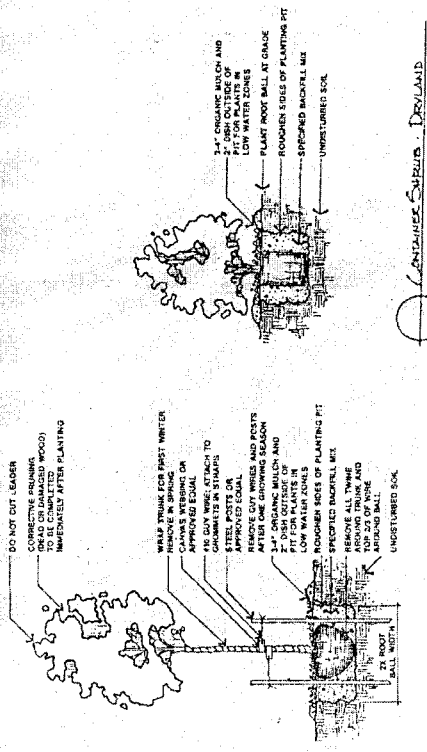




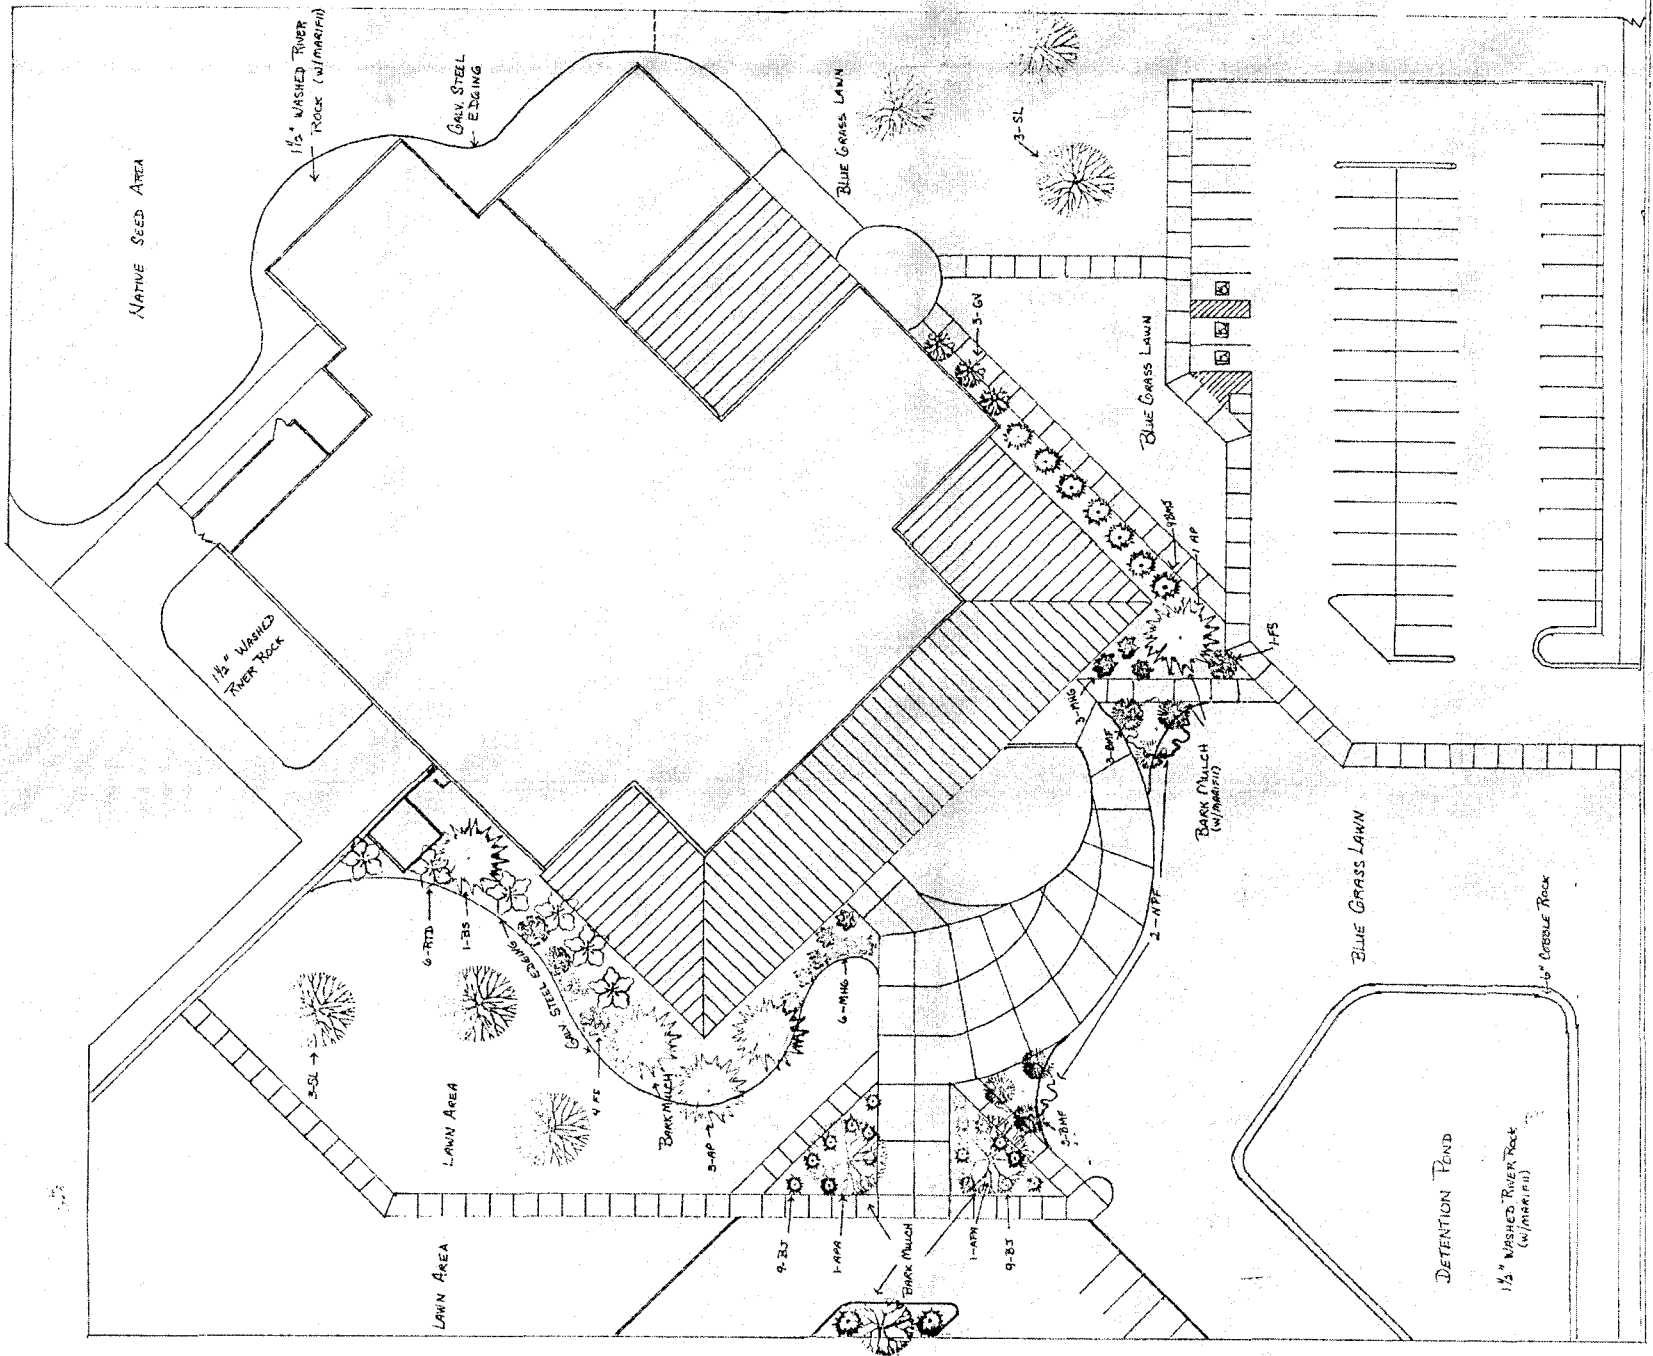

BLICHMANN AVENUE

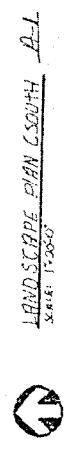

LANDSCAPE PLAN SOUTH A.I.
SERIES 17-2507

APPROVED FOR CONSTRUCTION
DATE: 12/15/07
BY: [Signature]

2 of 2

6/16/07-210