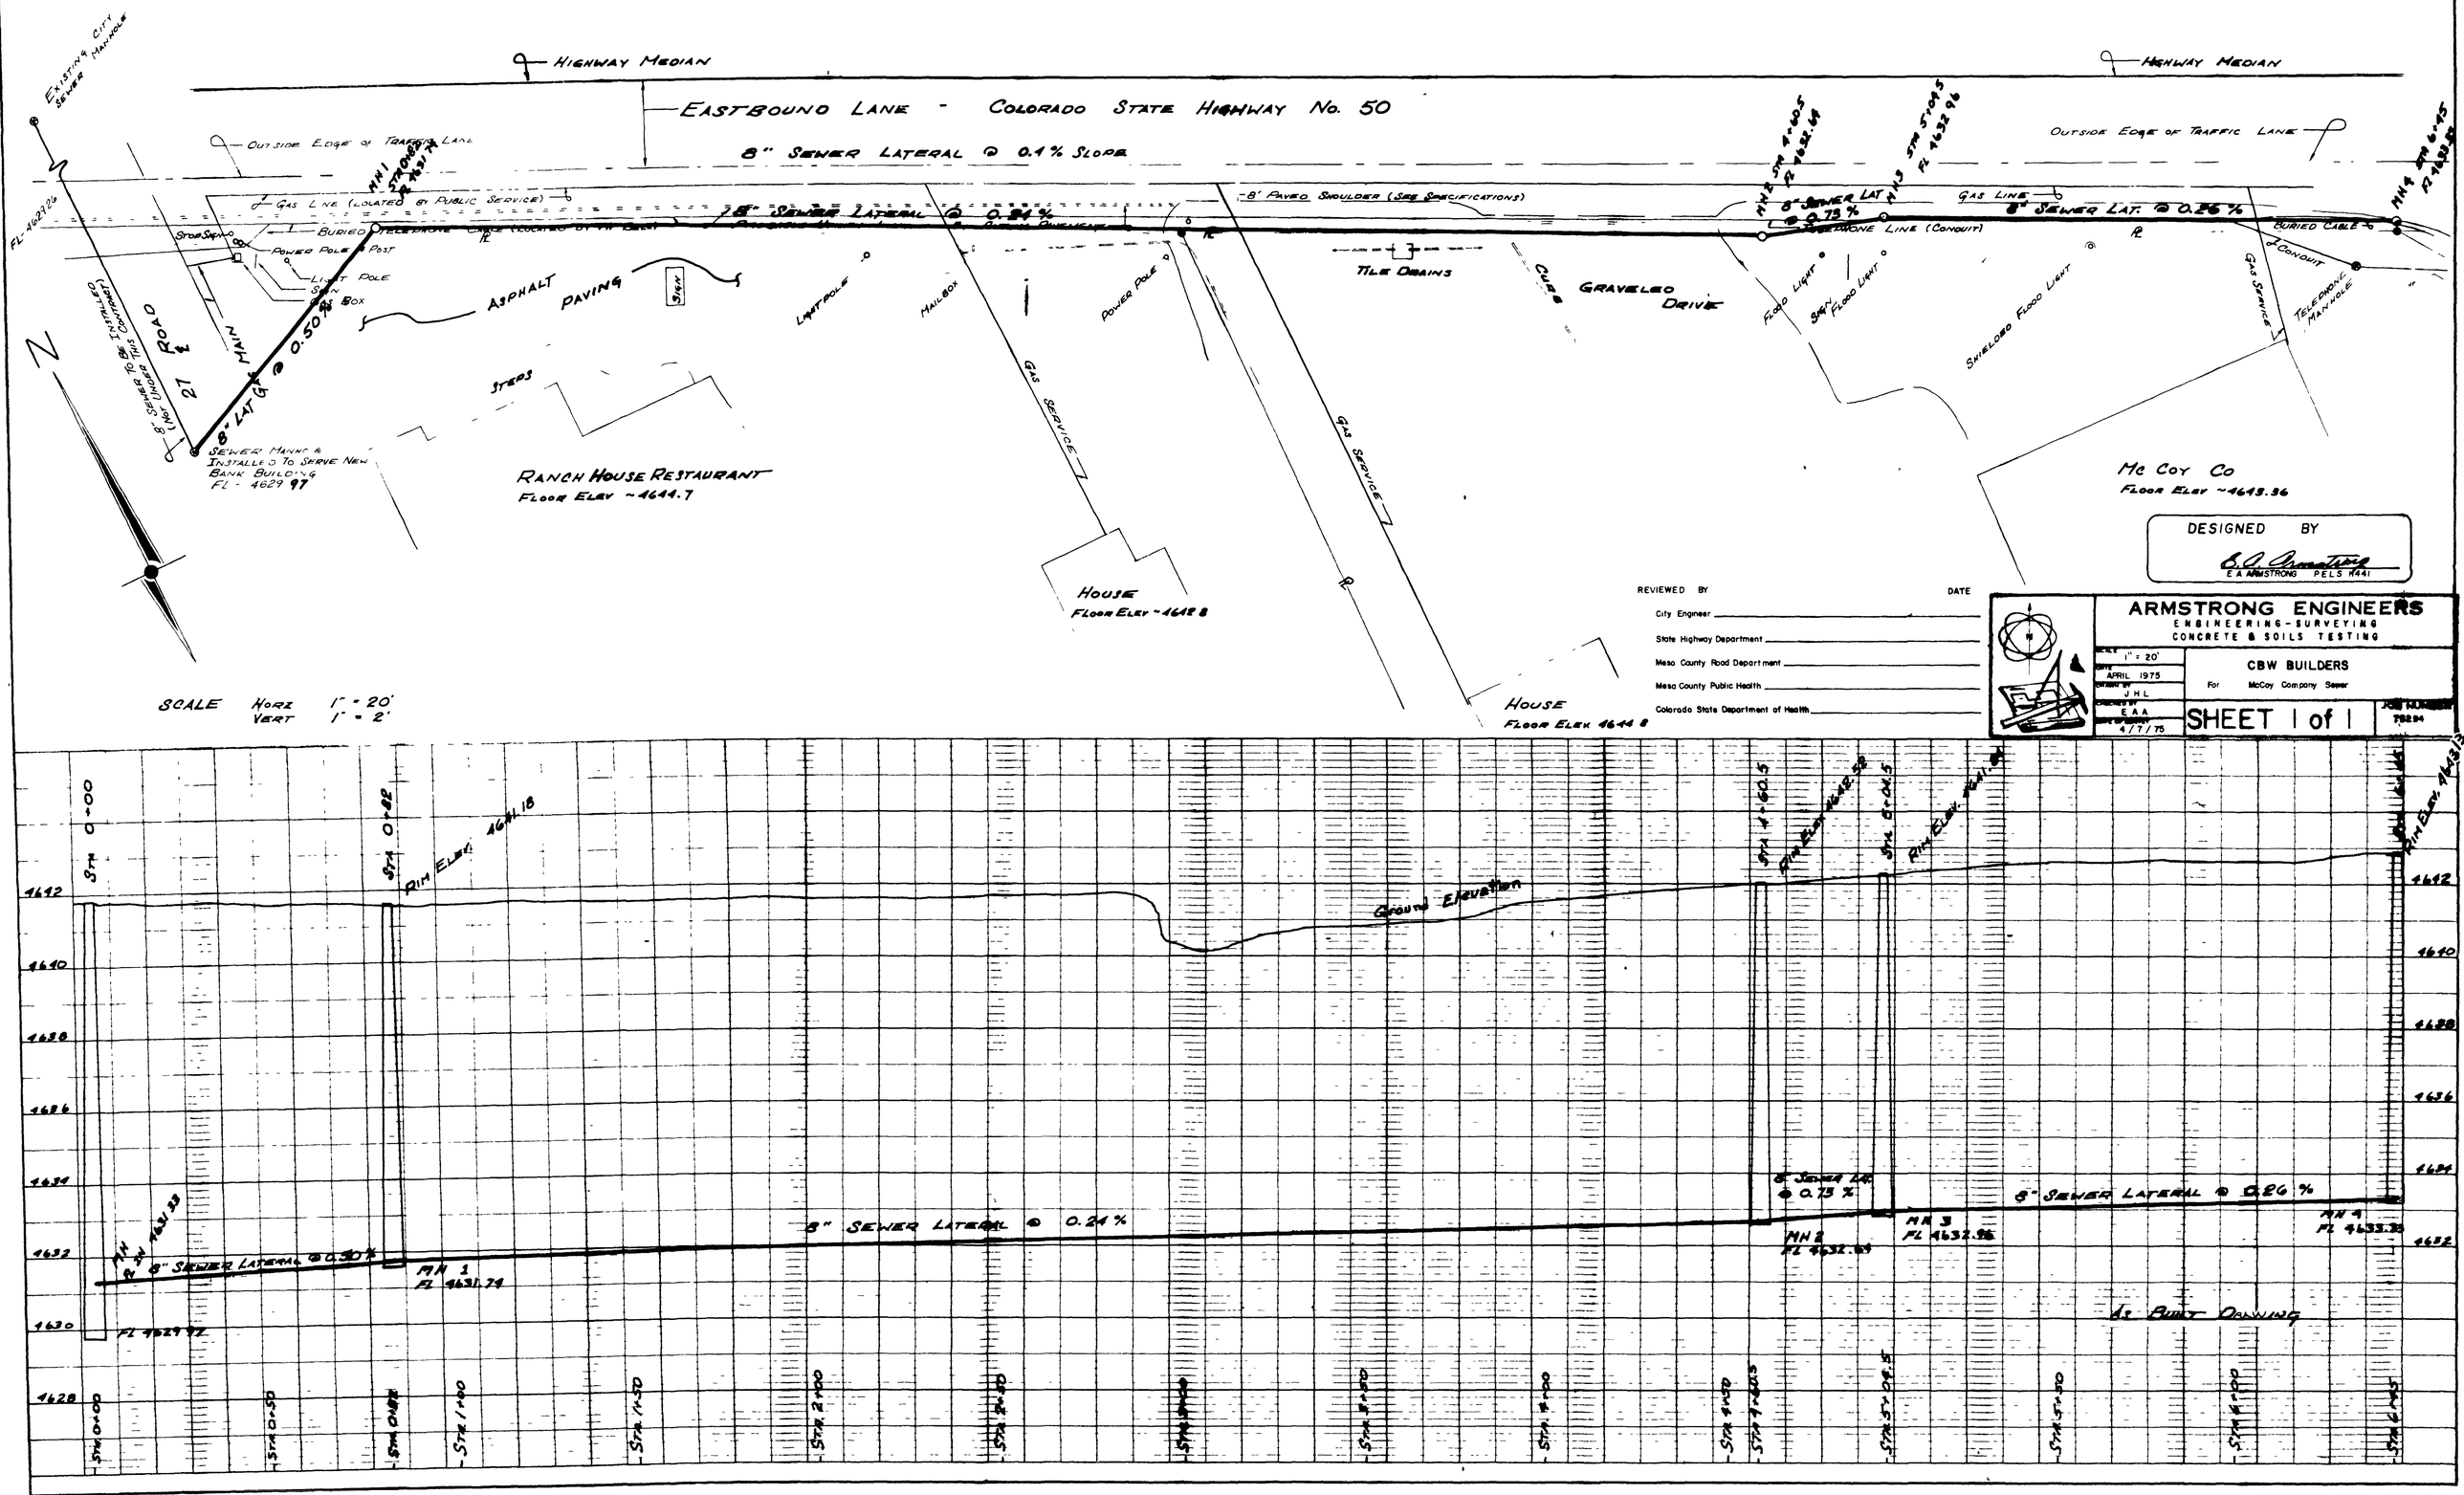

02010300.tif