DRAWING NUMBER

02-104

02-104

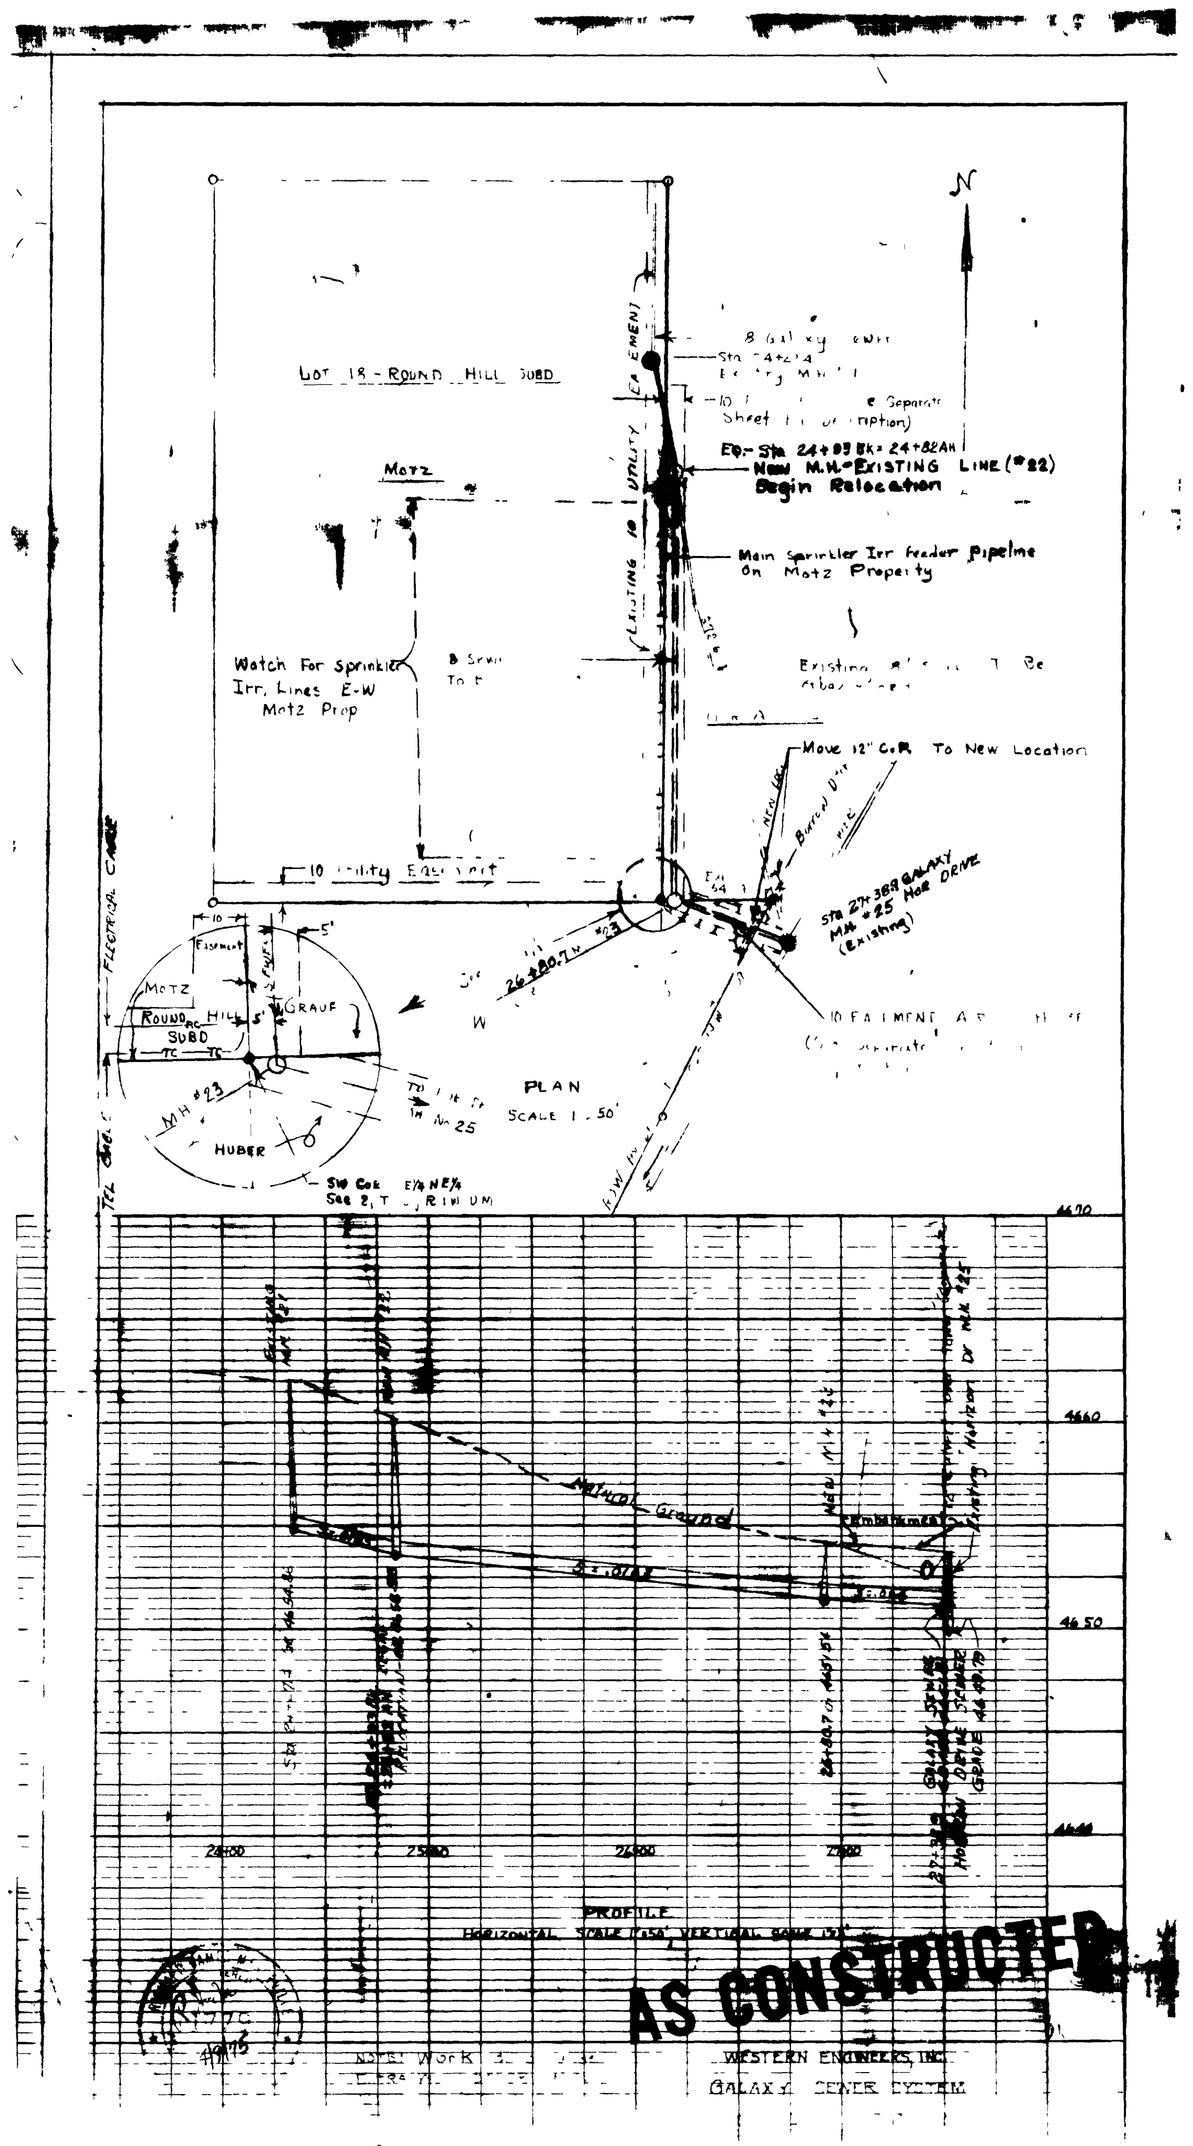

GALAXY SEWER SYSTEM