


Scale 1/3

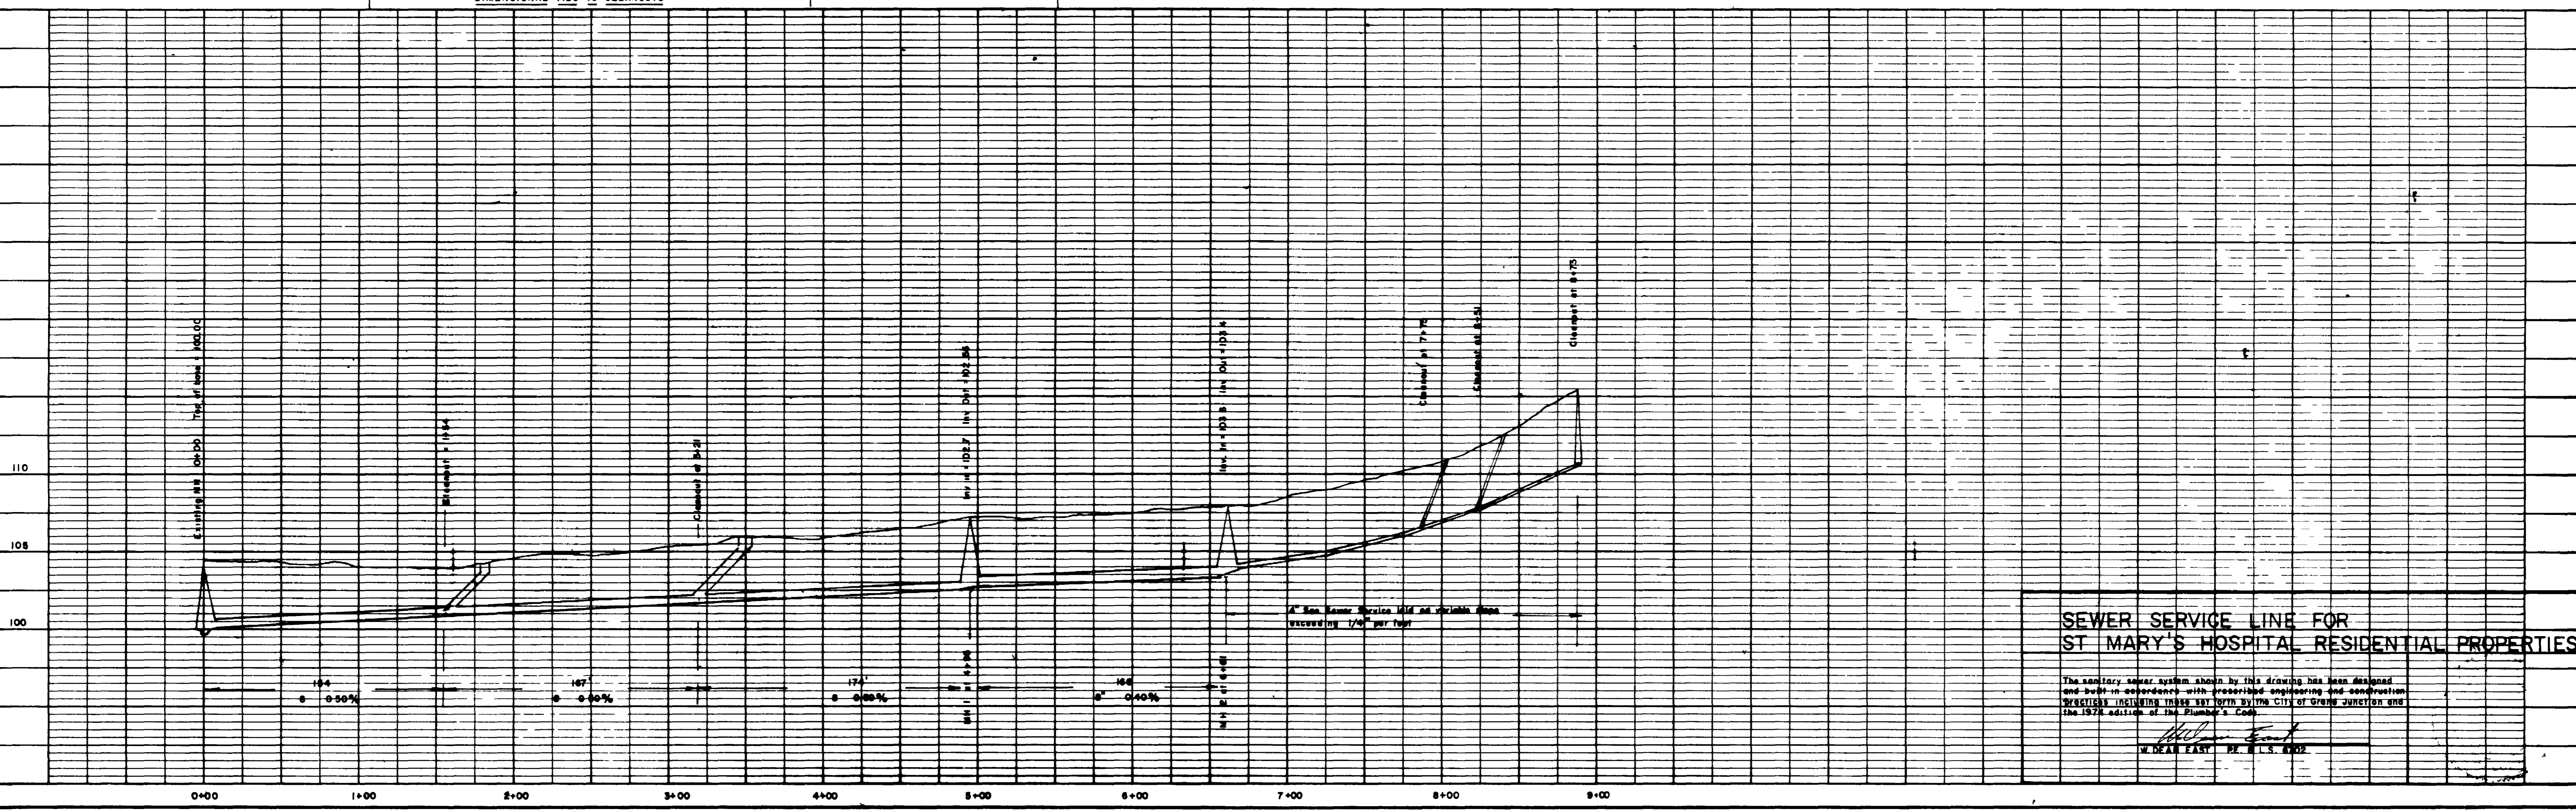

SEWER SERVICE LINE FOR ST MARY'S HOSPITAL RESIDENTIAL PROPERTIES

The sanitary sewer system shown by this drawing has been designed and built-in accordance with prescribed engineering and construction practices including those set forth by the City of Grand Junction and the 1978 edition of the Plumber's Code.

W. Dean East
 W. DEAN EAST PE M.S. 4002