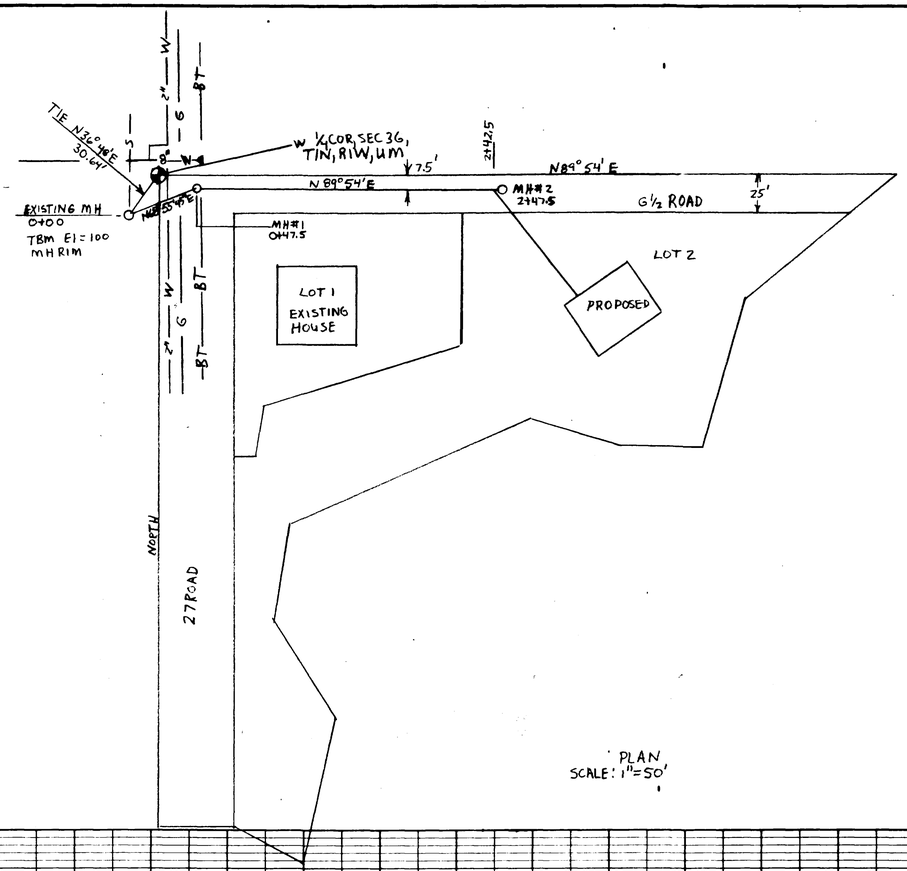

PLAN
SCALE: 1"=50'

① ALL CONSTRUCTION SHALL BE IN ACCORDANCE WITH CITY OF GRAND JUNCTION STANDARD DETAILS DRAWING SS-1 AND CITY OF GRAND JUNCTION "STANDARD SPECIFICATIONS FOR CONSTRUCTION OF WATERLINES, SANITARY SEWERS, STORM DRAINAGE AND IRRIGATION SYSTEMS" AND CITY OF GRAND JUNCTION GENERAL CONTRACT CONDITIONS FOR PUBLIC WORKS AND UTILITITIES CONSTRUCTION GC-37, GC-50 AND GC-65

② PIPE SPECIFICATIONS
MAINS PVC - ASTM D3034 SDR 35
LATERALS PVC-ASTM D3034 SDR 35

③ MANHOLES SHALL CONFORM TO AASHTO M199 W PLASTIC COATED STEEL STEPS (MA. INDUSTRIES PS3. MANHOLE RING AND COVER (CASTINGS INC. MH 250 - 24"CI).

LEGEND:

—BT—	BURIED TELEPHONE
—G—	1½" GAS LINE
—2"—W—	2" WATER LINE
—8"—W—	8" WATER LINE
—S—	8" SEWER LINE

INFILTRATION DOES NOT EXCEED 200 GAL./INCH DIA./MILE/DAY

FRANK L. WEBB
REGISTERED
PROFESSIONAL
ENGINEER
STATE OF COLORADO

AS-BUILT 12/1/81

DUNCAN MINOR SUBDIVISION

MESA COUNTY, COLORADO

DES. FL.W DRAWN FLW

GRAND JUNCTION COLO.

PROFILE
SCALE: HORIZ. 1"=50'
VERT. 1"=5'

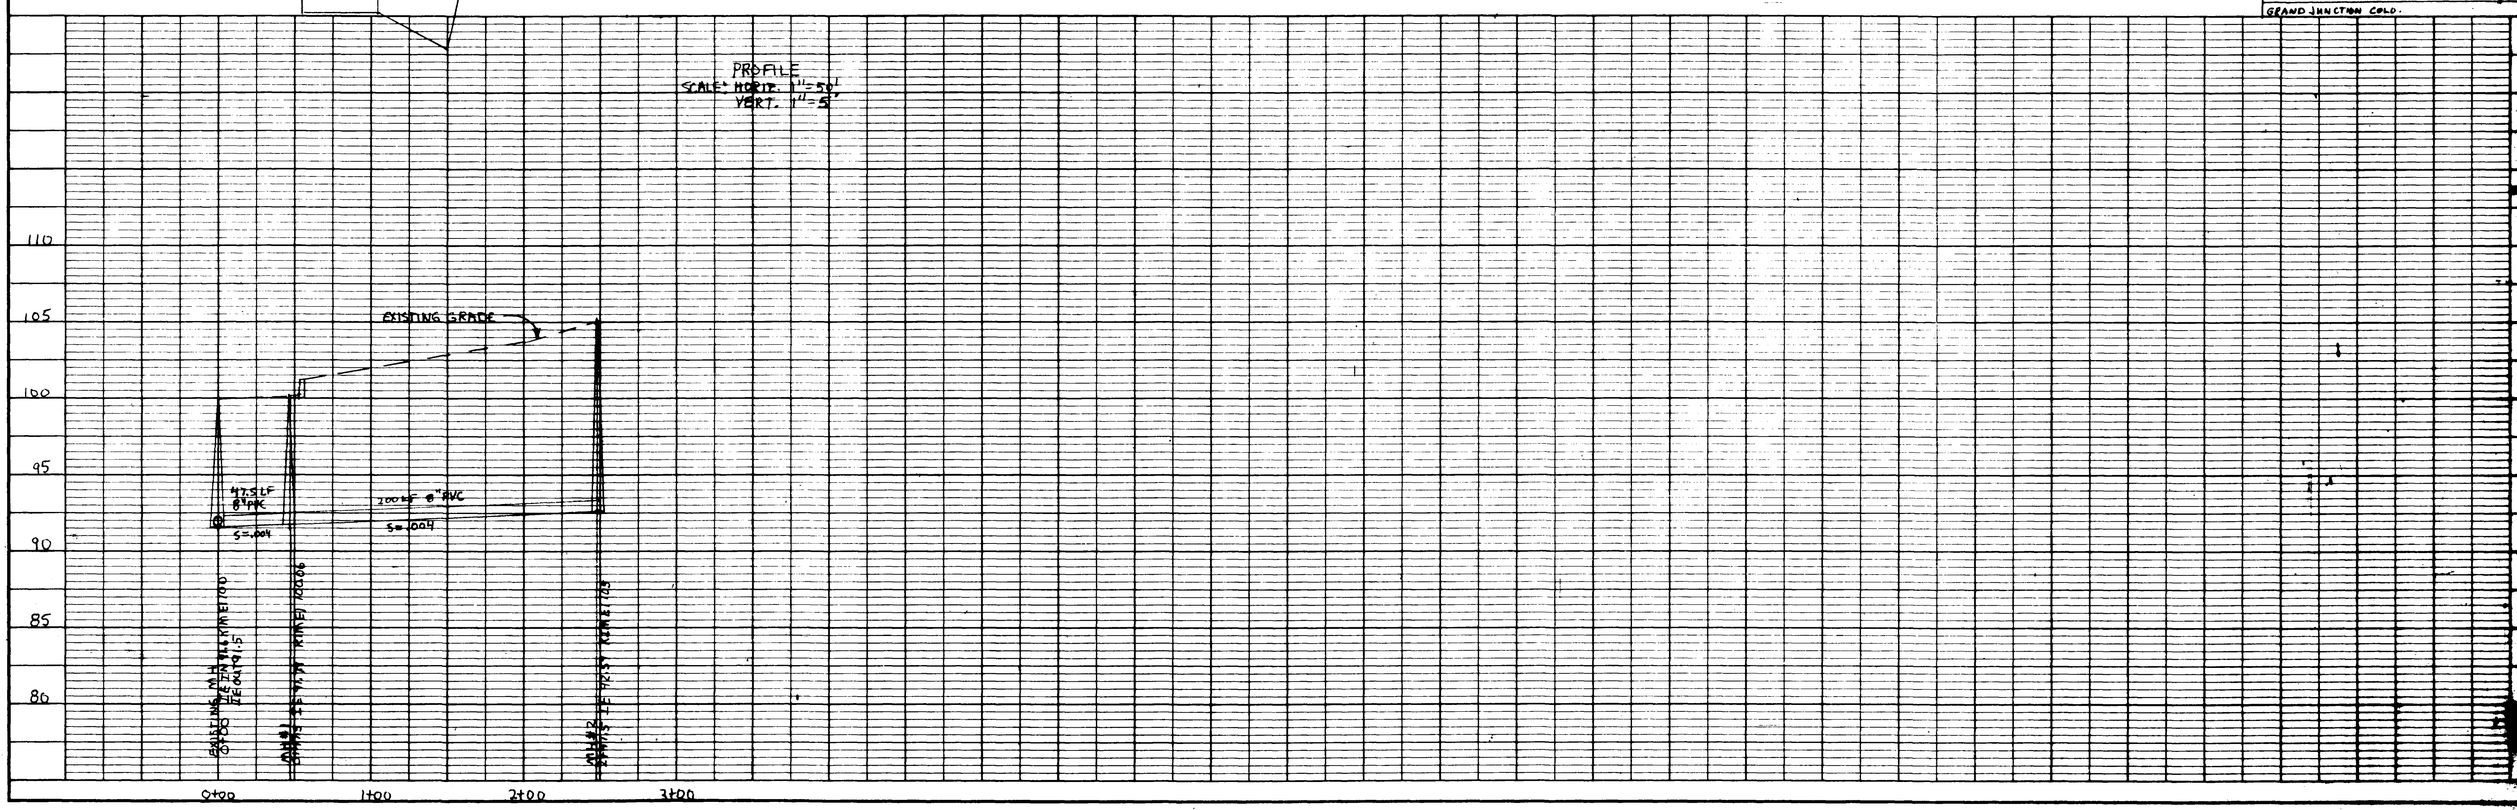

02028700.tif