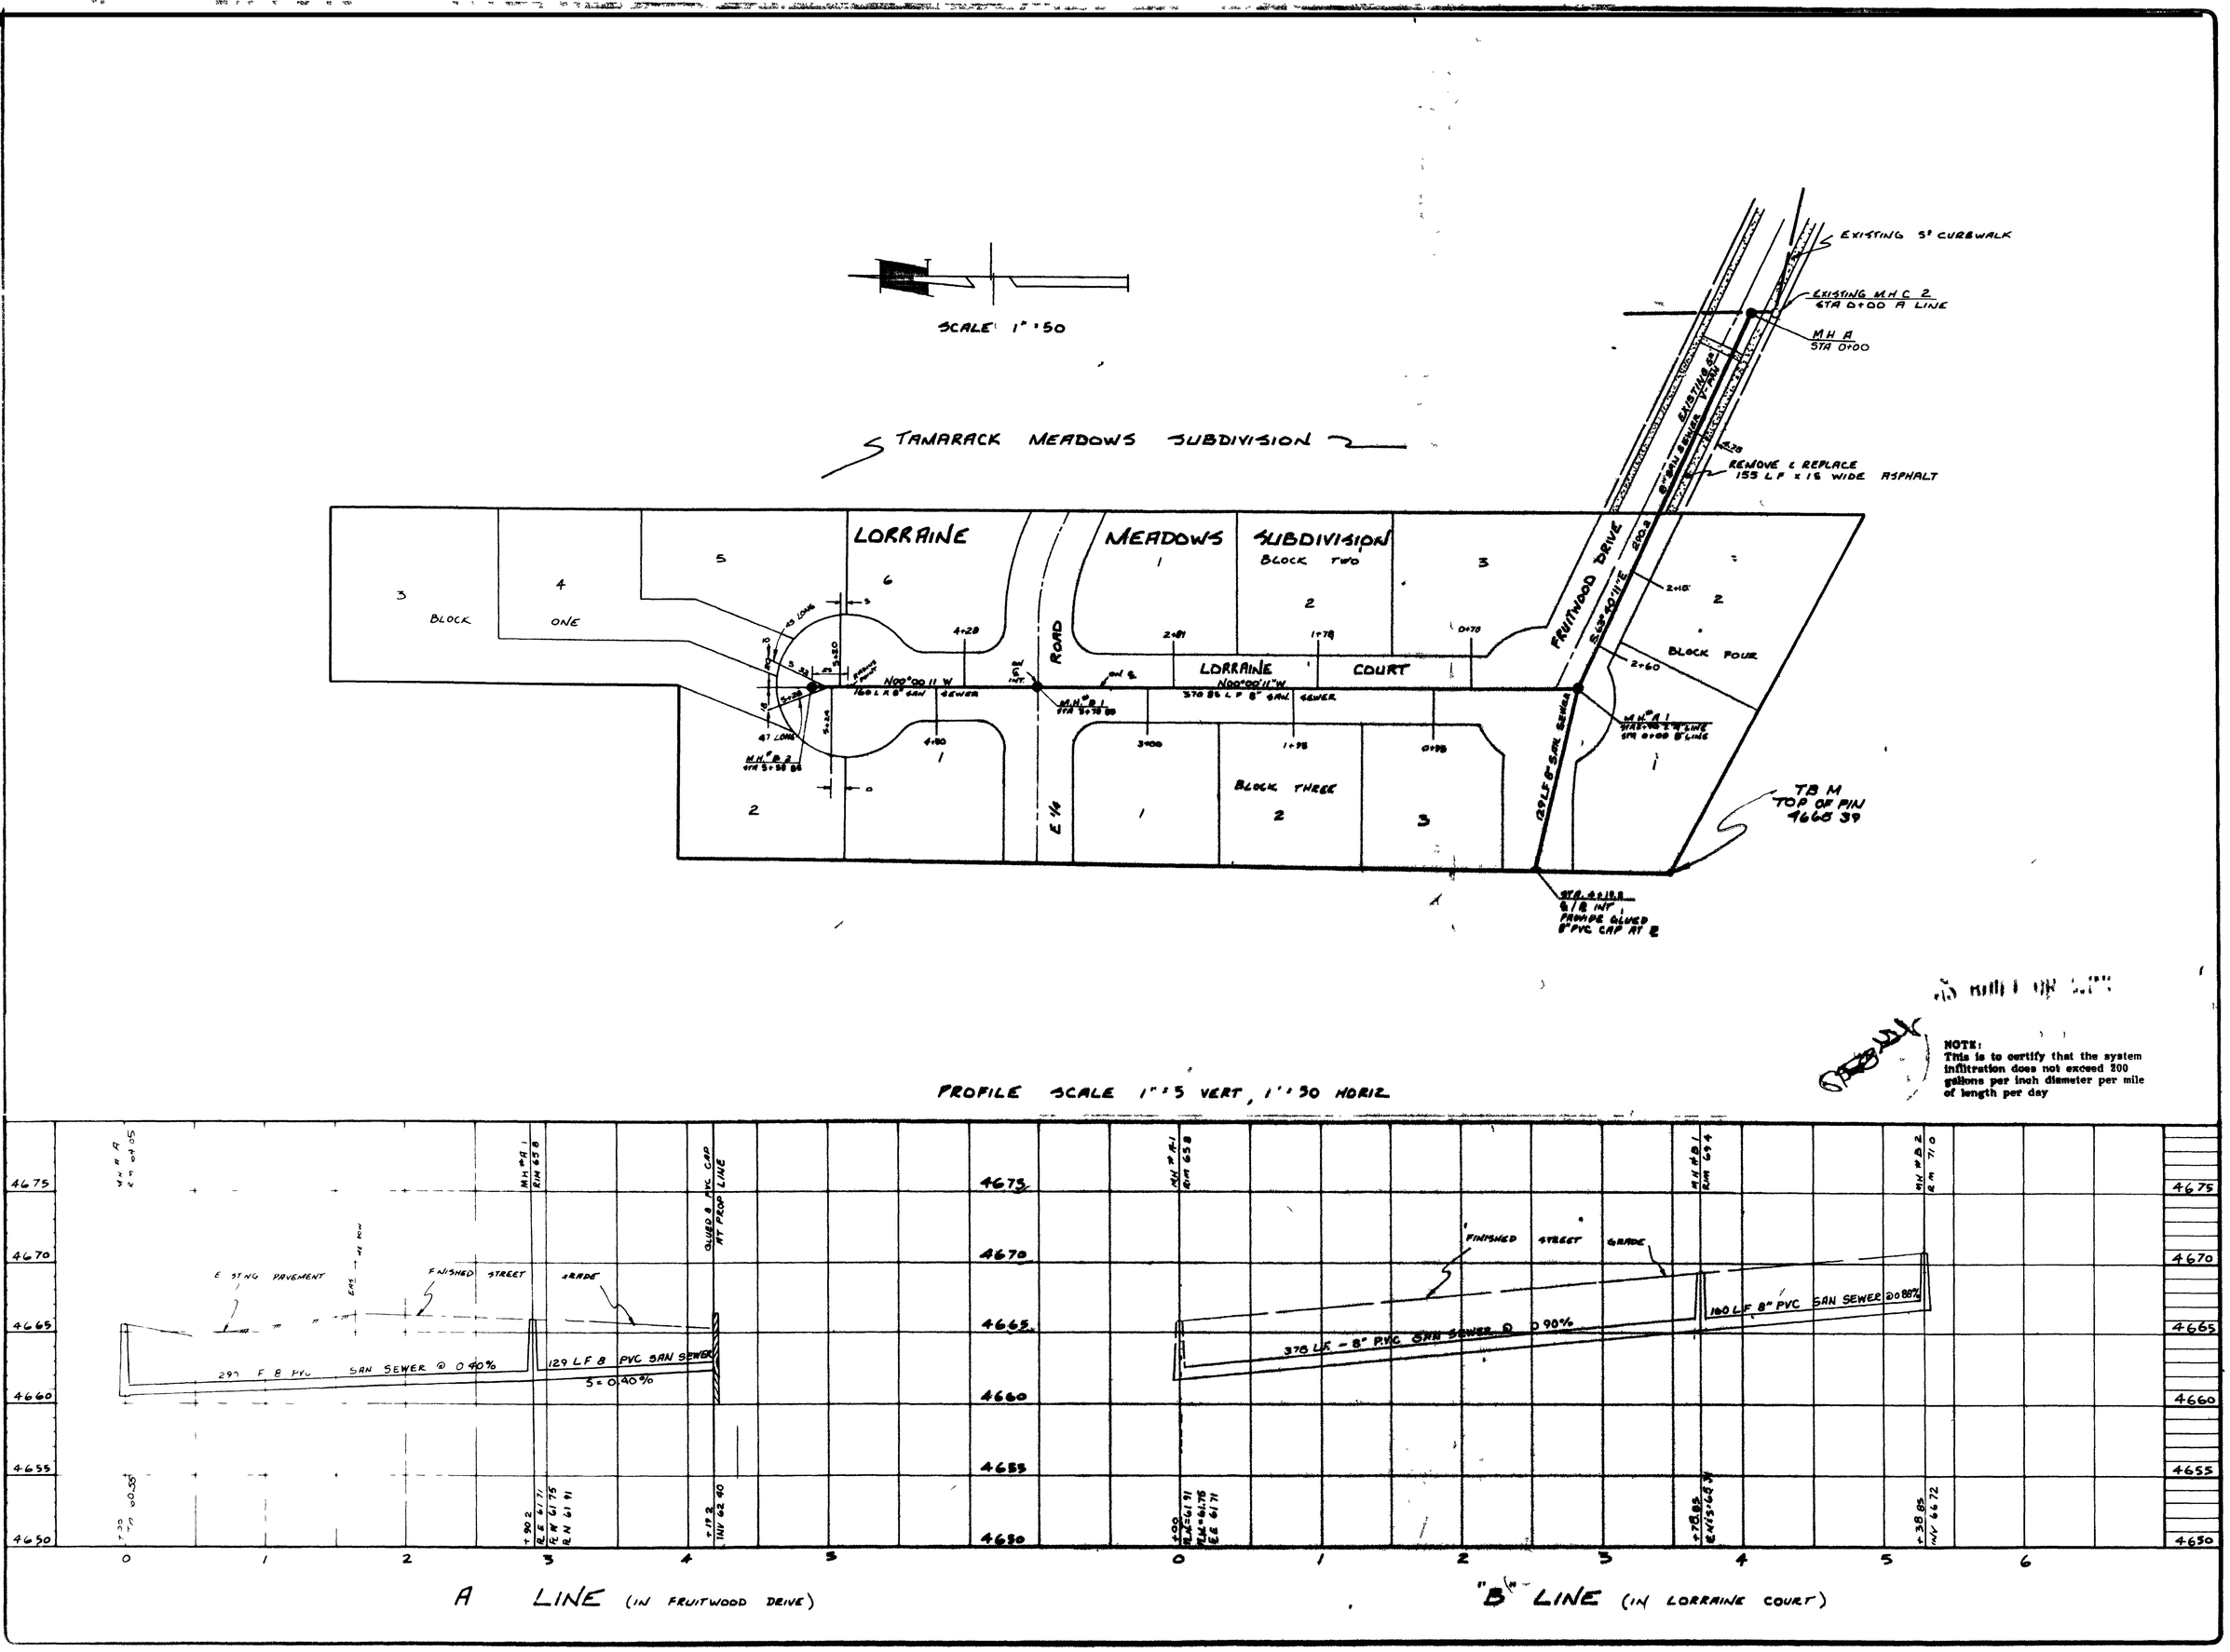

CHECKED	
OJR	
DATE	
JANUARY 1982	
SCALE	
AS SHOWN	

REVISIONS	BY
AS BUILT 4 5 82	OJR

PARAGON ENGINEERING INC.

LORRAINE MEADOWS SUBDIVISION
MESA COUNTY COLORADO
SANITARY SEWER
PLANS AND PROFILES

SHEET 1 OF 2 SHEETS

02030300.tif