


EXISTING MANHOLE NO 241
 CONSTRUCTED AS SHOWN
 BY WESTERN ENGINEER
 ON HORIZON DRIVE
 SHEET 1, OF 3
 DWS NO 1-78-16

WATER SERVICE
 Meter Valve


 Power cable
 ASSUMED ELEVATION
 EL: 2100.00

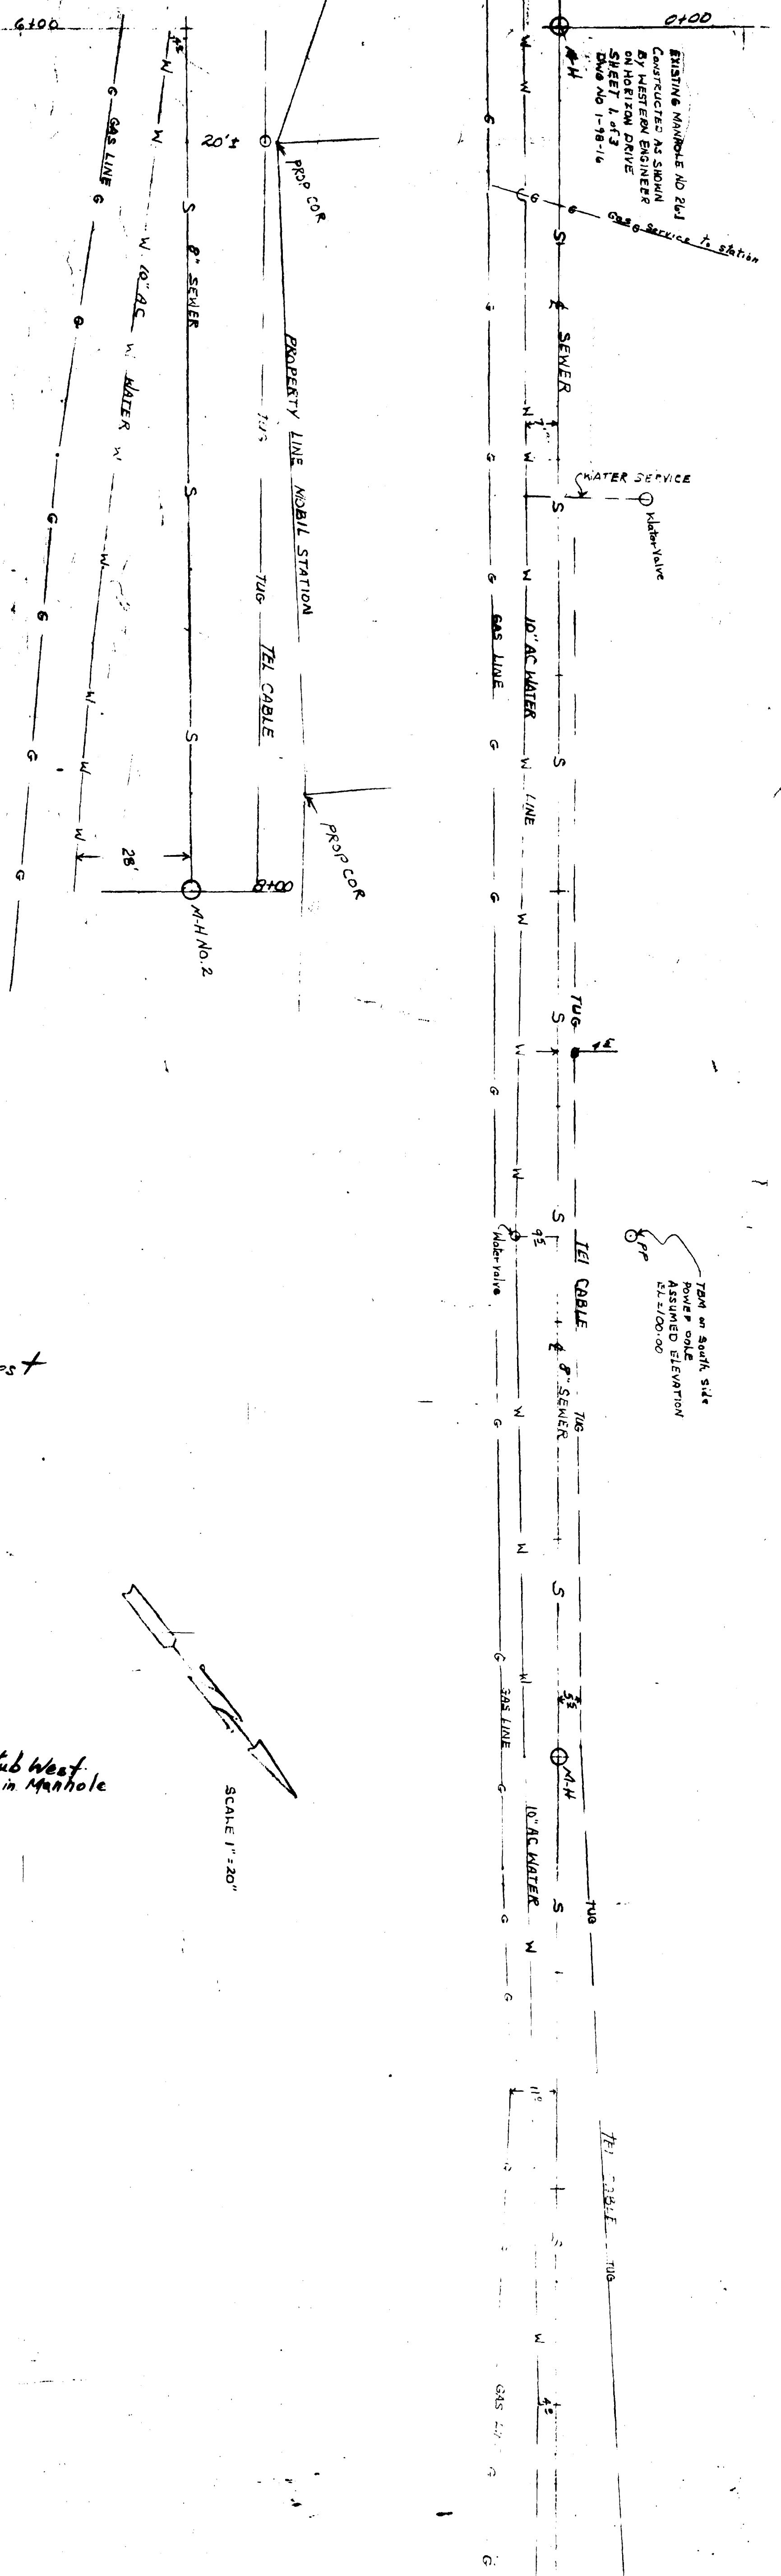

SCALE 1" = 20'

2100
2150
3103 West
 6" Stub West
 y in Manhole

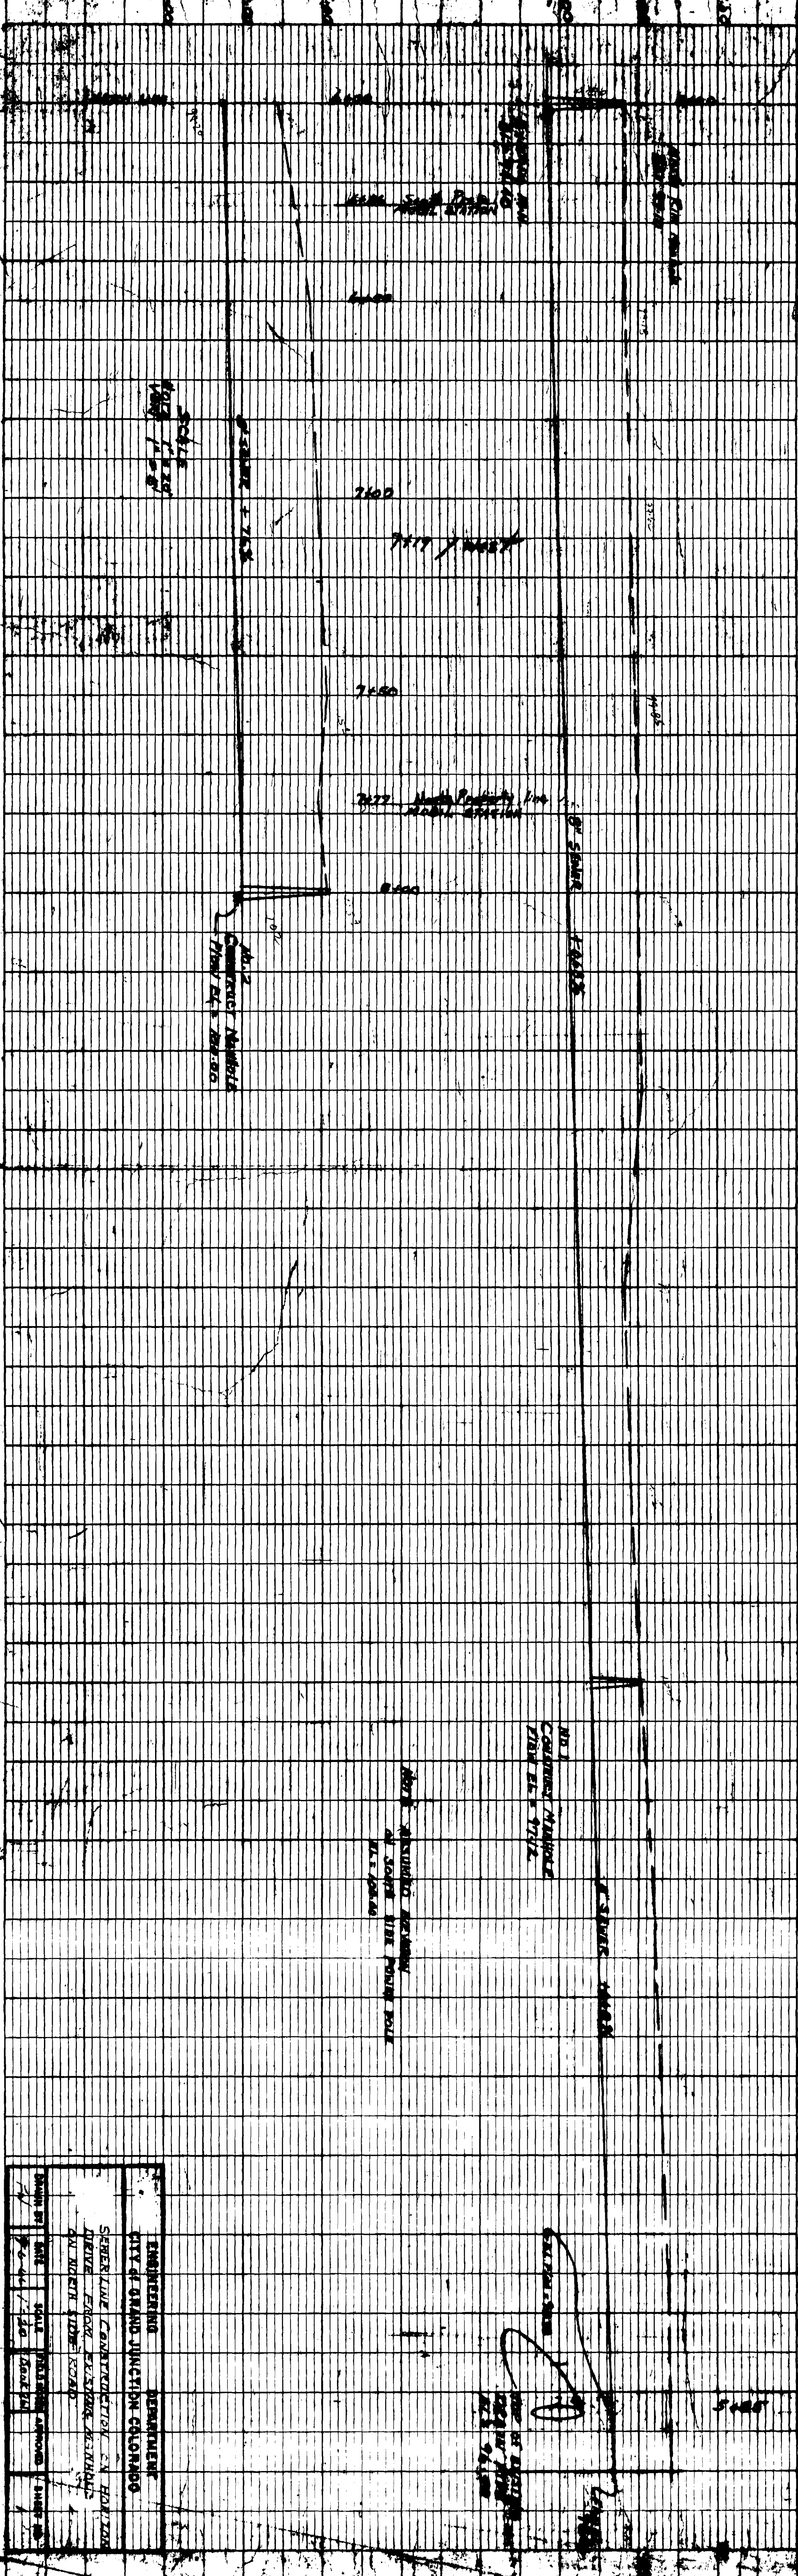

| | |
|----------------|--------------|
| ENGINEER | DEPARTMENT |
| SEWER LINE | CONSTRUCTION |
| DATE | SCALE |
| BY | DATE |
| CHECKED | DATE |
| APPROVED | DATE |