


N


Scale 1" = 20'

B.M. 464.97  
N.C.P. bolt F.H.  
3" f. Orchard.

See Field Book 224 p. 72

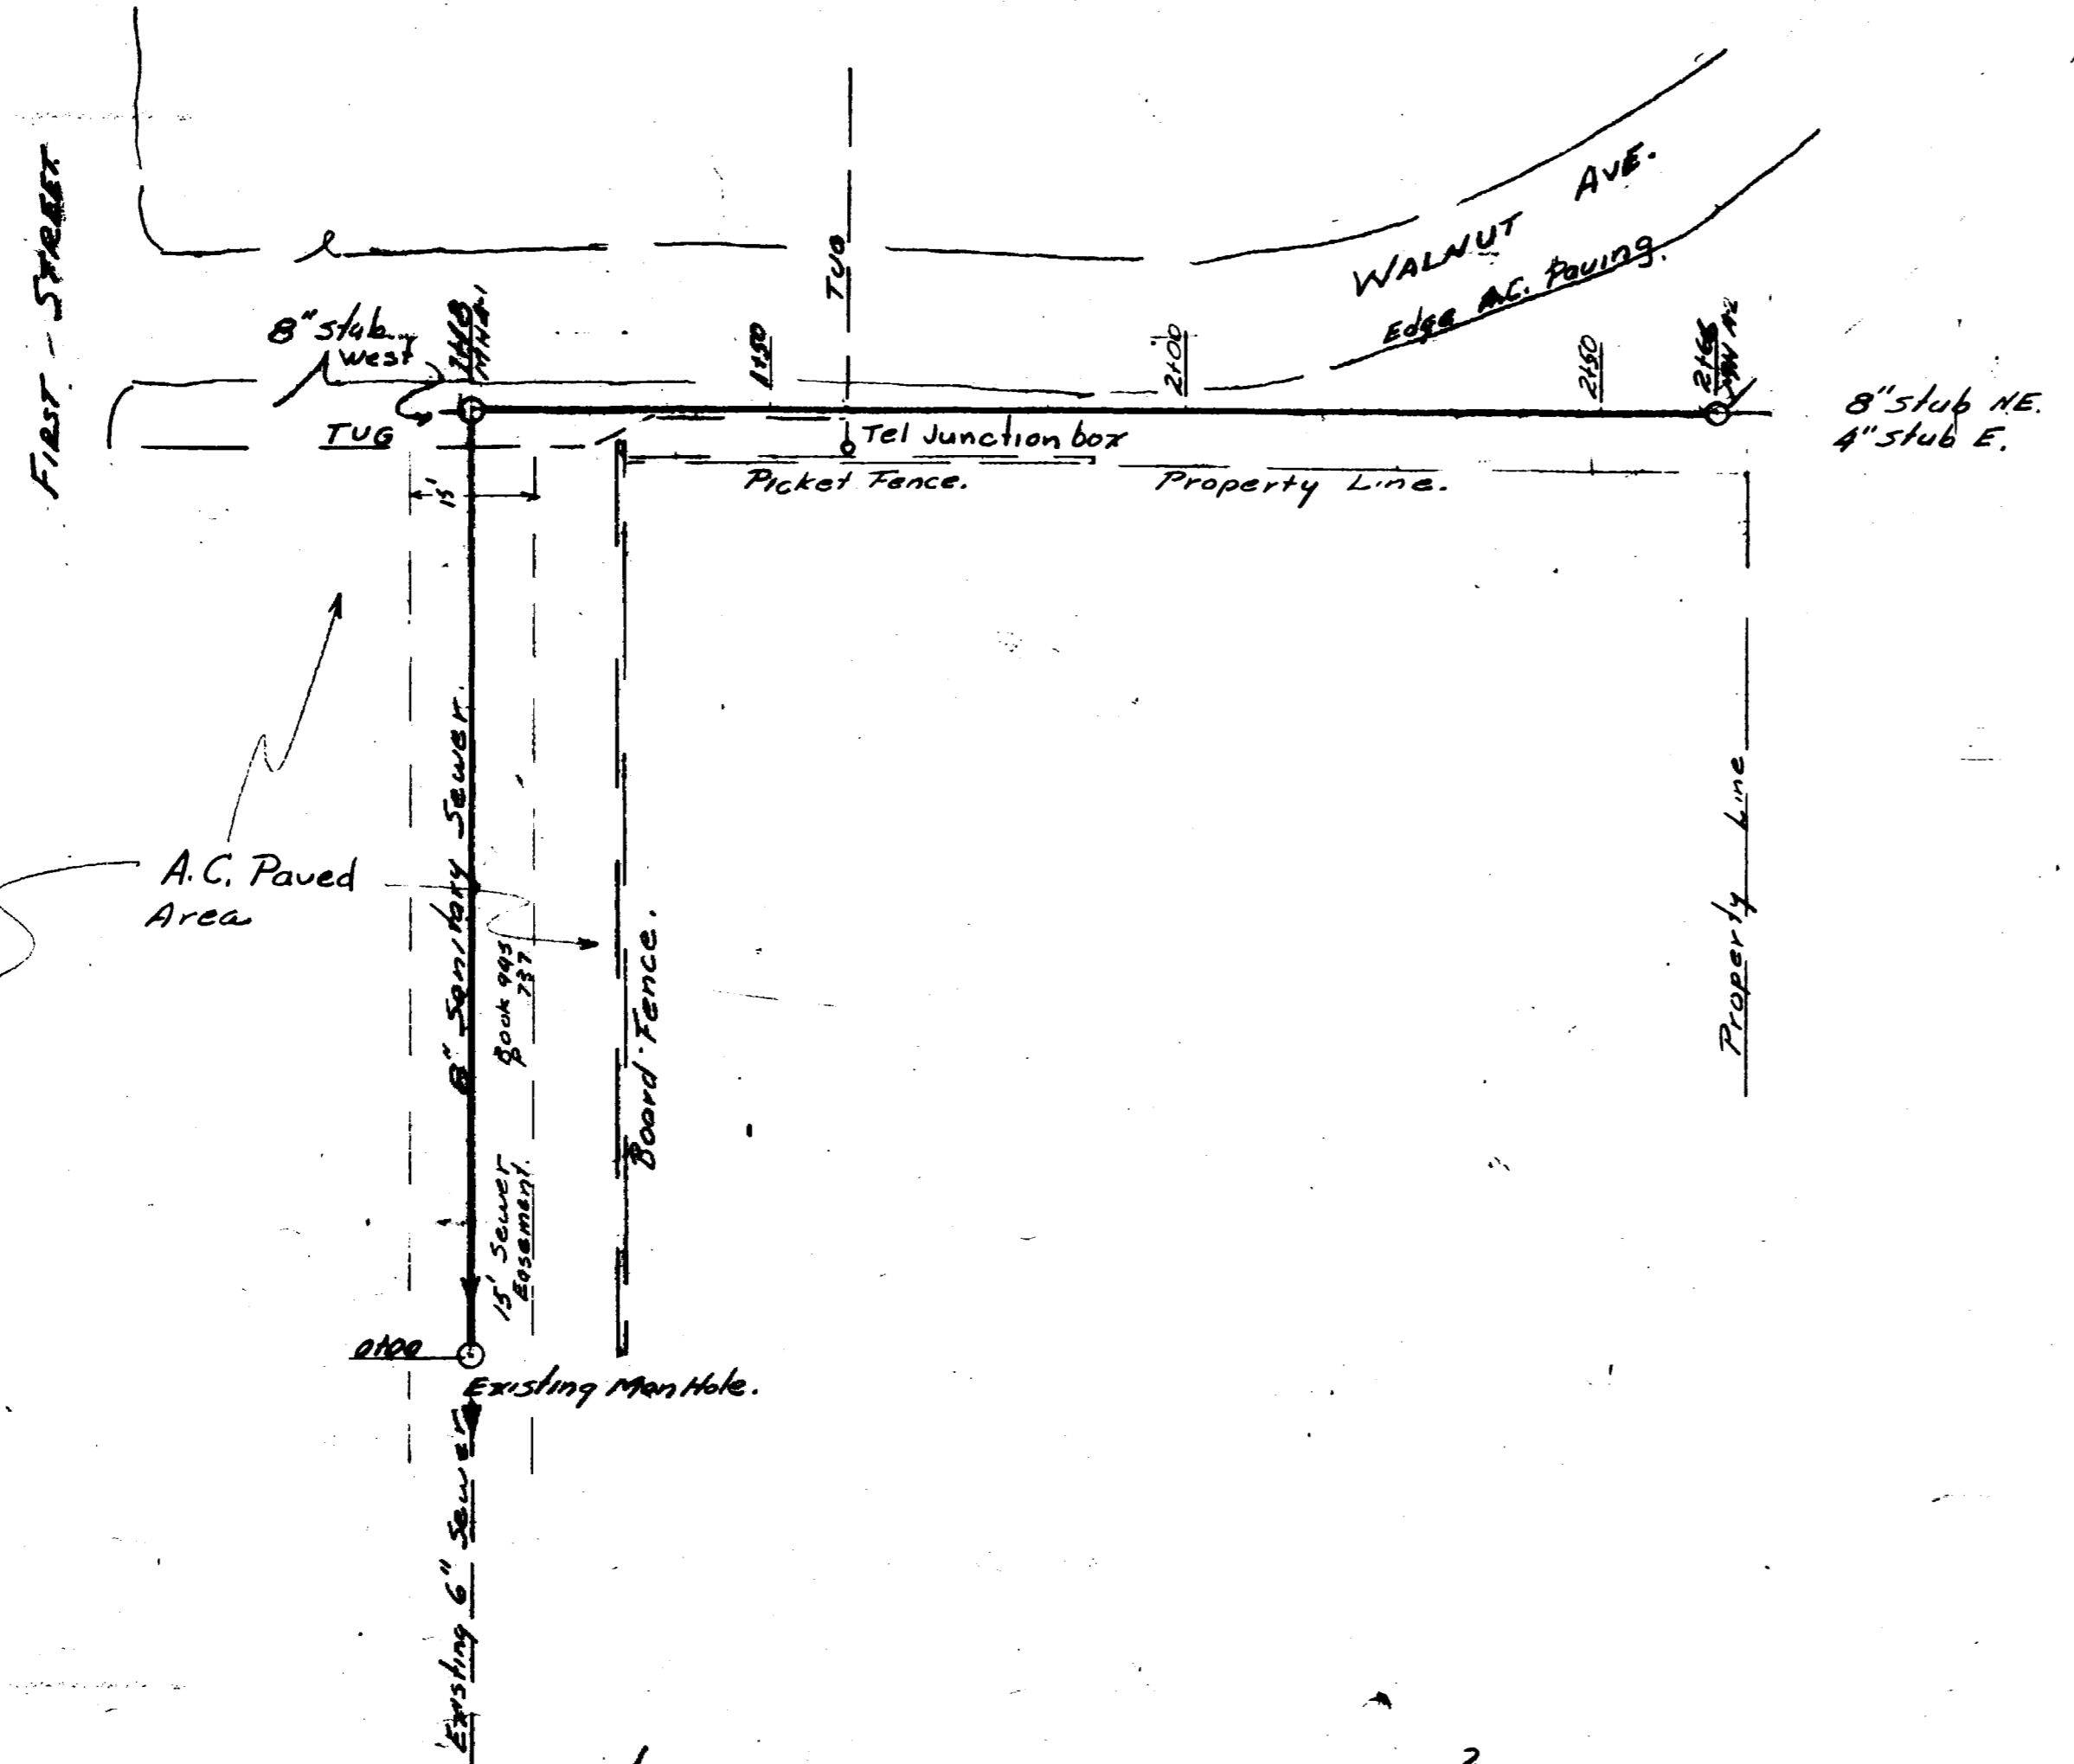

Field Book 224 p. 72

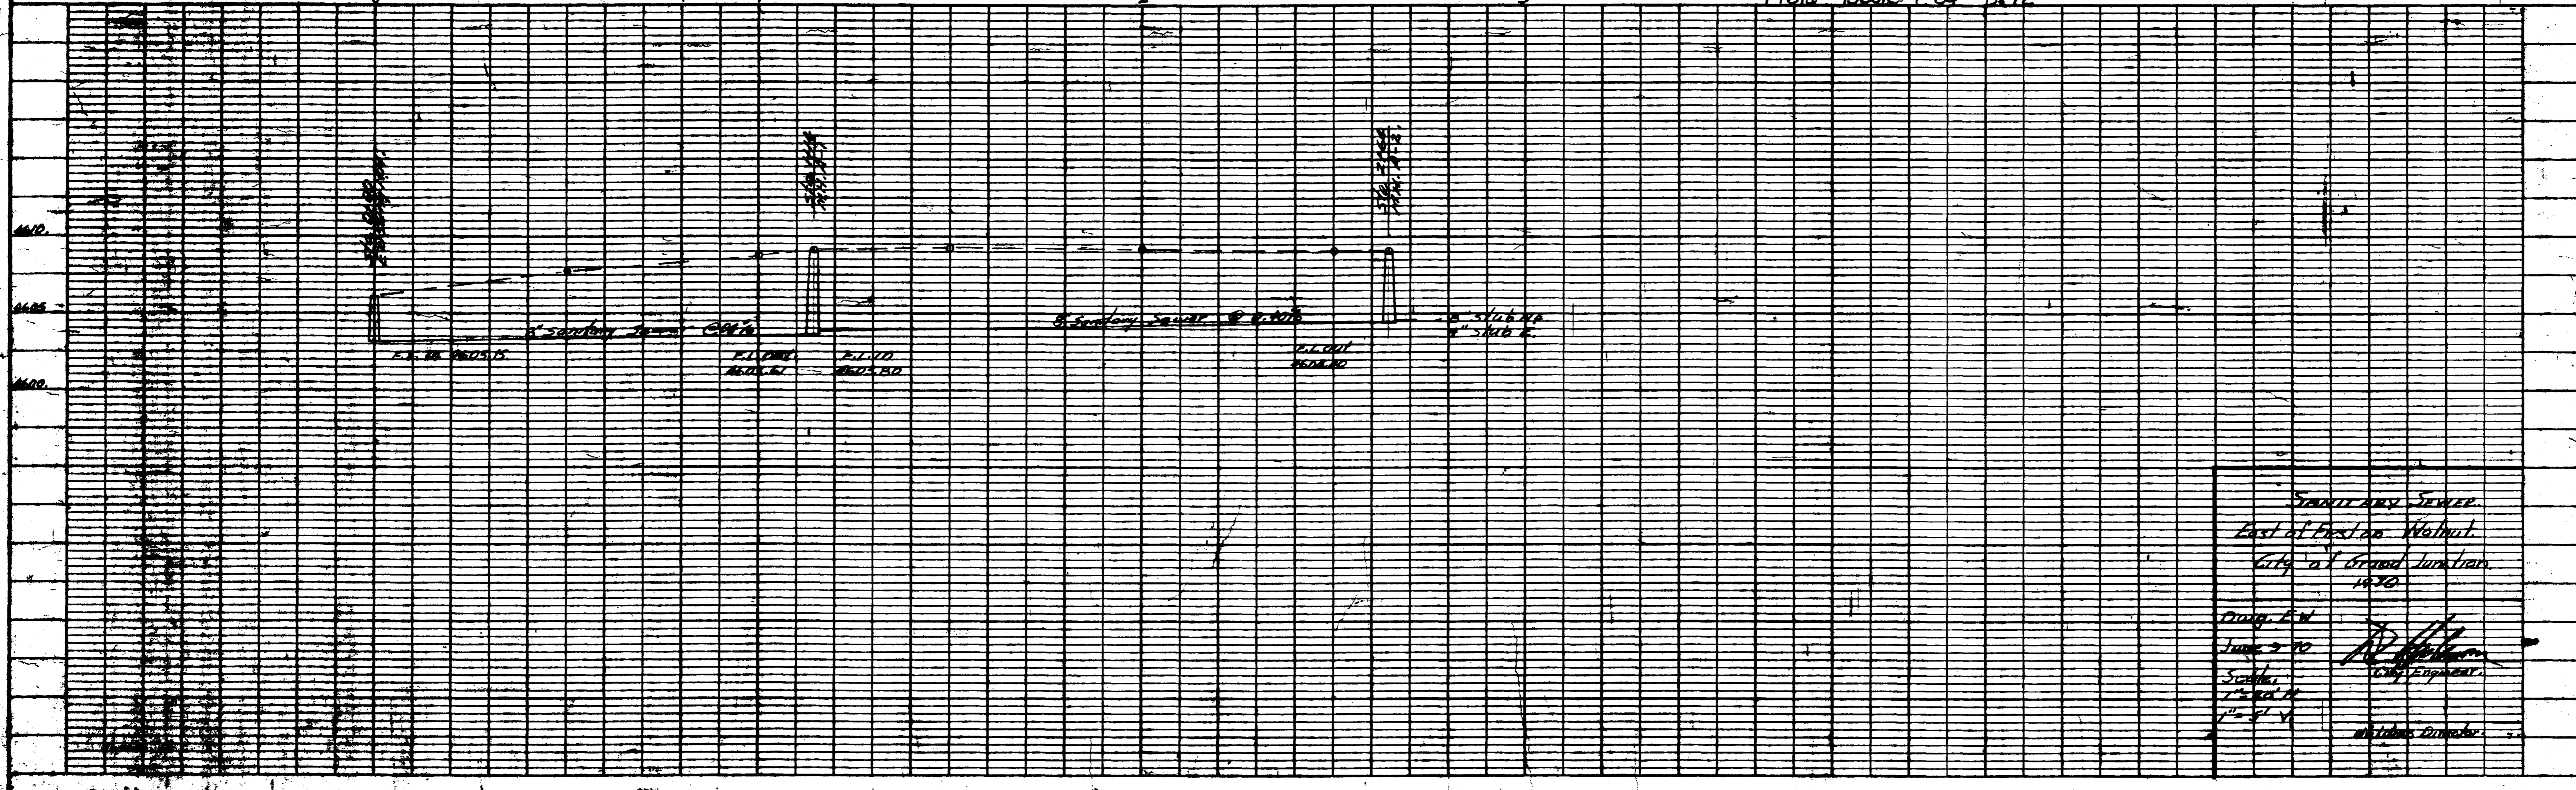

SEWER LINE  
 East of East on Walnut  
 City of Grand Junction  
 1970

Orig. En.  
 June 2 70  
 Scales  
 1" = 20'  
 1" = 4'

*[Signature]*  
 City Engineer

at Grand Junction