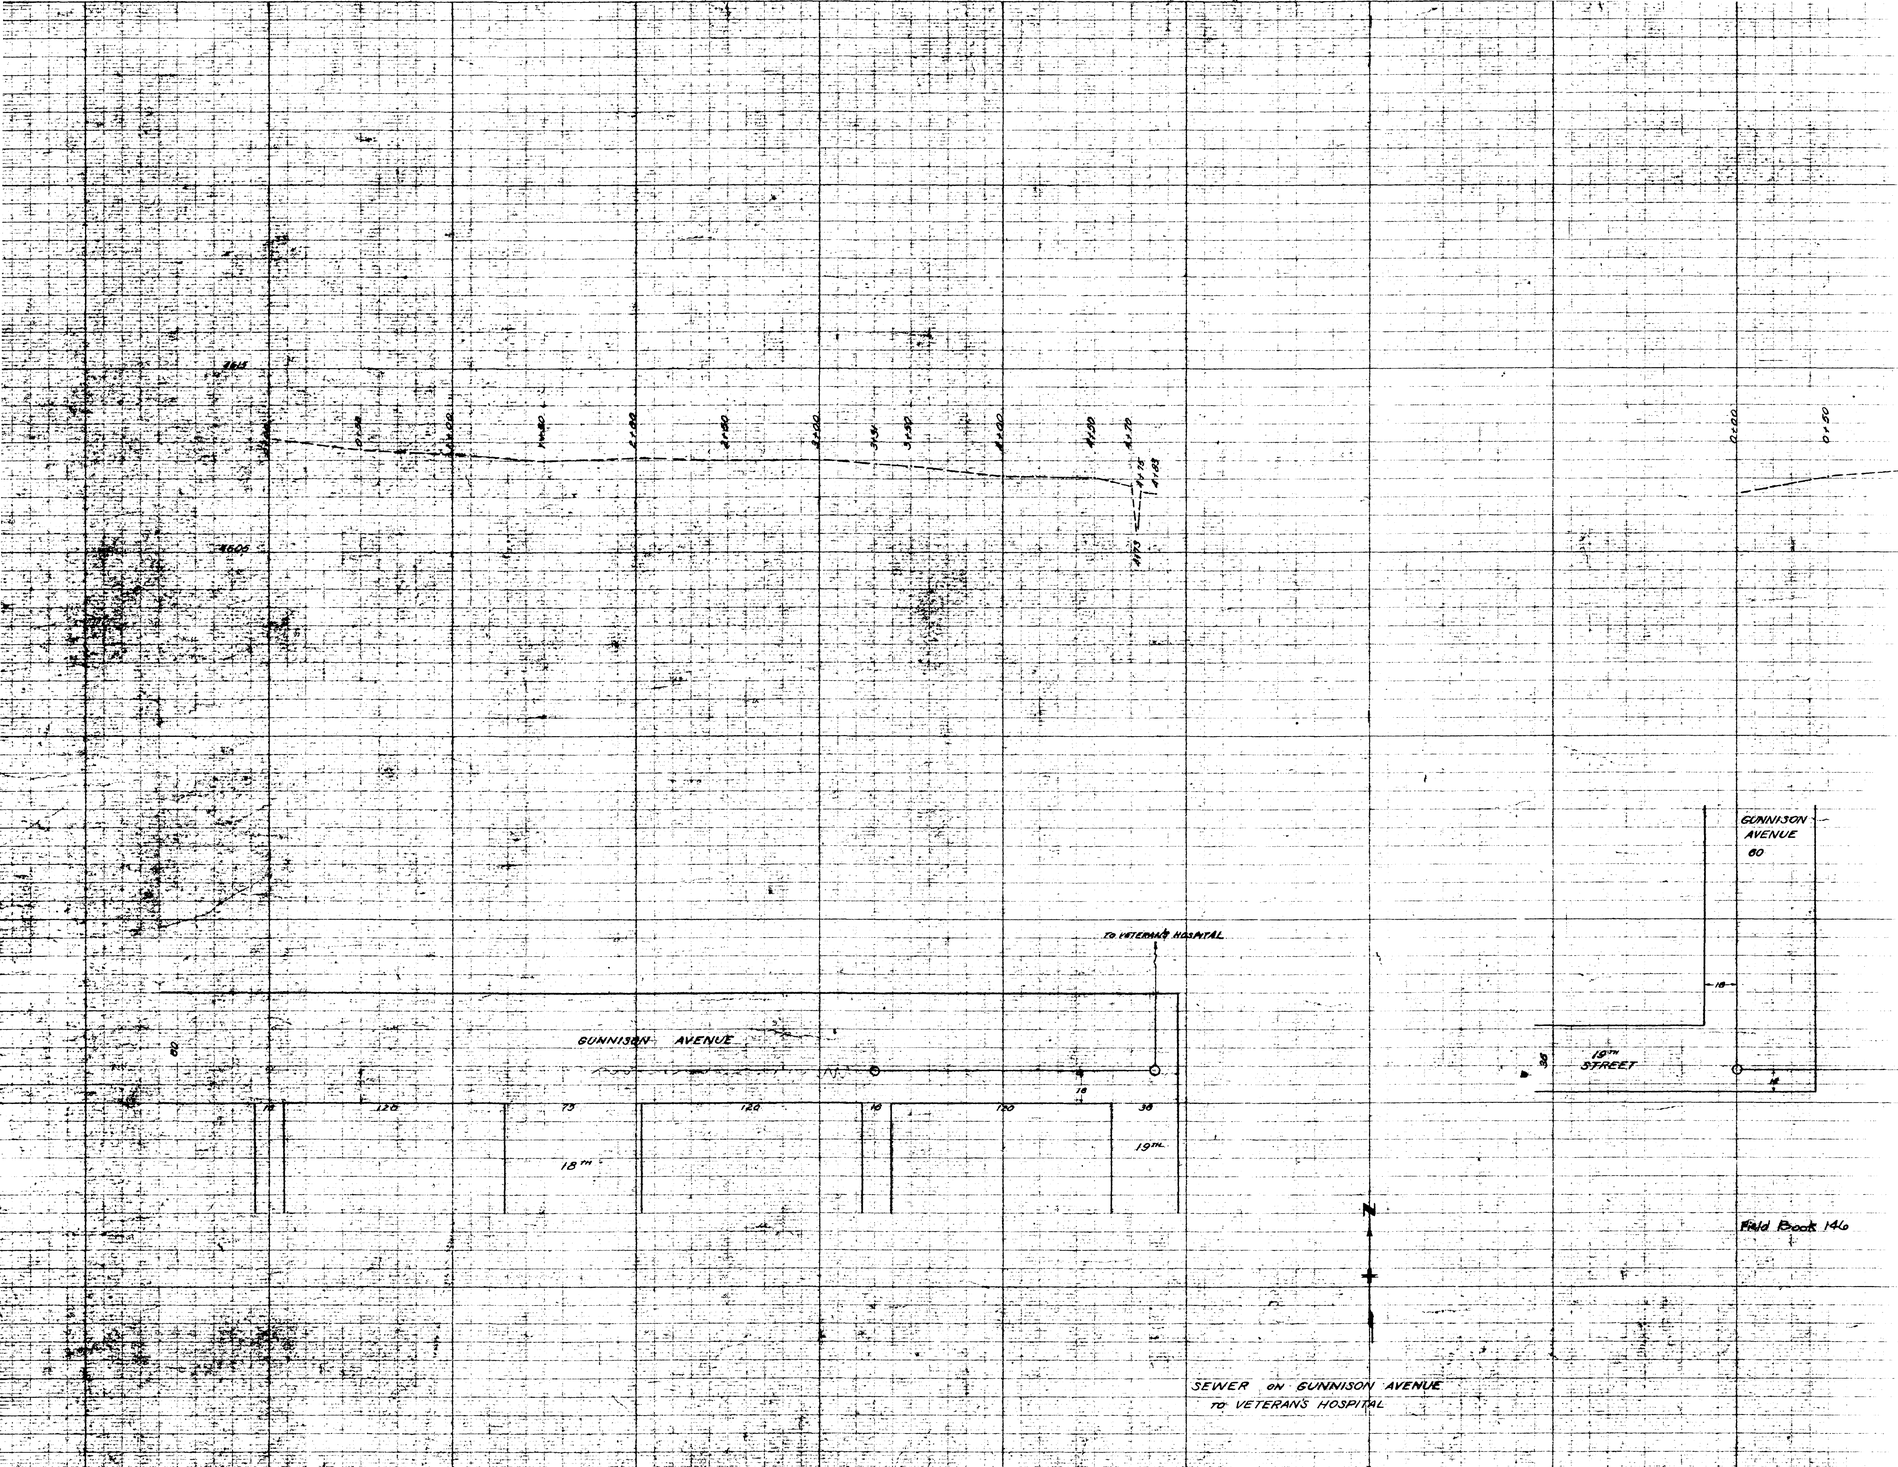

PRINTED IN U.S.A.
ON 100% RAG PAPER MADE IN U.S.A.
SENTRY PROFILE
PRINTED IN U.S.A.
ON 100% RAG PAPER MADE

02040800.tif