


SEWER DISTRICTS Nos. 5 & 6  
 PLAT SHOWING LOCATION OF "Y's" ETC.  
 Station Number of Y as Shown Gives  
 Distance From Man Hole to "Y"  
 Scale: 1" = 200' Nov. - 1920  
 J. E. Thompson  
 City Engineer.

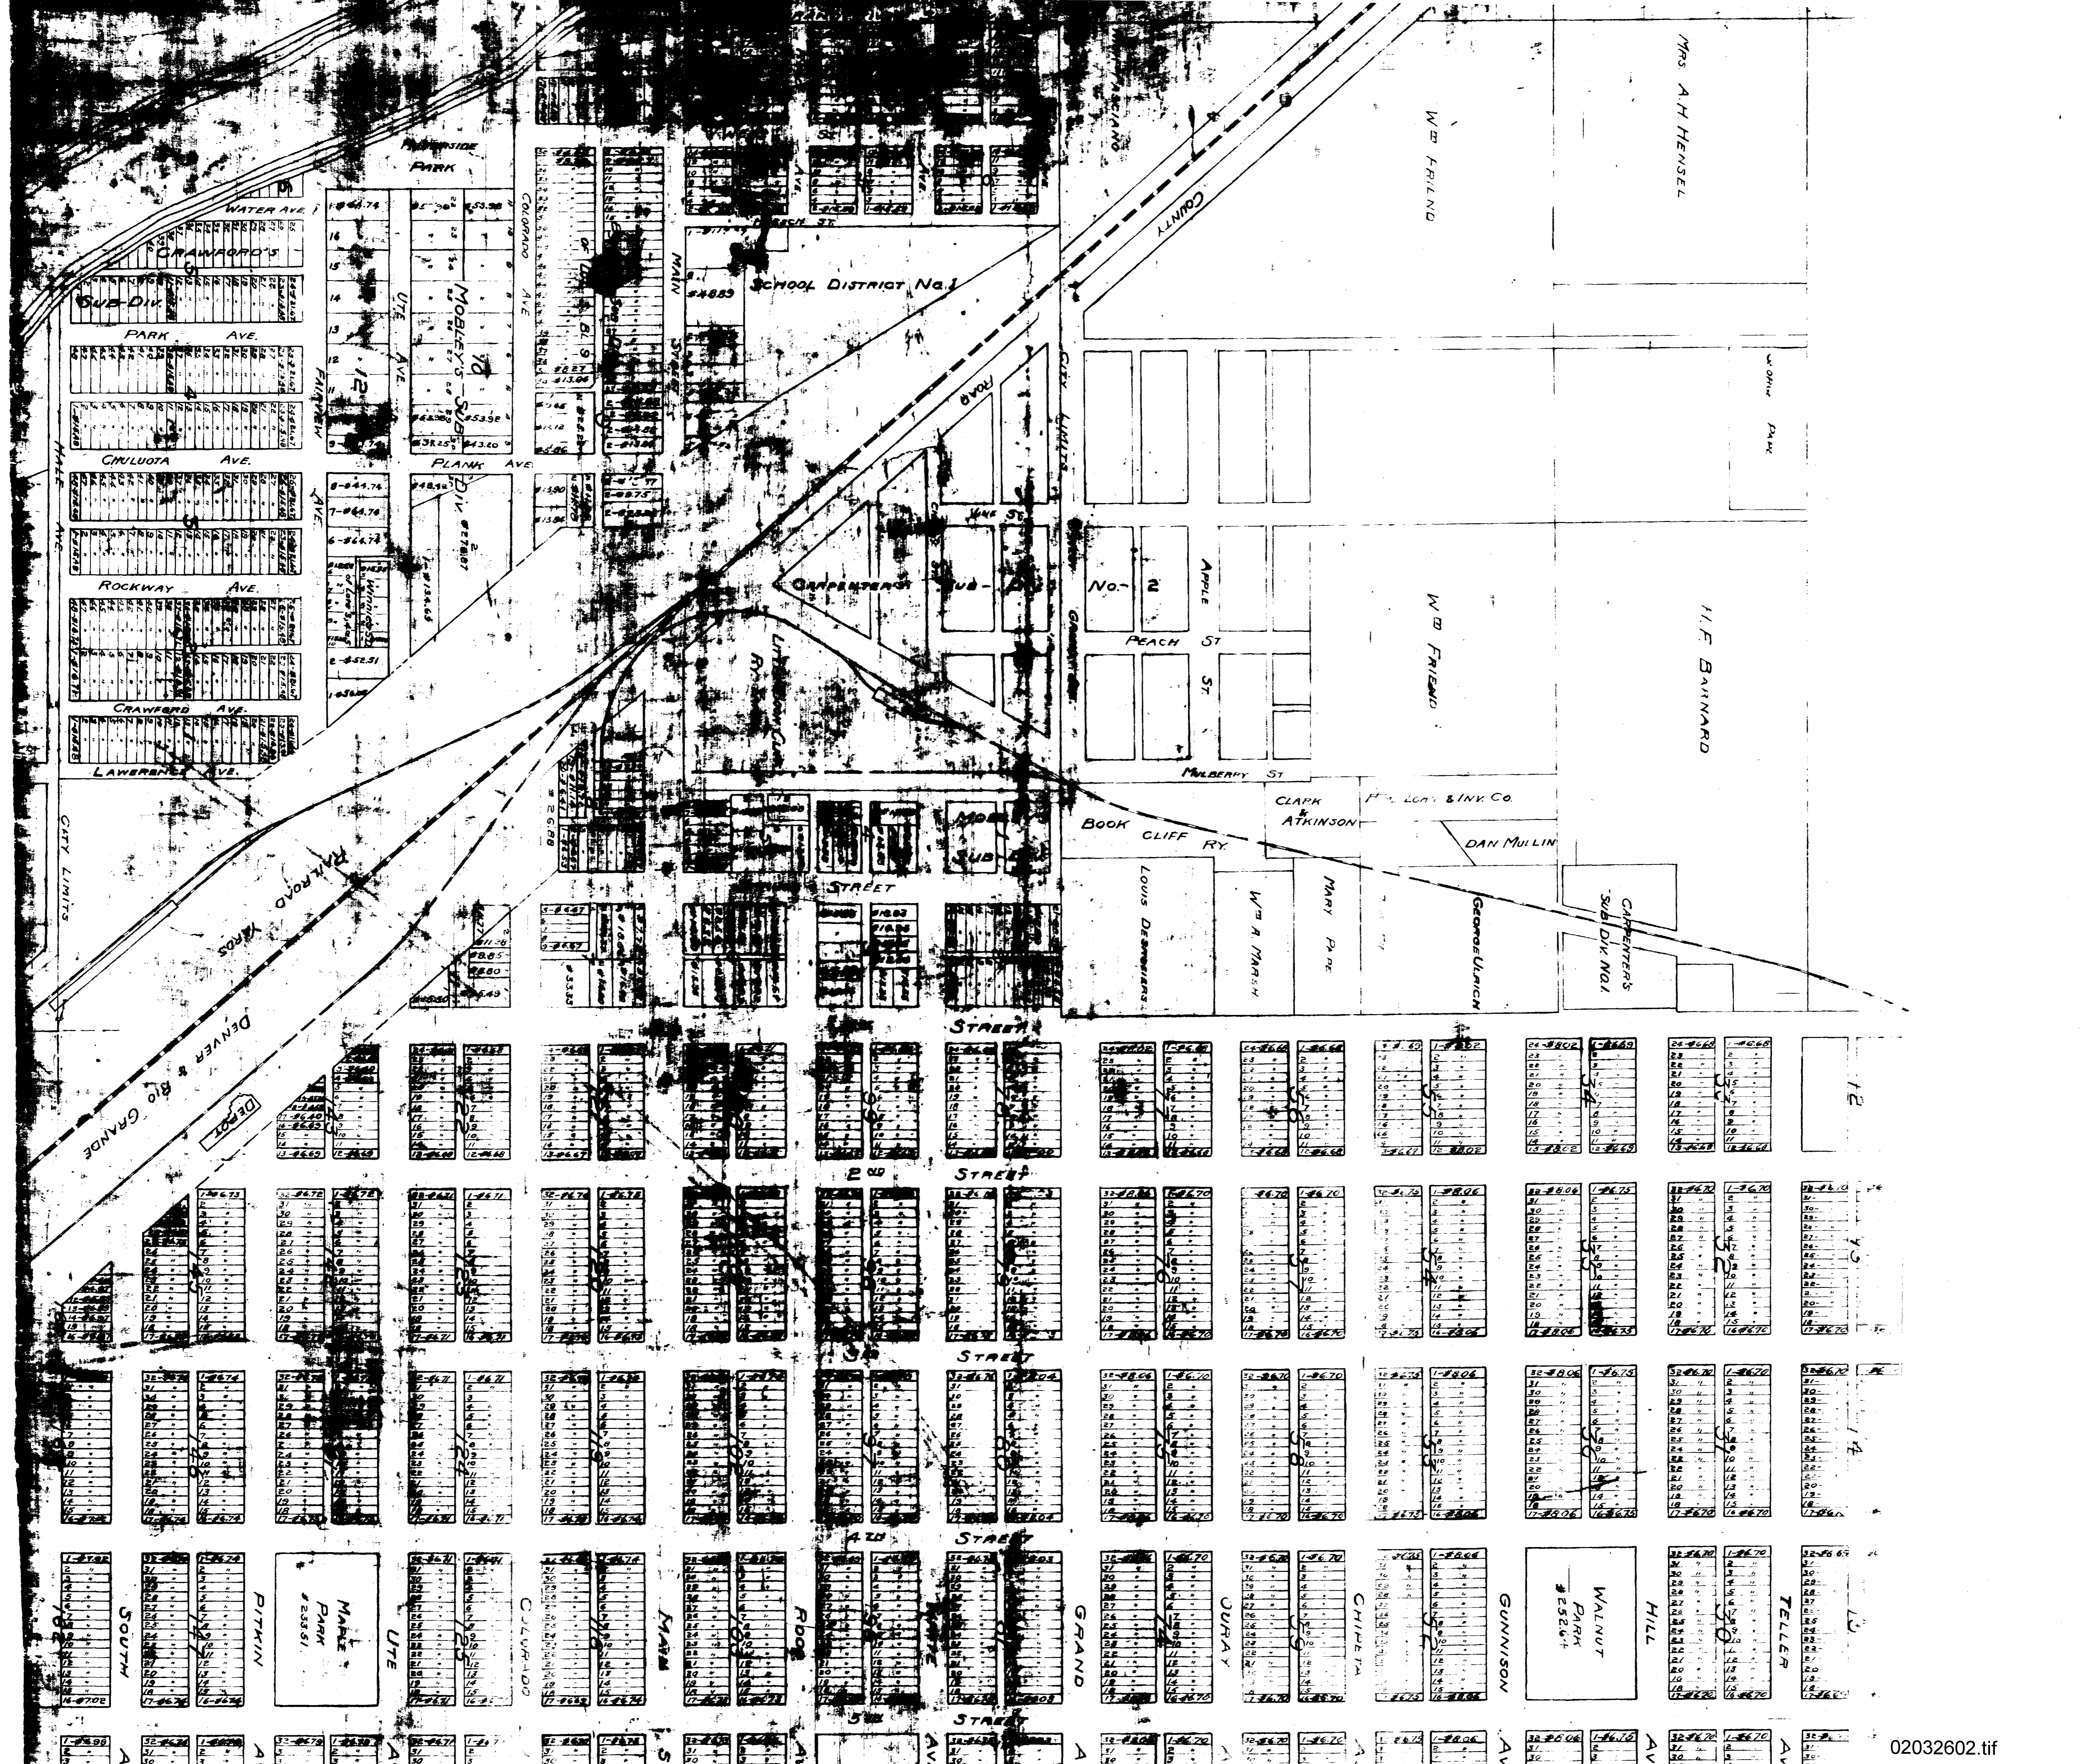

Mrs A.H. HENSEL

H.E. BARNARD

W.B. FRIEND

W.B. FRIEND

CLARK & ATKINSON

THE LAM & INV. CO.

DAN MULLIN

CARPENTERS  
Subd Div No. 1

George Ulrich

MARY PAPE

Wm A. MARSH

Louis Deming

BOOK CLIFF RY.










12

13

14

15

16

TELLER

HILL

WALNUT  
PARK  
#25264

GUNNISON

CHIEF

DURAY

GRAND

ROCK

MAIN

COLORADO

UTE

PITKIN

SOUTH

LIMITS		NORTH AVENUE							

LINCOLN PARK

EPISCOPAL CHURCH GROUNDS

DUNDIE PLACE

KEITH

ADDITIONAL

FINAL LOT ASSESSMENTS  
SEWER DISTRICTS Nos 5 & 6  
GRAND JUNCTION, COLO SEP. 1920  
BOUNDARY DISTRICT No 5  
BOUNDARY DISTRICT No 6  
SCALE: 1" = 200'  
ASSESSABLE AREA DISTRICT No 5 = 1,508,238 Sq. Ft.  
