


- NOTES:**
- Sewer shall be installed in accordance with the "City of Grand Junction Standard Specifications for construction of water lines, sanitary sewers, storm drainage and irrigation systems" and with City Standard Detail Drawing SS-1.
 - Contractor shall verify actual depth of water line and 15" CMP irrigation pipe before beginning sewer construction.
 - All pavement removed within the public right-of-way shall be temporarily patched with cold mix until it can be permanently patched with hot bituminous pavement.


PLAN
SCALE: 1" = 20'

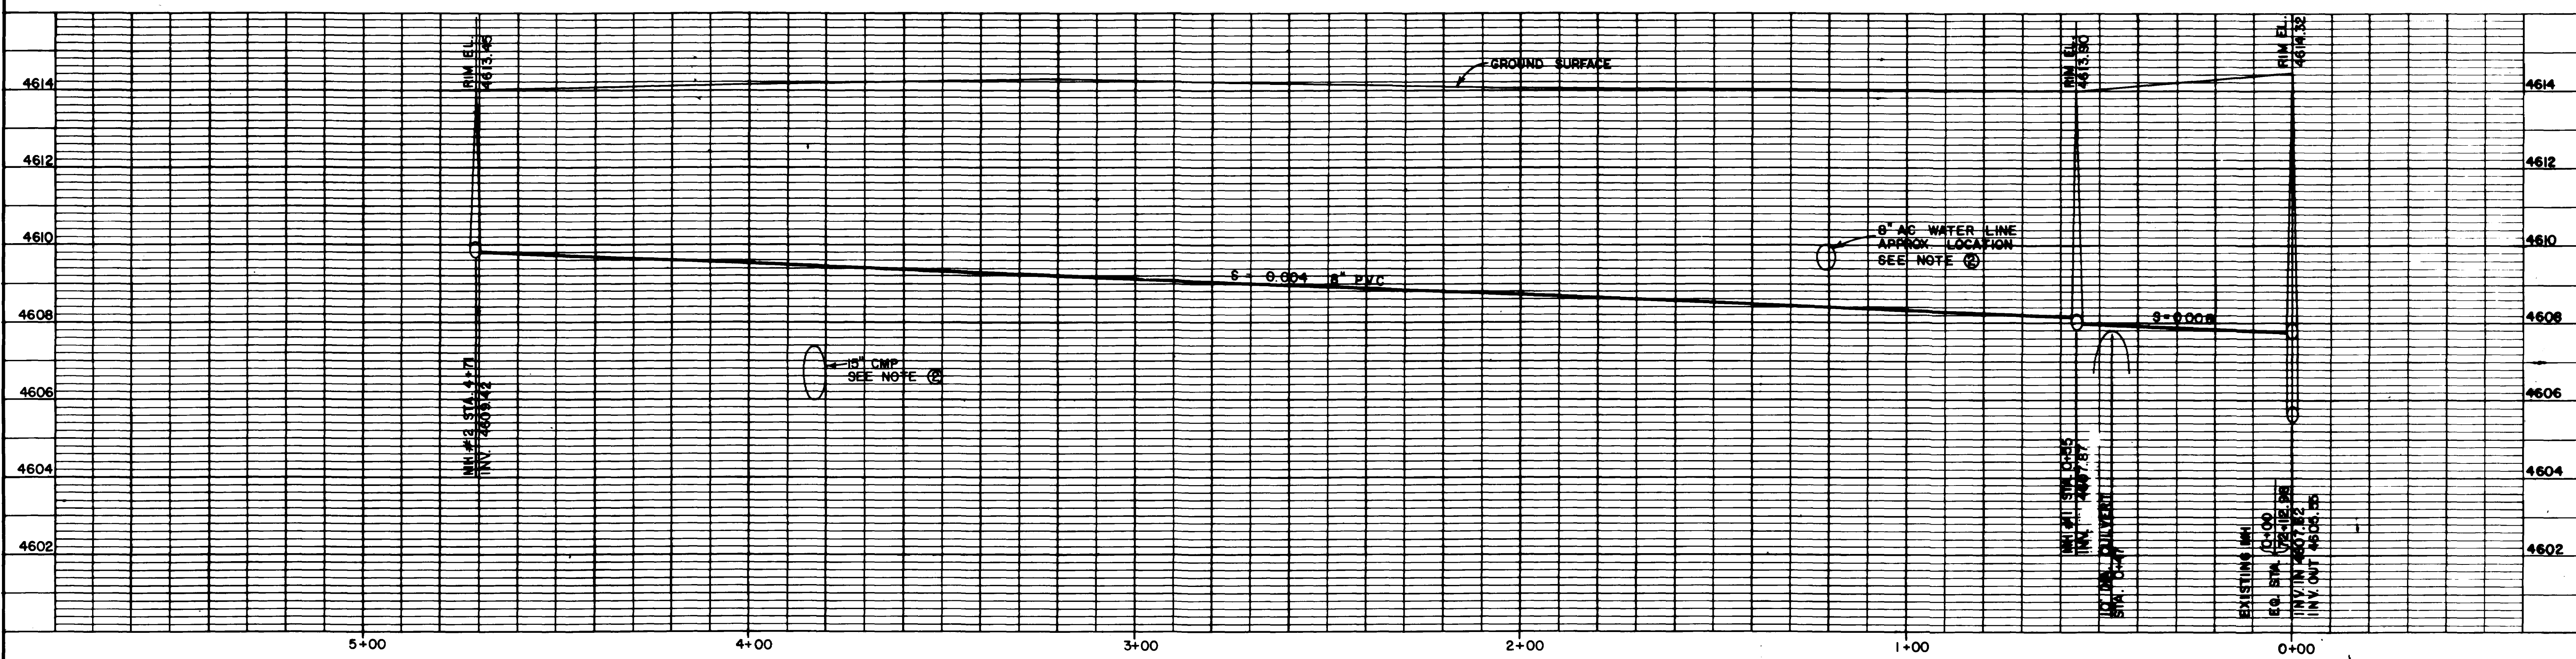

PROFILE
SCALE: HORIZ. 1" = 20'
VERT. 1" = 2'

INFILTRATION DOES NOT EXCEED
200 GAL. / IN. DIA. / MILE / DAY.

INSTALLED: FEBRUARY, 1985
CONTRACTOR: TRAVIS JORDAN

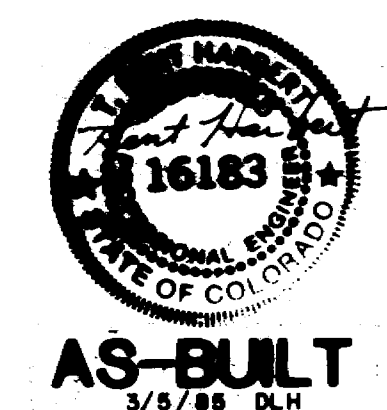

SEWER LINE EXTENSION FOR L.D.S. CHURCH AT 25 1/2 AND G ROAD		
DESIGN: T.E.B.	DRAWN: D.L.M.	CHECKED: J.A.N.
DATE: 1/29/85	DWG. NO. 1285-997-1	