


Schedule C

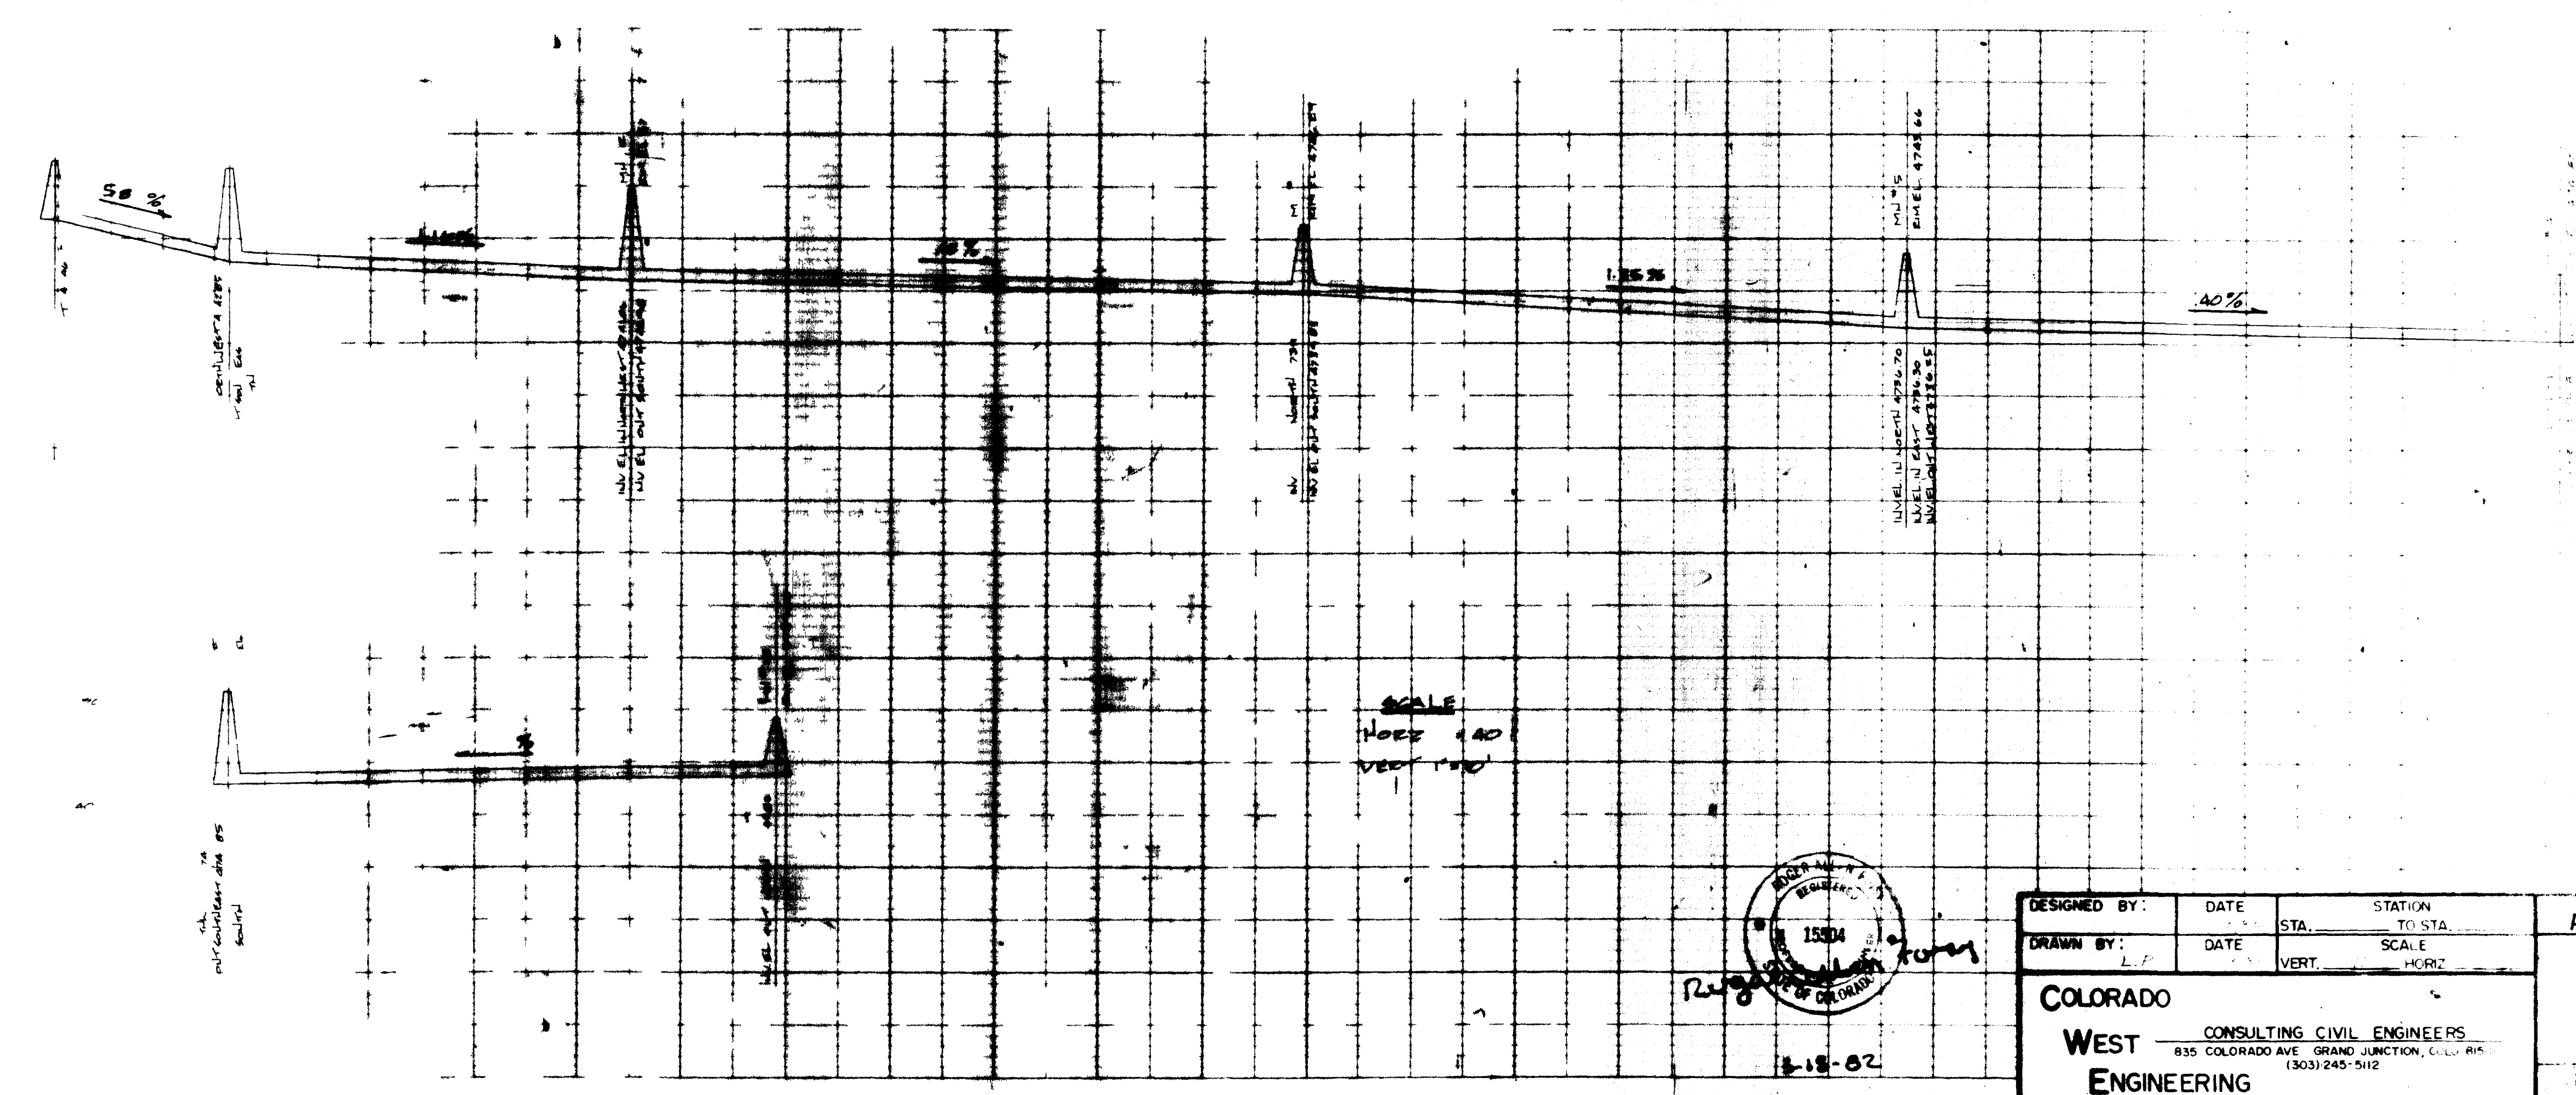


SCALE  
HORIZ 1"=40'  
VERT 1"=10'





DESIGNED BY:	DATE:	STATION	TO STA.	PAVING SURFACE
DRAWN BY:	DATE:	SCALE	HORIZ.	
<b>COLORADO WEST ENGINEERING</b> CONSULTING CIVIL ENGINEERS 835 COLORADO AVE GRAND JUNCTION, CO. 815 (303) 245-5112				SANITARY ... ...

PL TE SINGL PL AND ONE  
OF THESE

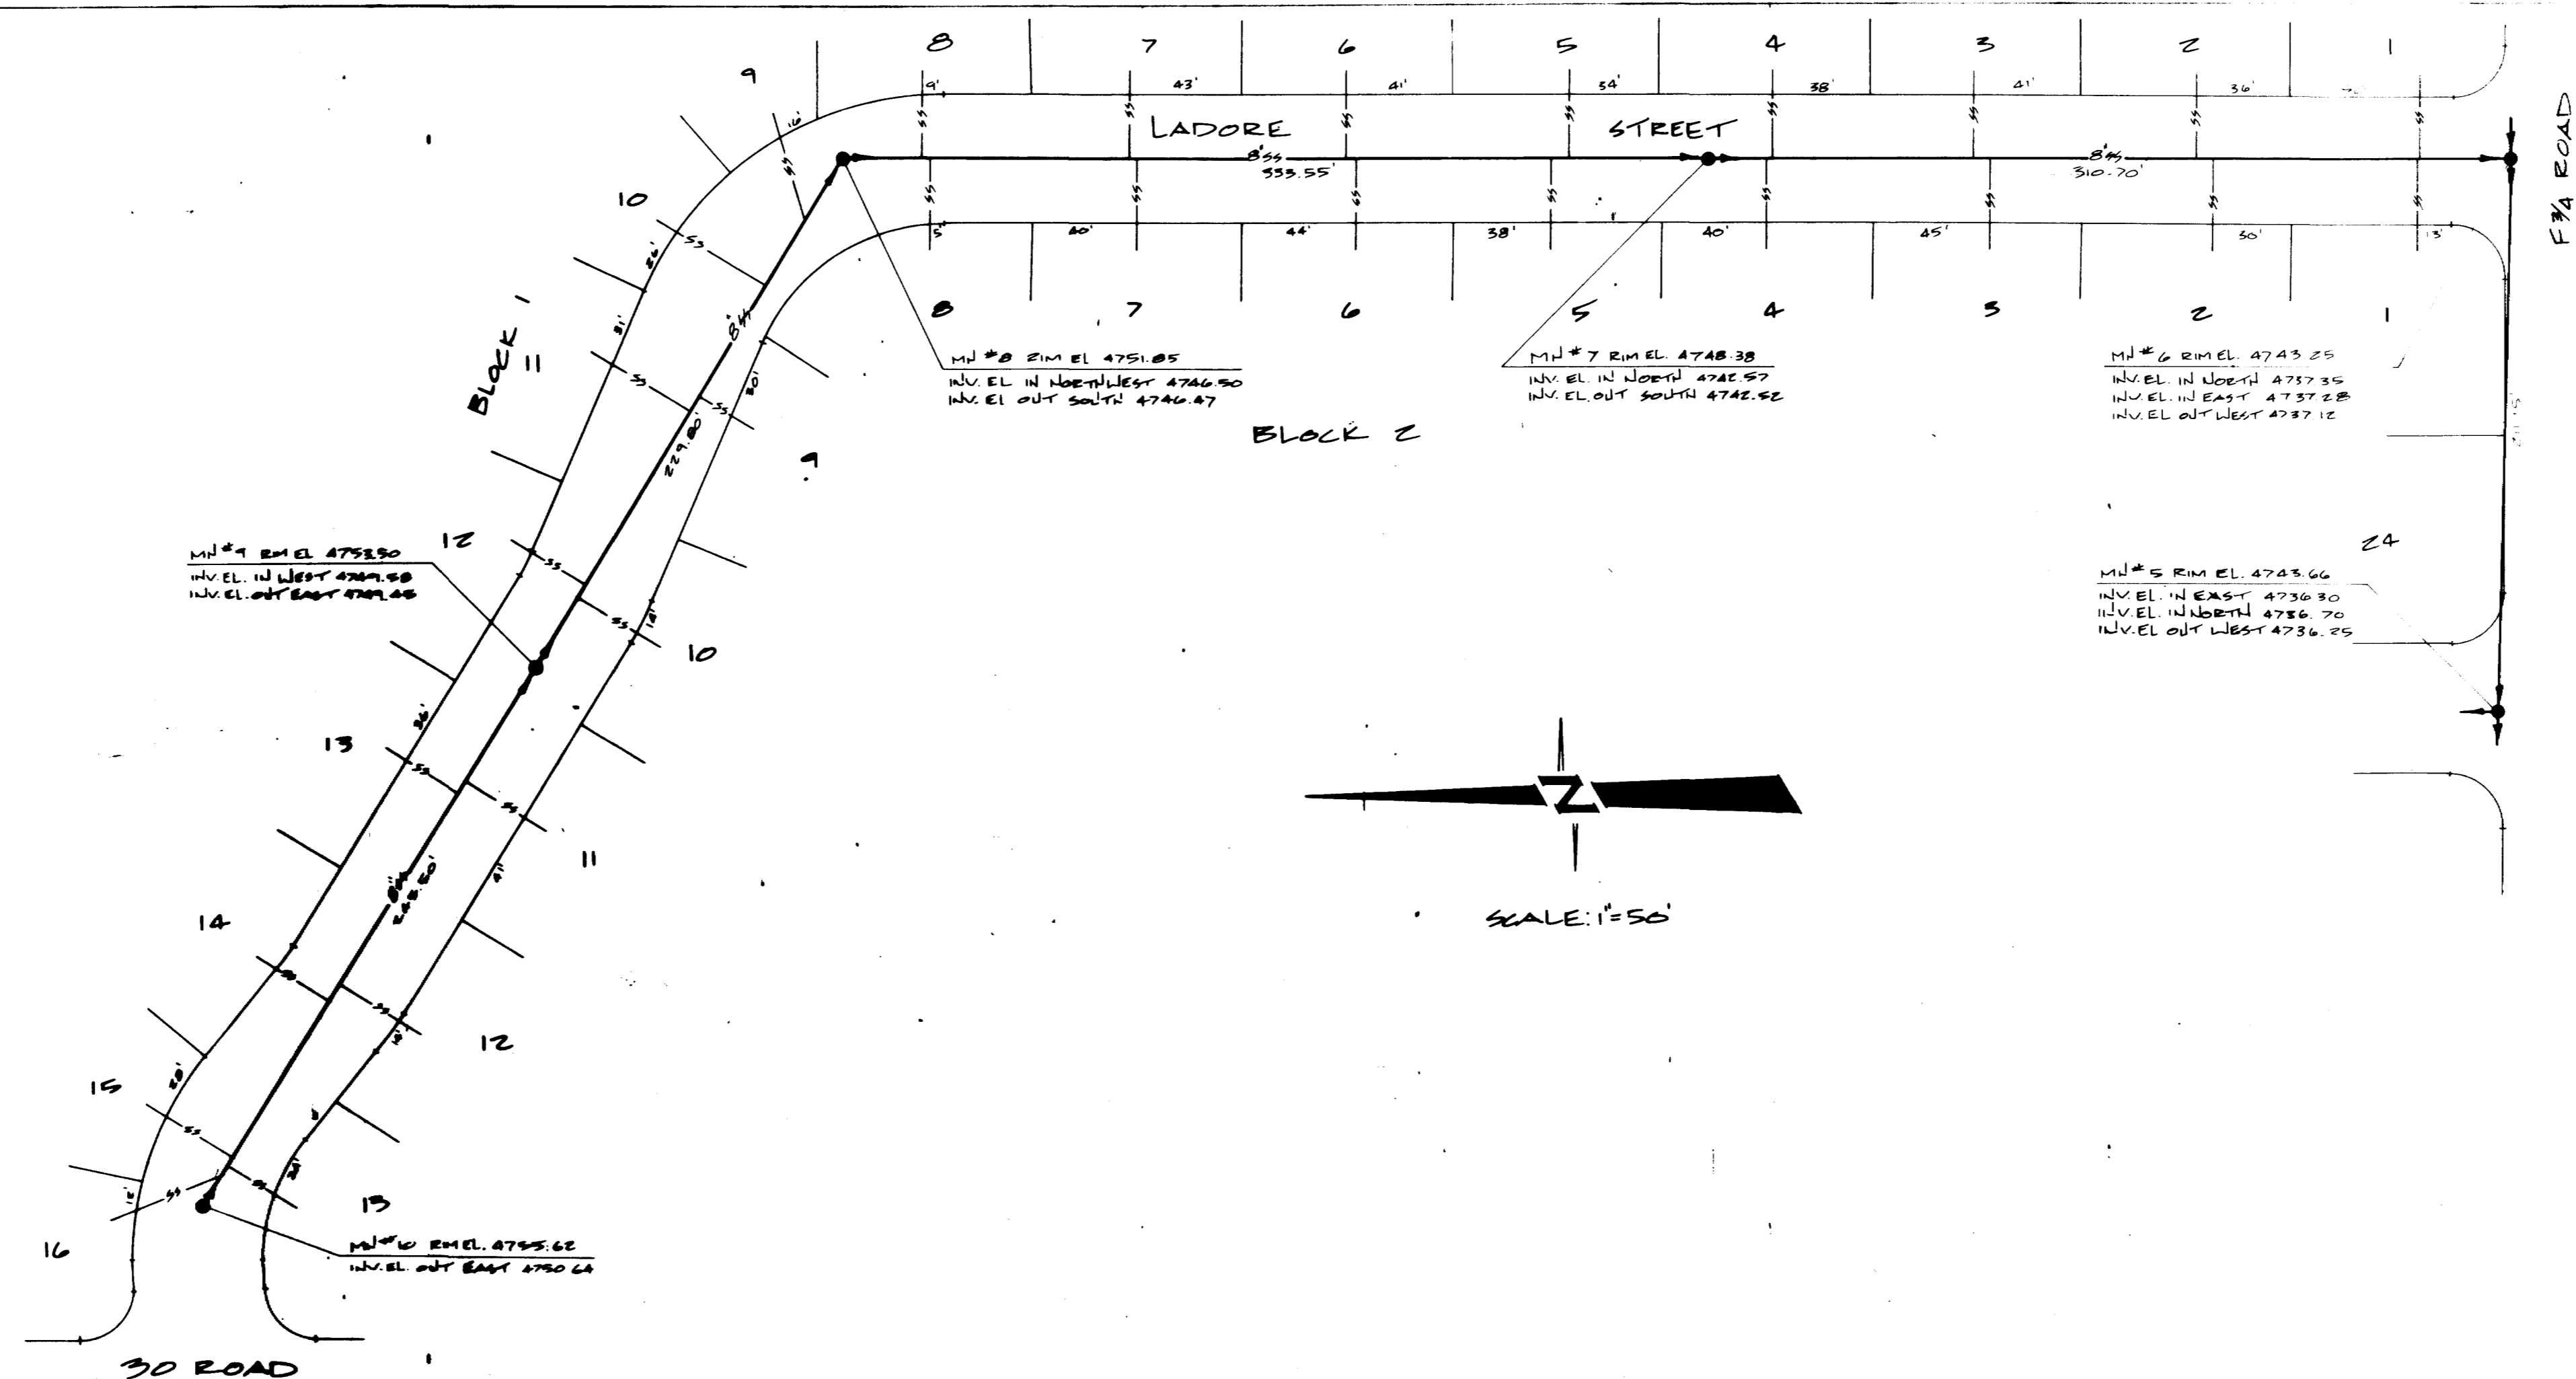

Schedule B

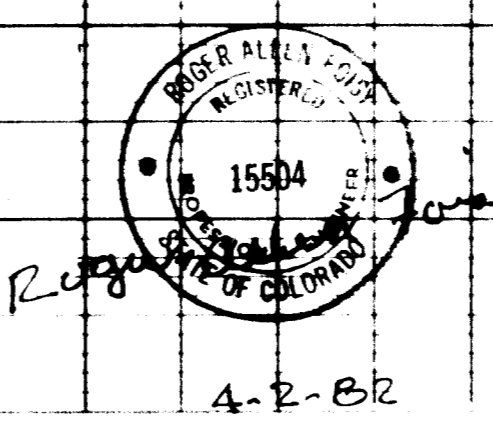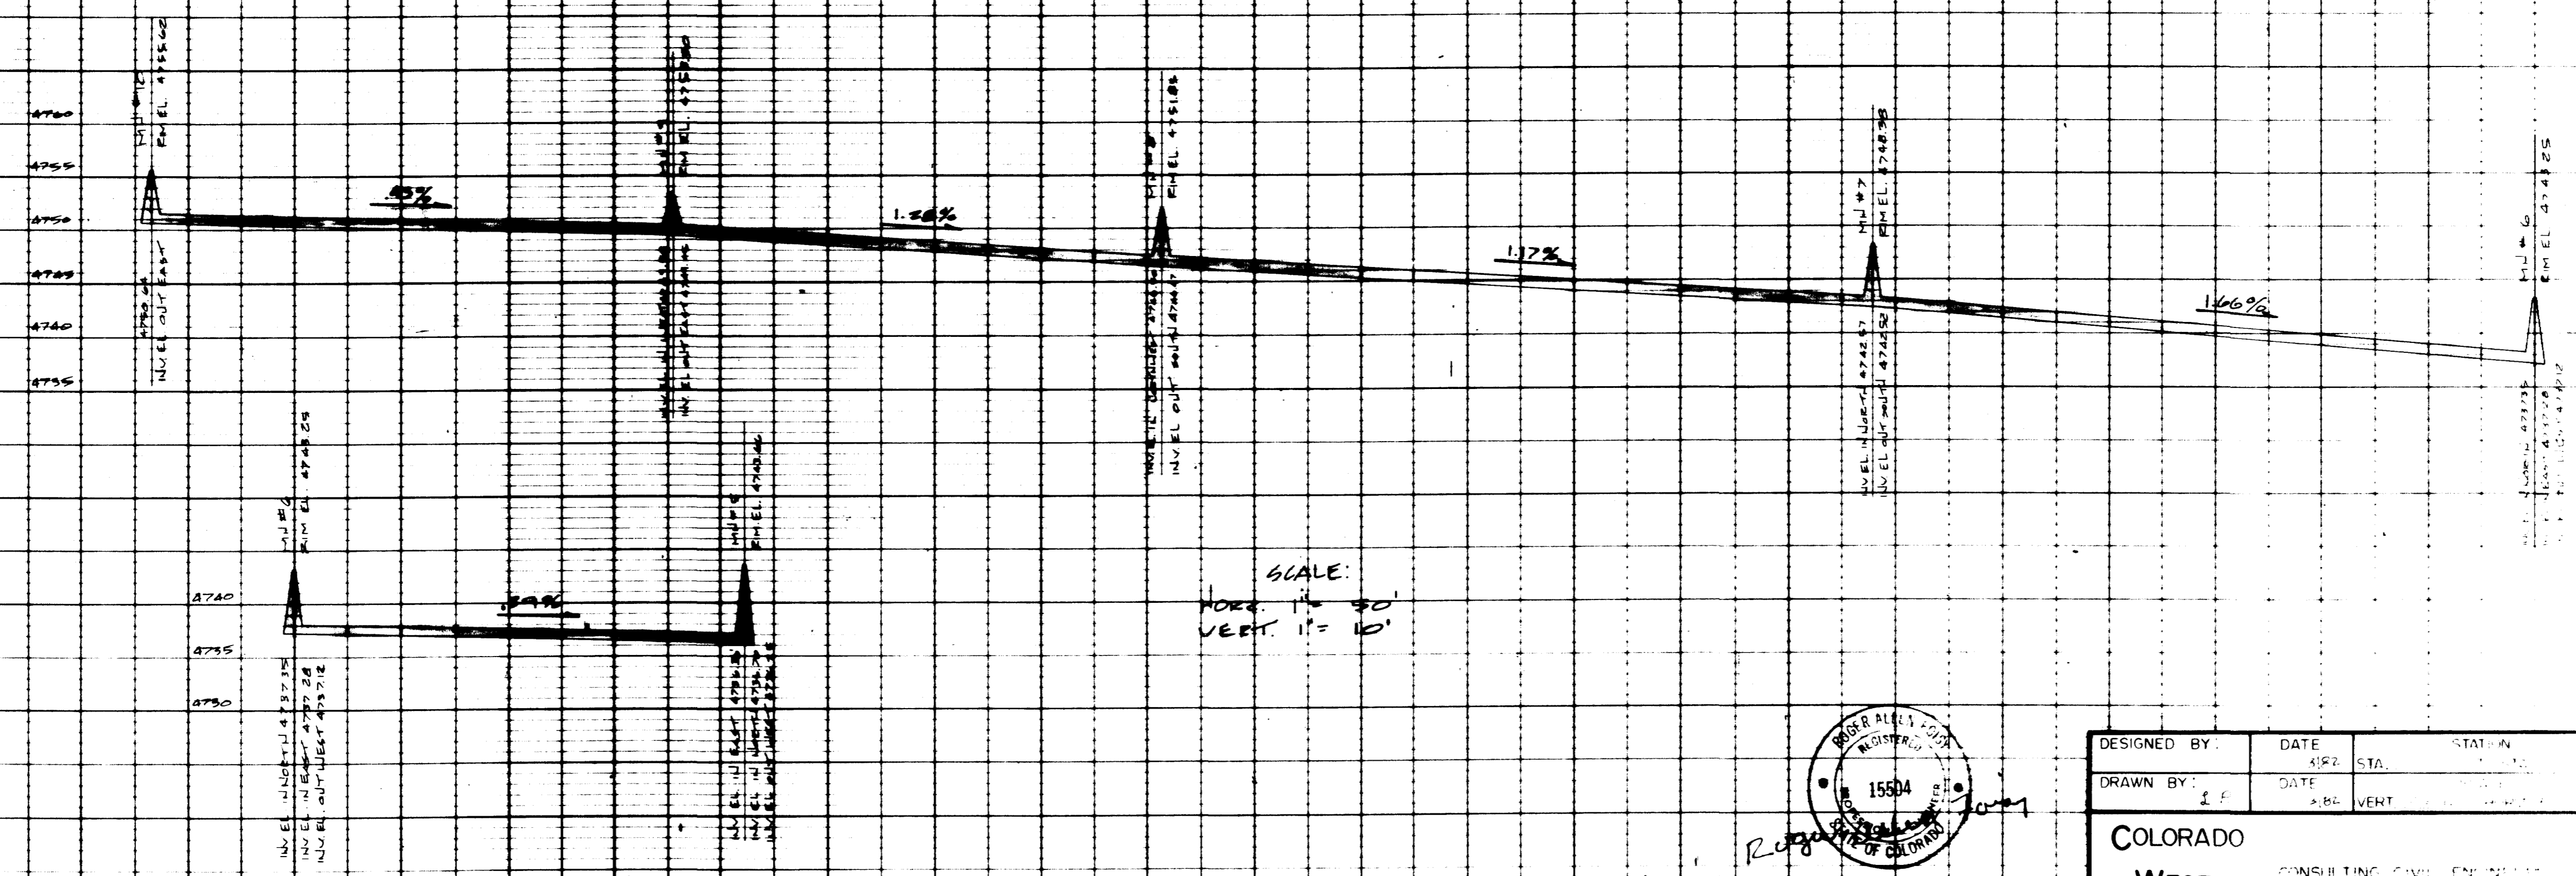

DESIGNED BY:	DATE:	KRZ STA.	STATION:
DRAWN BY:	DATE:	ABC VERT.	
<b>COLORADO</b> <b>WEST</b> CONSULTING CIVIL ENGINEERS <b>ENGINEERING</b>			

PALMYRA SUBDIVISION  
 SANITARY SEWER