
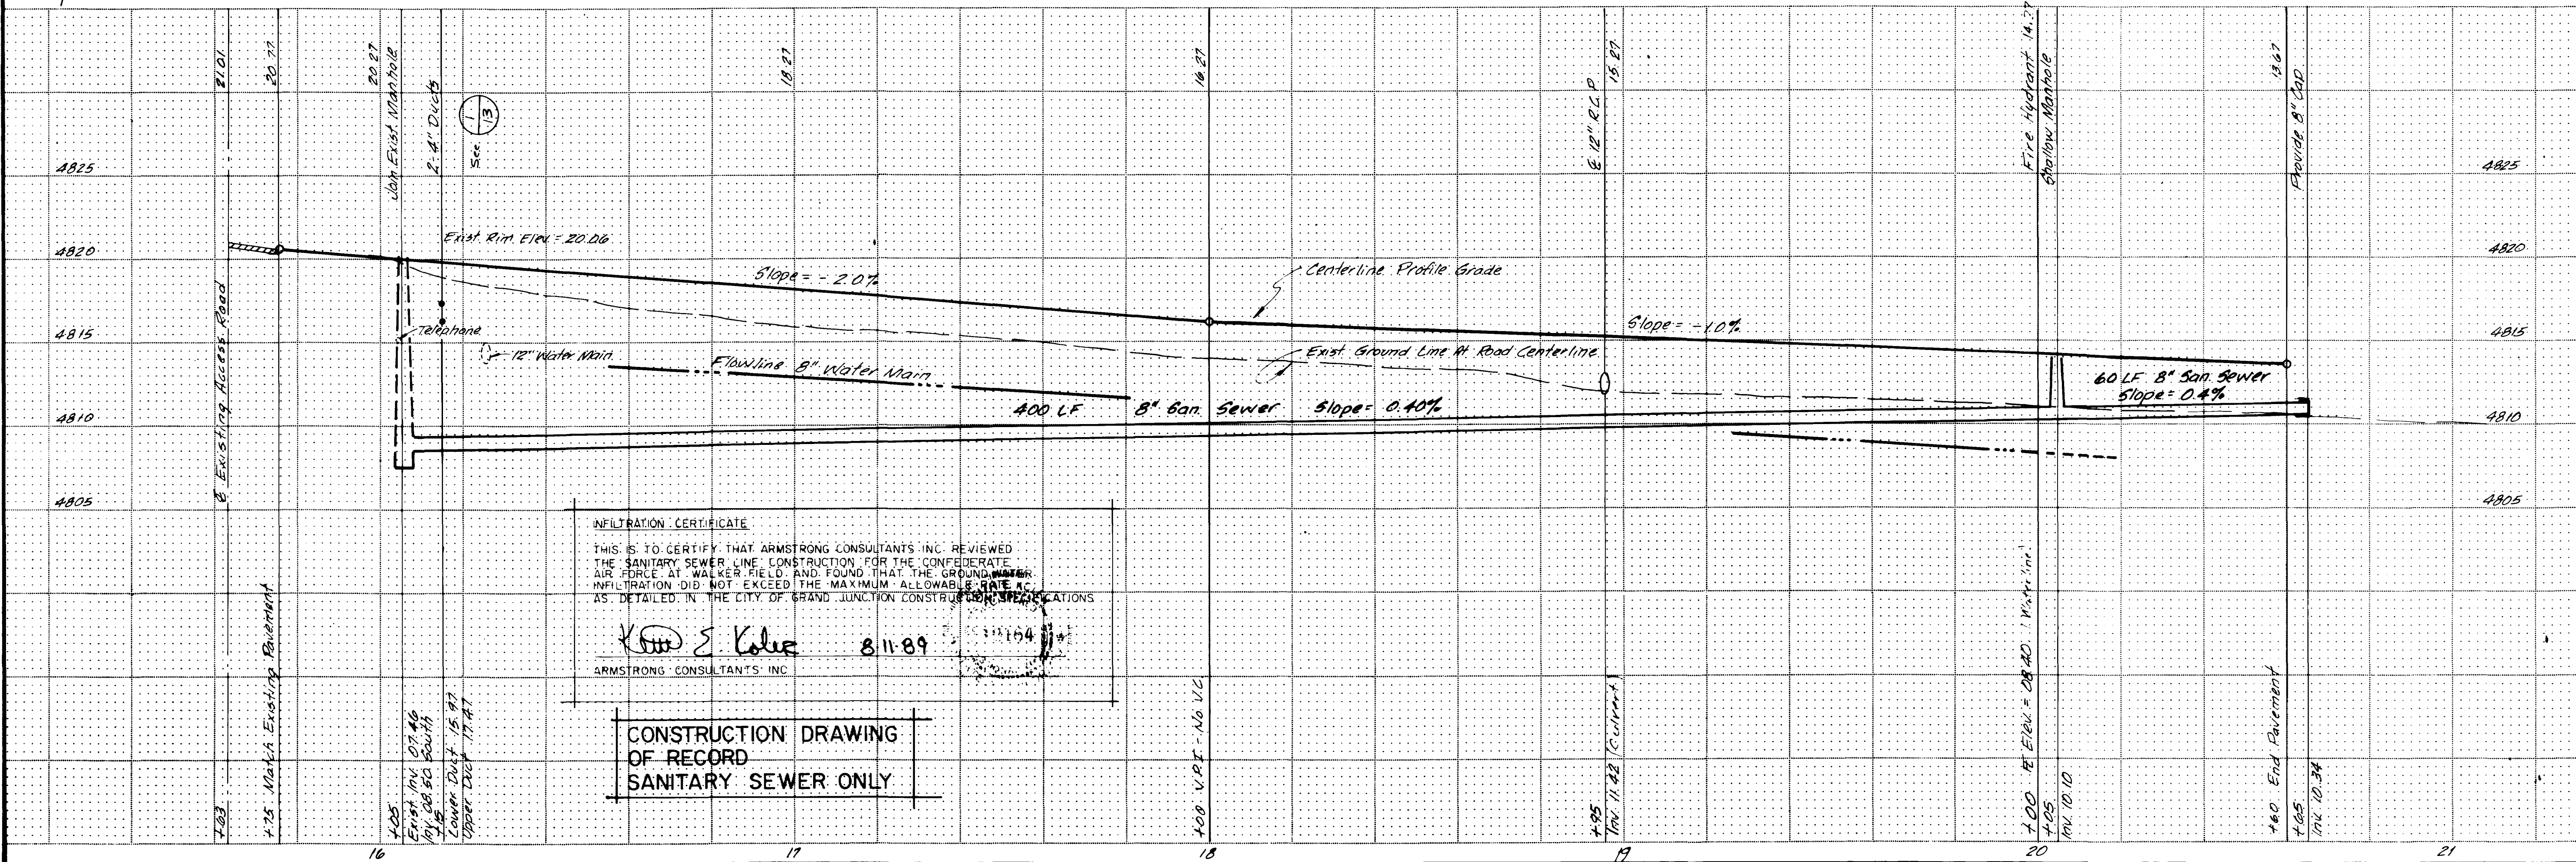
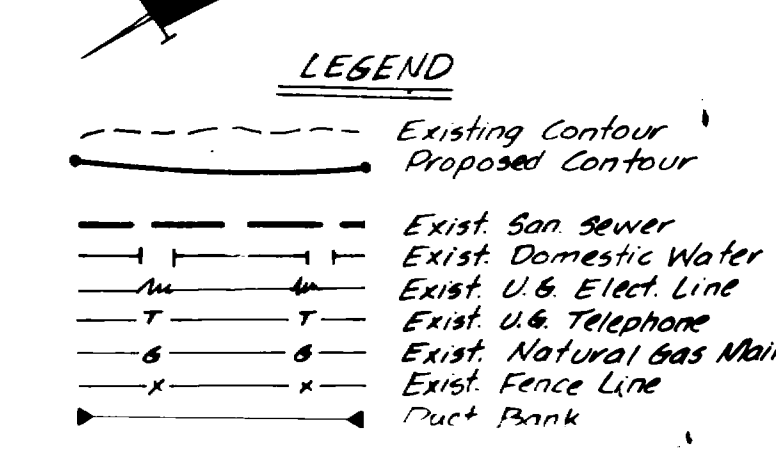


CAUTION - NOTICE TO CONTRACTOR

The Contractor is specifically cautioned that the location and/or elevation of existing utilities as shown on these plans is based on records of the various utility companies and, where possible, measurements taken in the field. The information is provided for the convenience of the Contractor and is not to be relied on as being exact or complete. The Contractor must call the Utility Location Notification Center of Colorado, 1-(800)-922-1987, at least 48 hours before any excavation to request exact field location of utilities.

NOTE: Embankment, Paving, Culvert & Duct Included in Schedule III. Water & Sewer Mains Included in Schedule V.

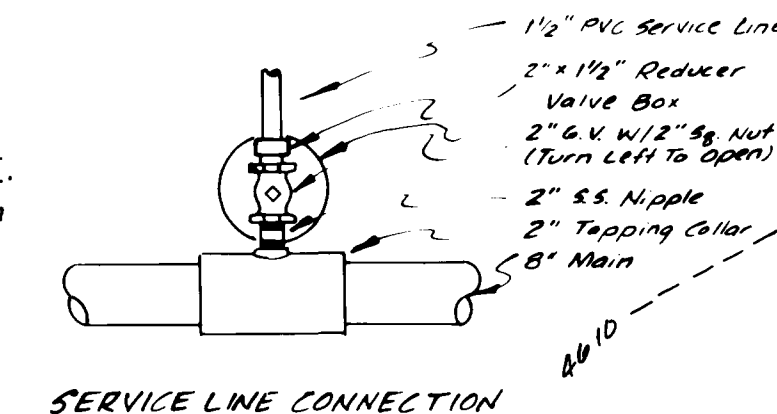

INFILTRATION CERTIFICATE

THIS IS TO CERTIFY THAT ARMSTRONG CONSULTANTS, INC. REVIEWED THE SANITARY SEWER LINE CONSTRUCTION FOR THE CONFEDERATE AIR FORCE AT WALKER FIELD AND FOUND THAT THE GROUND WATER INFILTRATION DID NOT EXCEED THE MAXIMUM ALLOWABLE RATE AS DETAILED IN THE CITY OF GRAND JUNCTION CONSTRUCTION SPECIFICATIONS.

[Signature] 8-11-89

ARMSTRONG CONSULTANTS, INC.

CONSTRUCTION DRAWING OF RECORD

SANITARY SEWER ONLY

ARMSTRONG CONSULTANTS, INC.

861 Road Avenue
Grand Junction, Colorado 81501
(930) 242-0101

Engineers
Planners
Surveyors
Soil Testing
Material Testing
Geotechnical Engineers

WALKER FIELD AIRPORT

GRAND JUNCTION, COLORADO

AIP PROJECT NO. 3-08-0027-08

Project No: 885/46
Date:
Revisions:
UIC Water 3-3-89

Drawn: T LOGUE
Checked: R RISH
Approved: K KOLER

C A F ACCESS ROAD & UTILITIES

SCHEDULE III

Sheet 10 of 16