


PROFILE AND GRADE
 PROPOSED
 COMBINED SEWER DISTRICT NO 5

1929 (P)

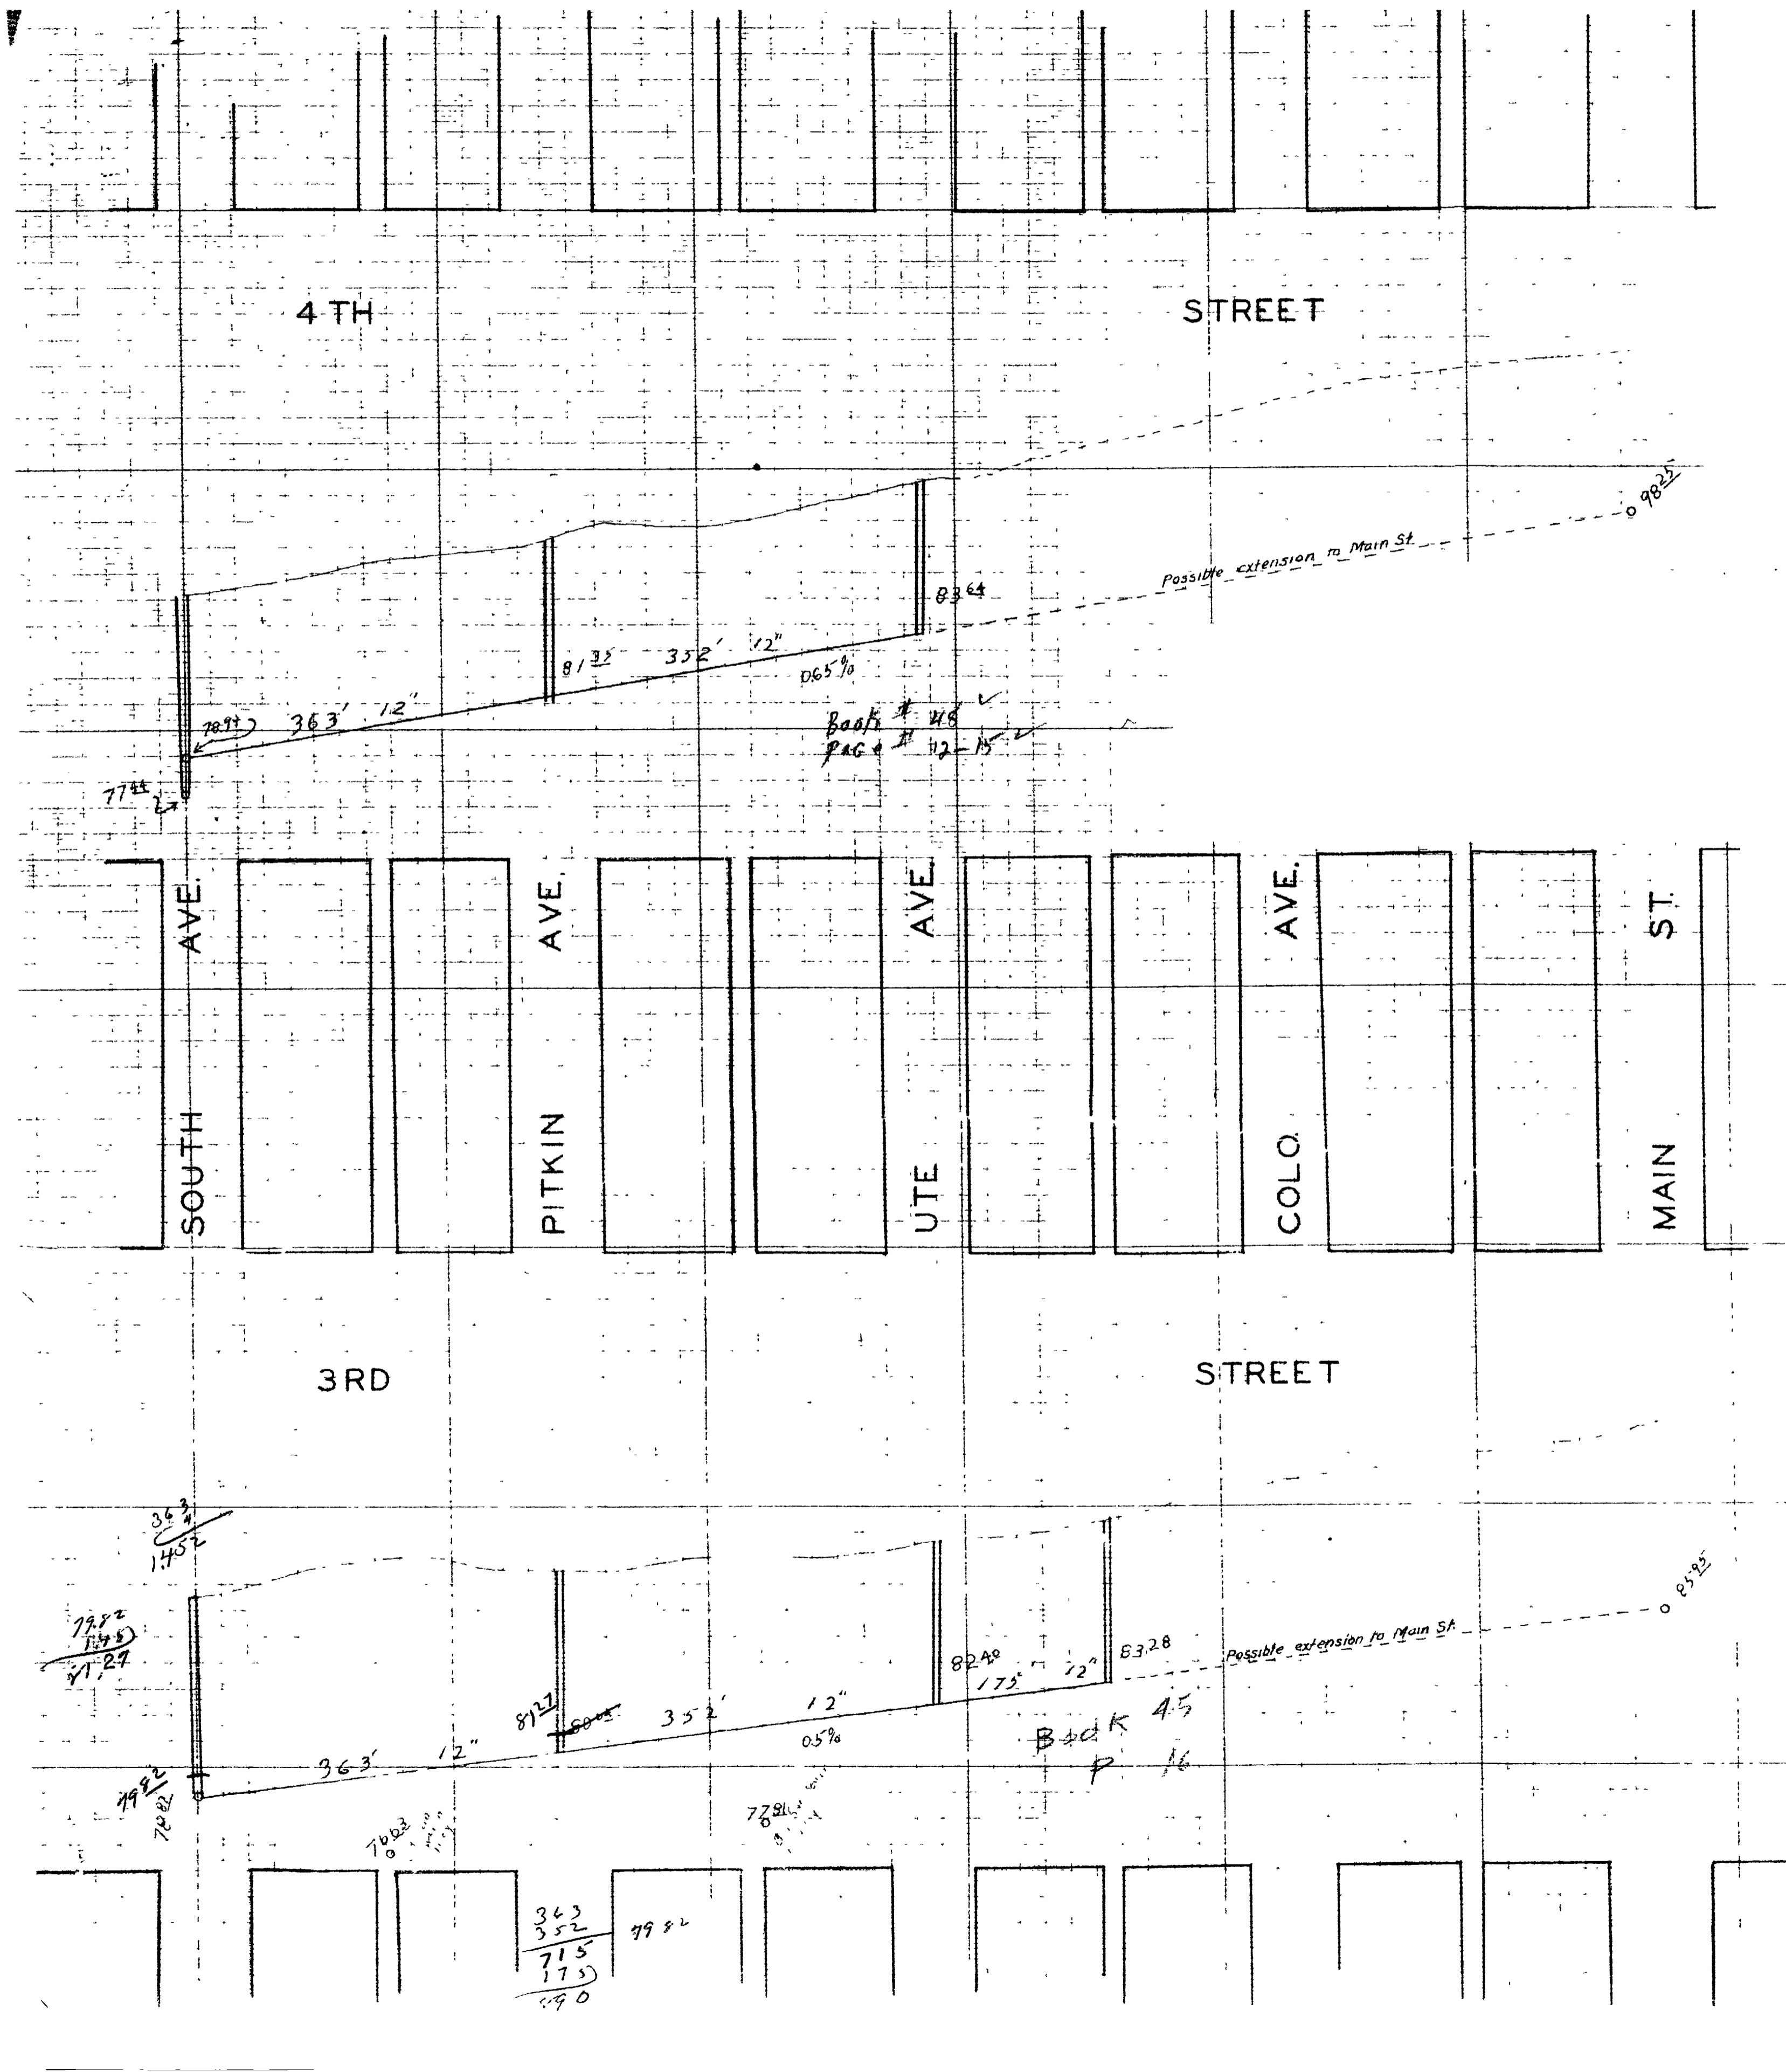

MAP OF PROPOSED COMBINED SEWER DISTRICT NO. 5

SHOWING
BOUNDARIES OF DISTRICT, IMPROVEMENTS TO BE MADE,
PROPERTY TO BE ASSESSED, ESTIMATED ASSESSMENTS
AND THE ESTIMATED COST



CITY ENGINEER

ESTIMATED ASSESSMENT PER SQ. FT. \$0.038612
" " " " LOT 25' X 125' \$12.07

