New 6" Sewer
Block 105
Put in Sept. 1912.

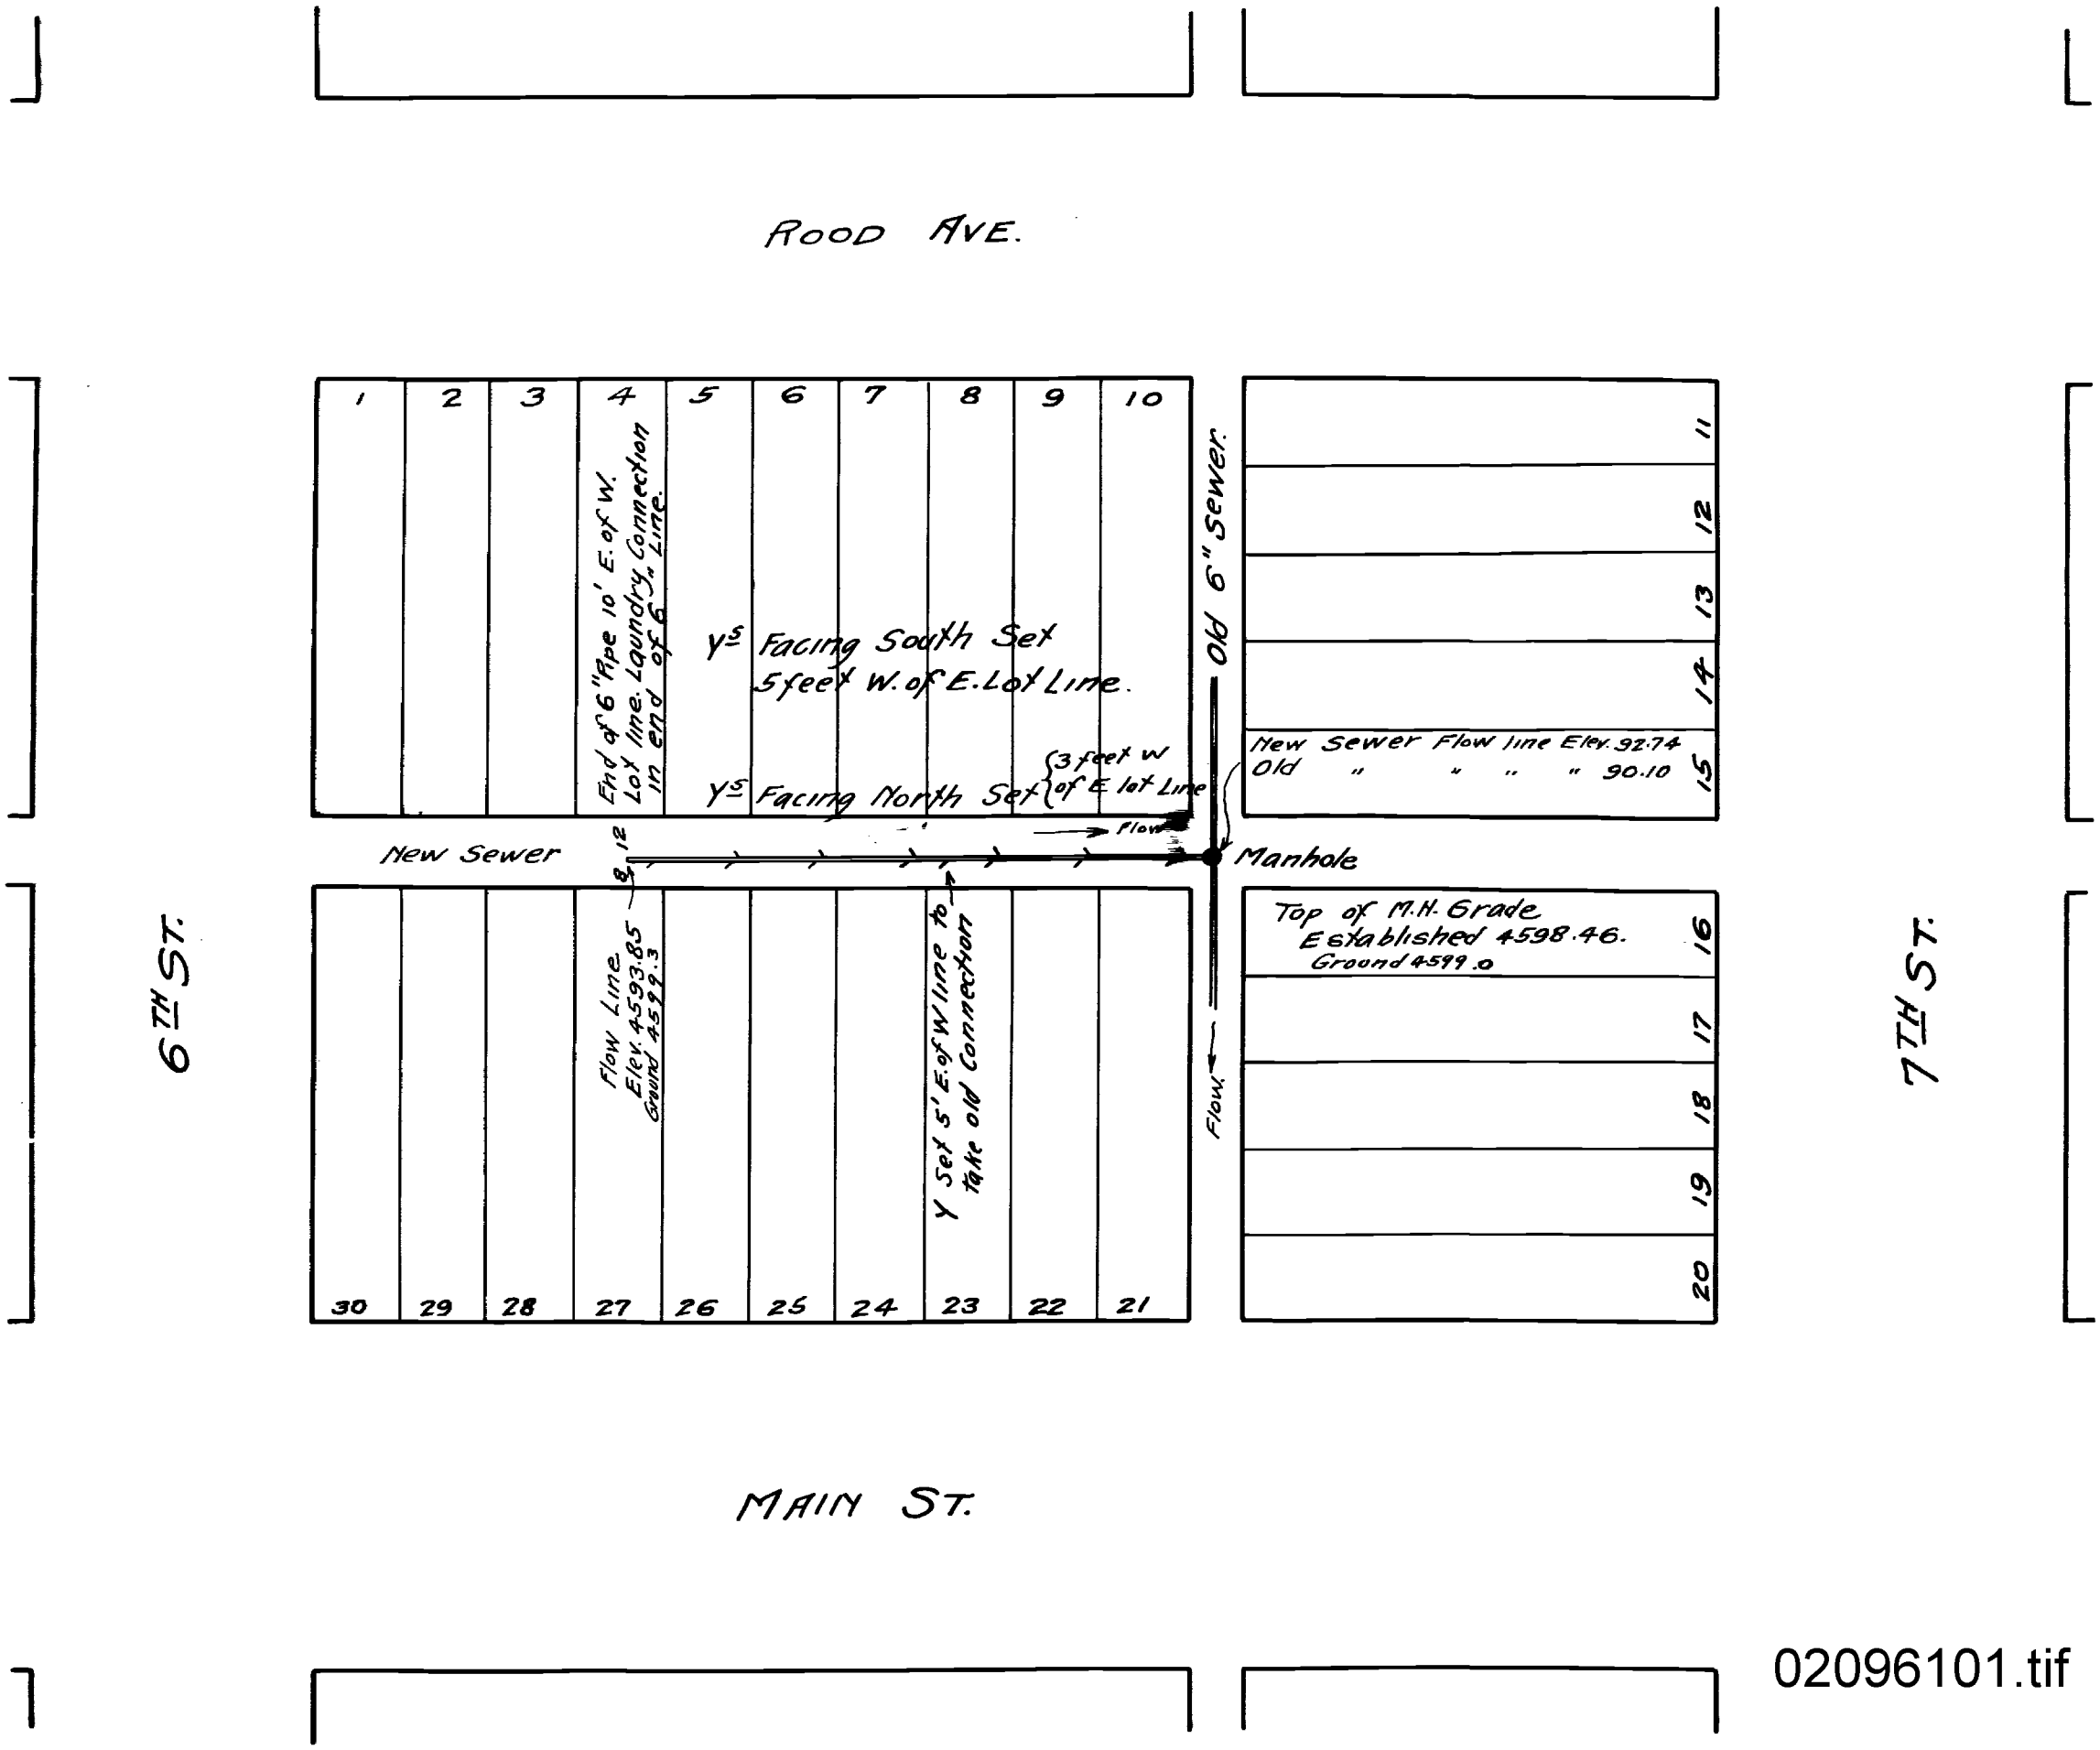

02096101.tif

Y LOCATIONS
SANITARY SEWER
IN
BLOCK 12

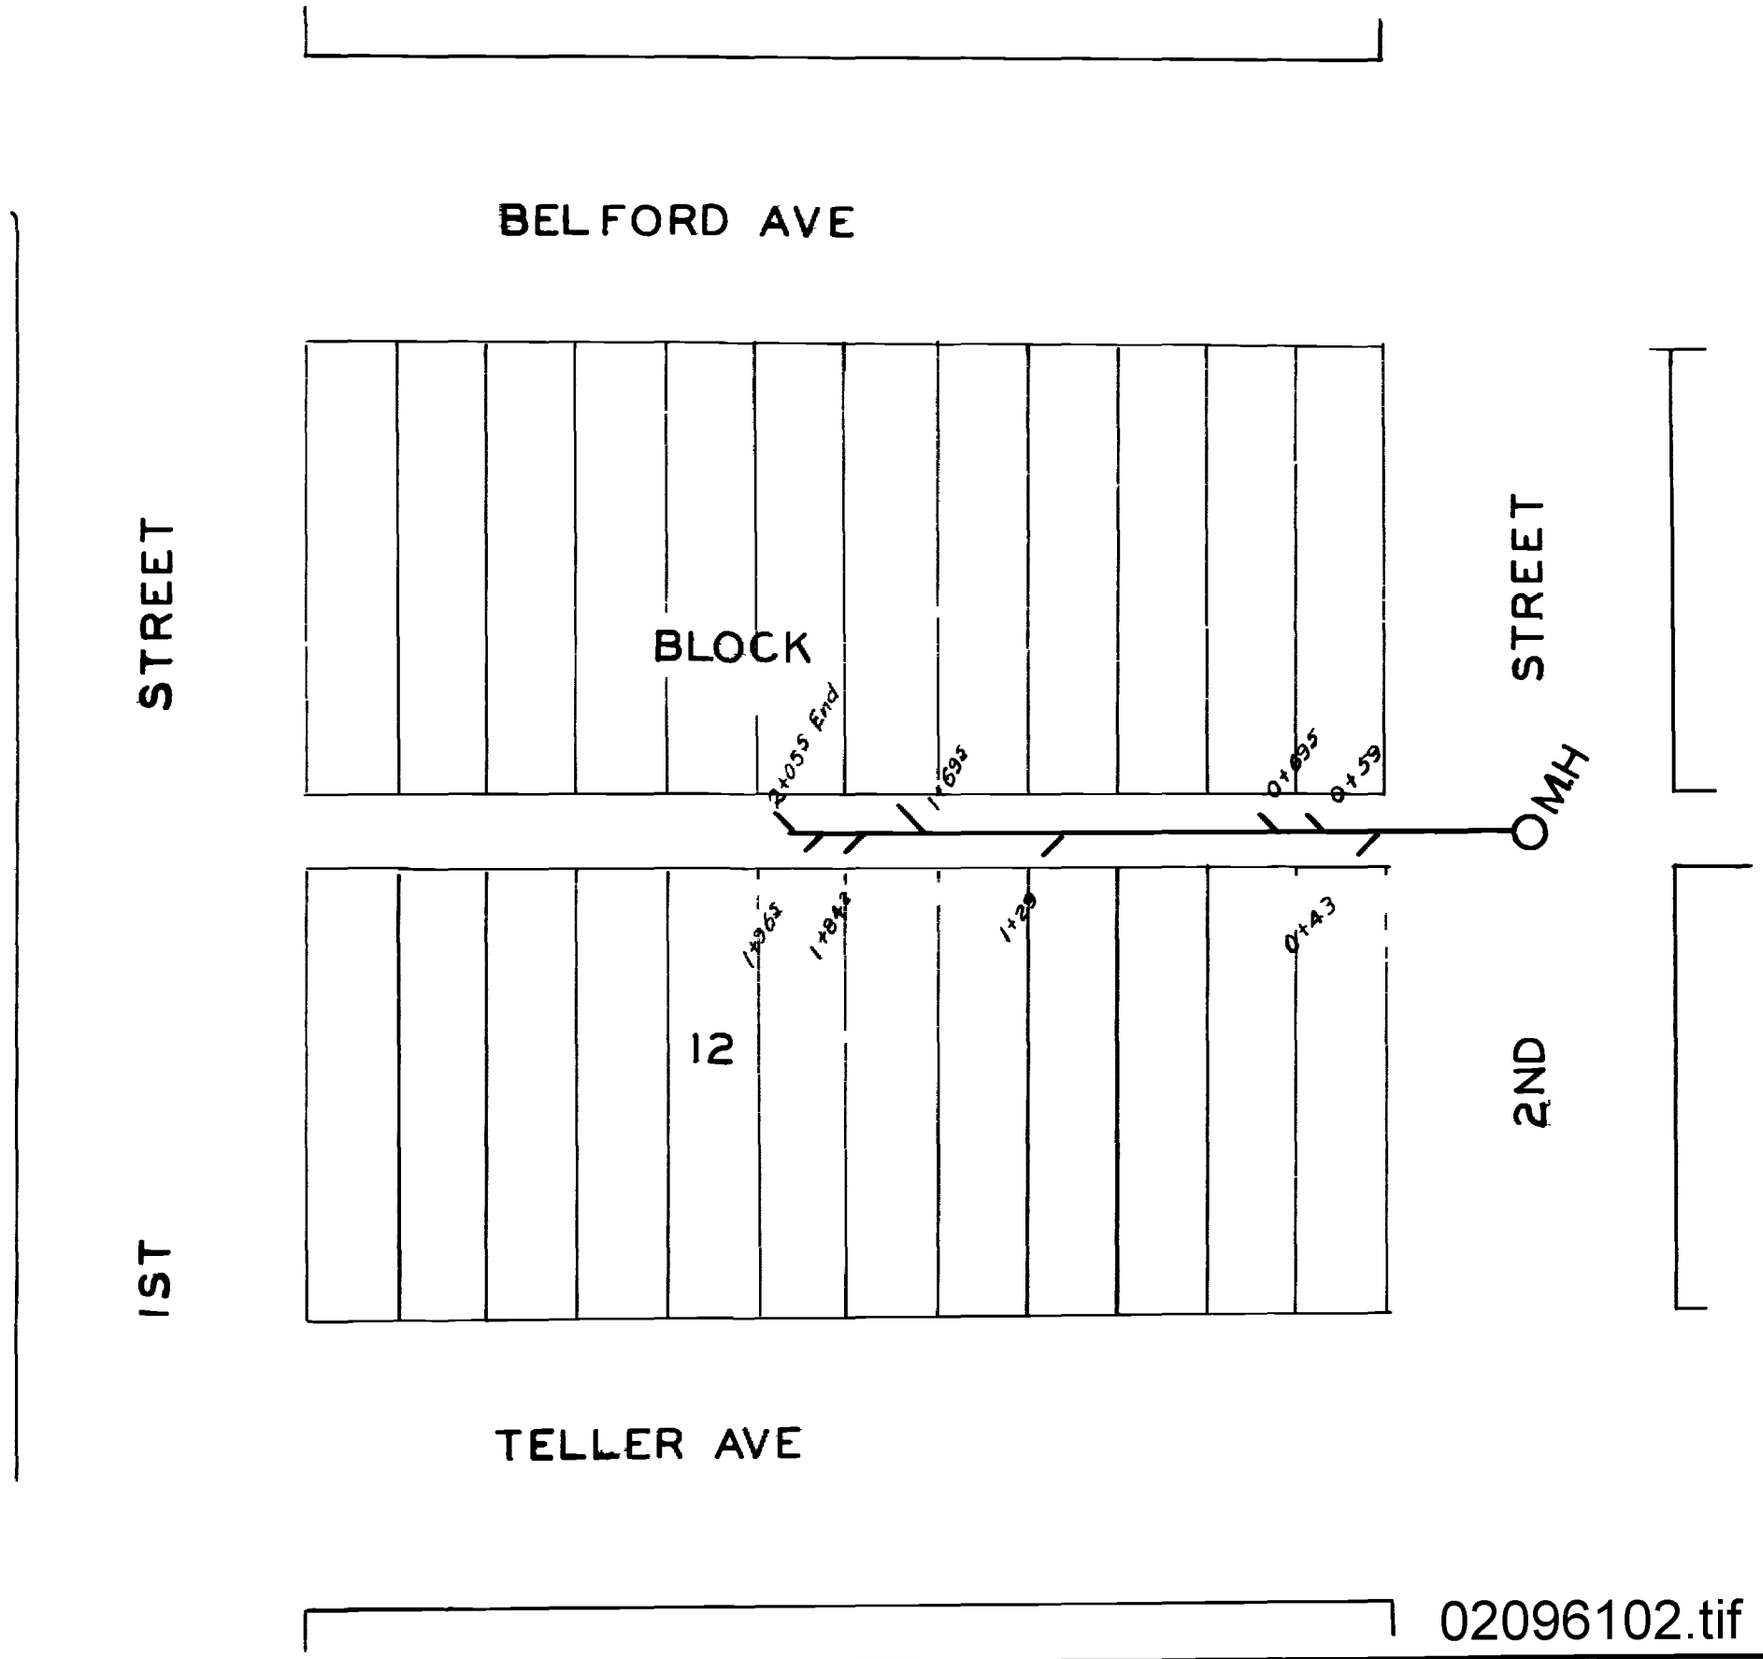

02096102.tif