


- QUANTITIES**
- 1ea. CONNECT TO EXISTING M.H.
  - 5ea. STANDARD MANHOLES
  - 1176 LF. 8" P.V.C. D 303A SEWER LINE
  - 4" SERVICE CONNECTIONS (QUANTITY TO BE DETERMINED)

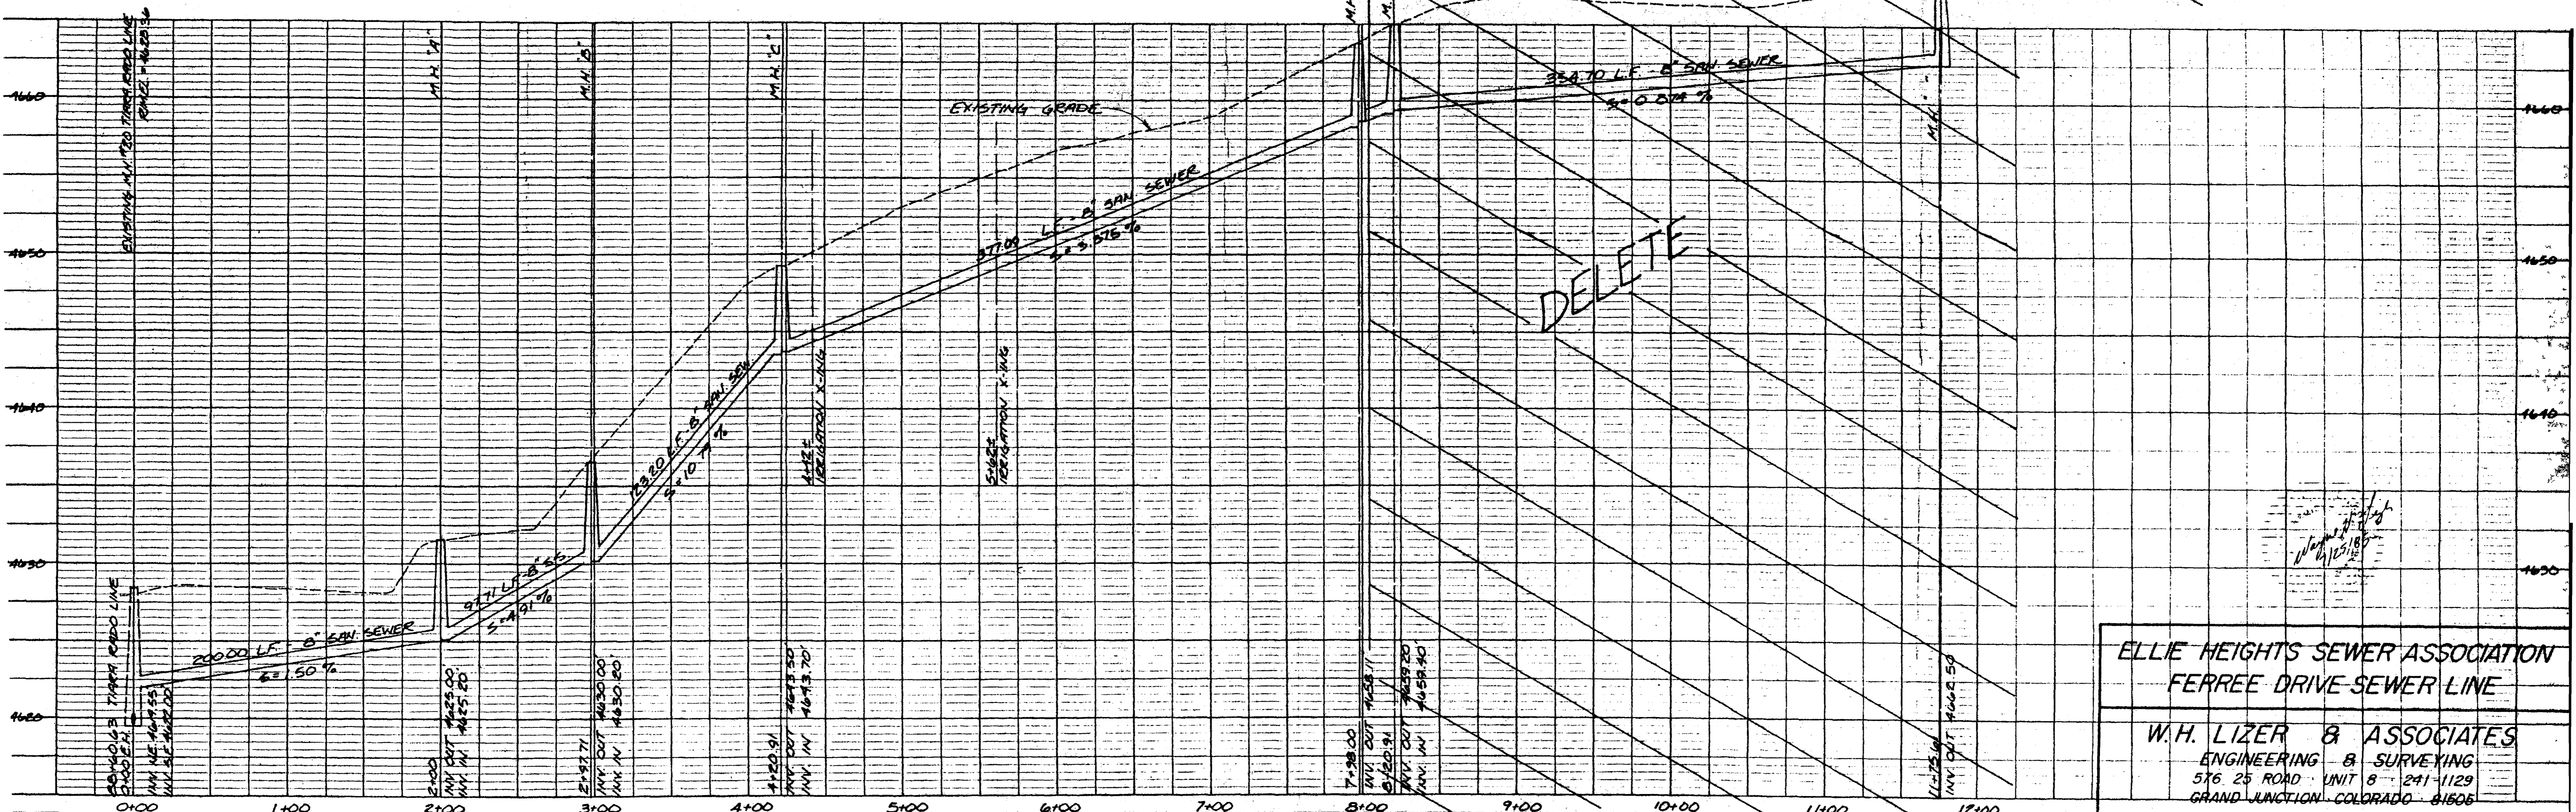

ELLIE HEIGHTS SEWER ASSOCIATION  
FERREE DRIVE SEWER LINE

W.H. LIZER & ASSOCIATES  
ENGINEERING & SURVEYING  
576 25 ROAD UNIT 8 291-1129  
GRAND JUNCTION, COLORADO 81506