PROJECT NO. 905-F10215

DRAWING STATUS:
- PROGRESS
- BID SET
- FINAL CONSTRUCTION DRAWINGS

GRAPHIC SCALE

20 0 10 20 40 80

(IN FEET)
1 inch = 20 ft.

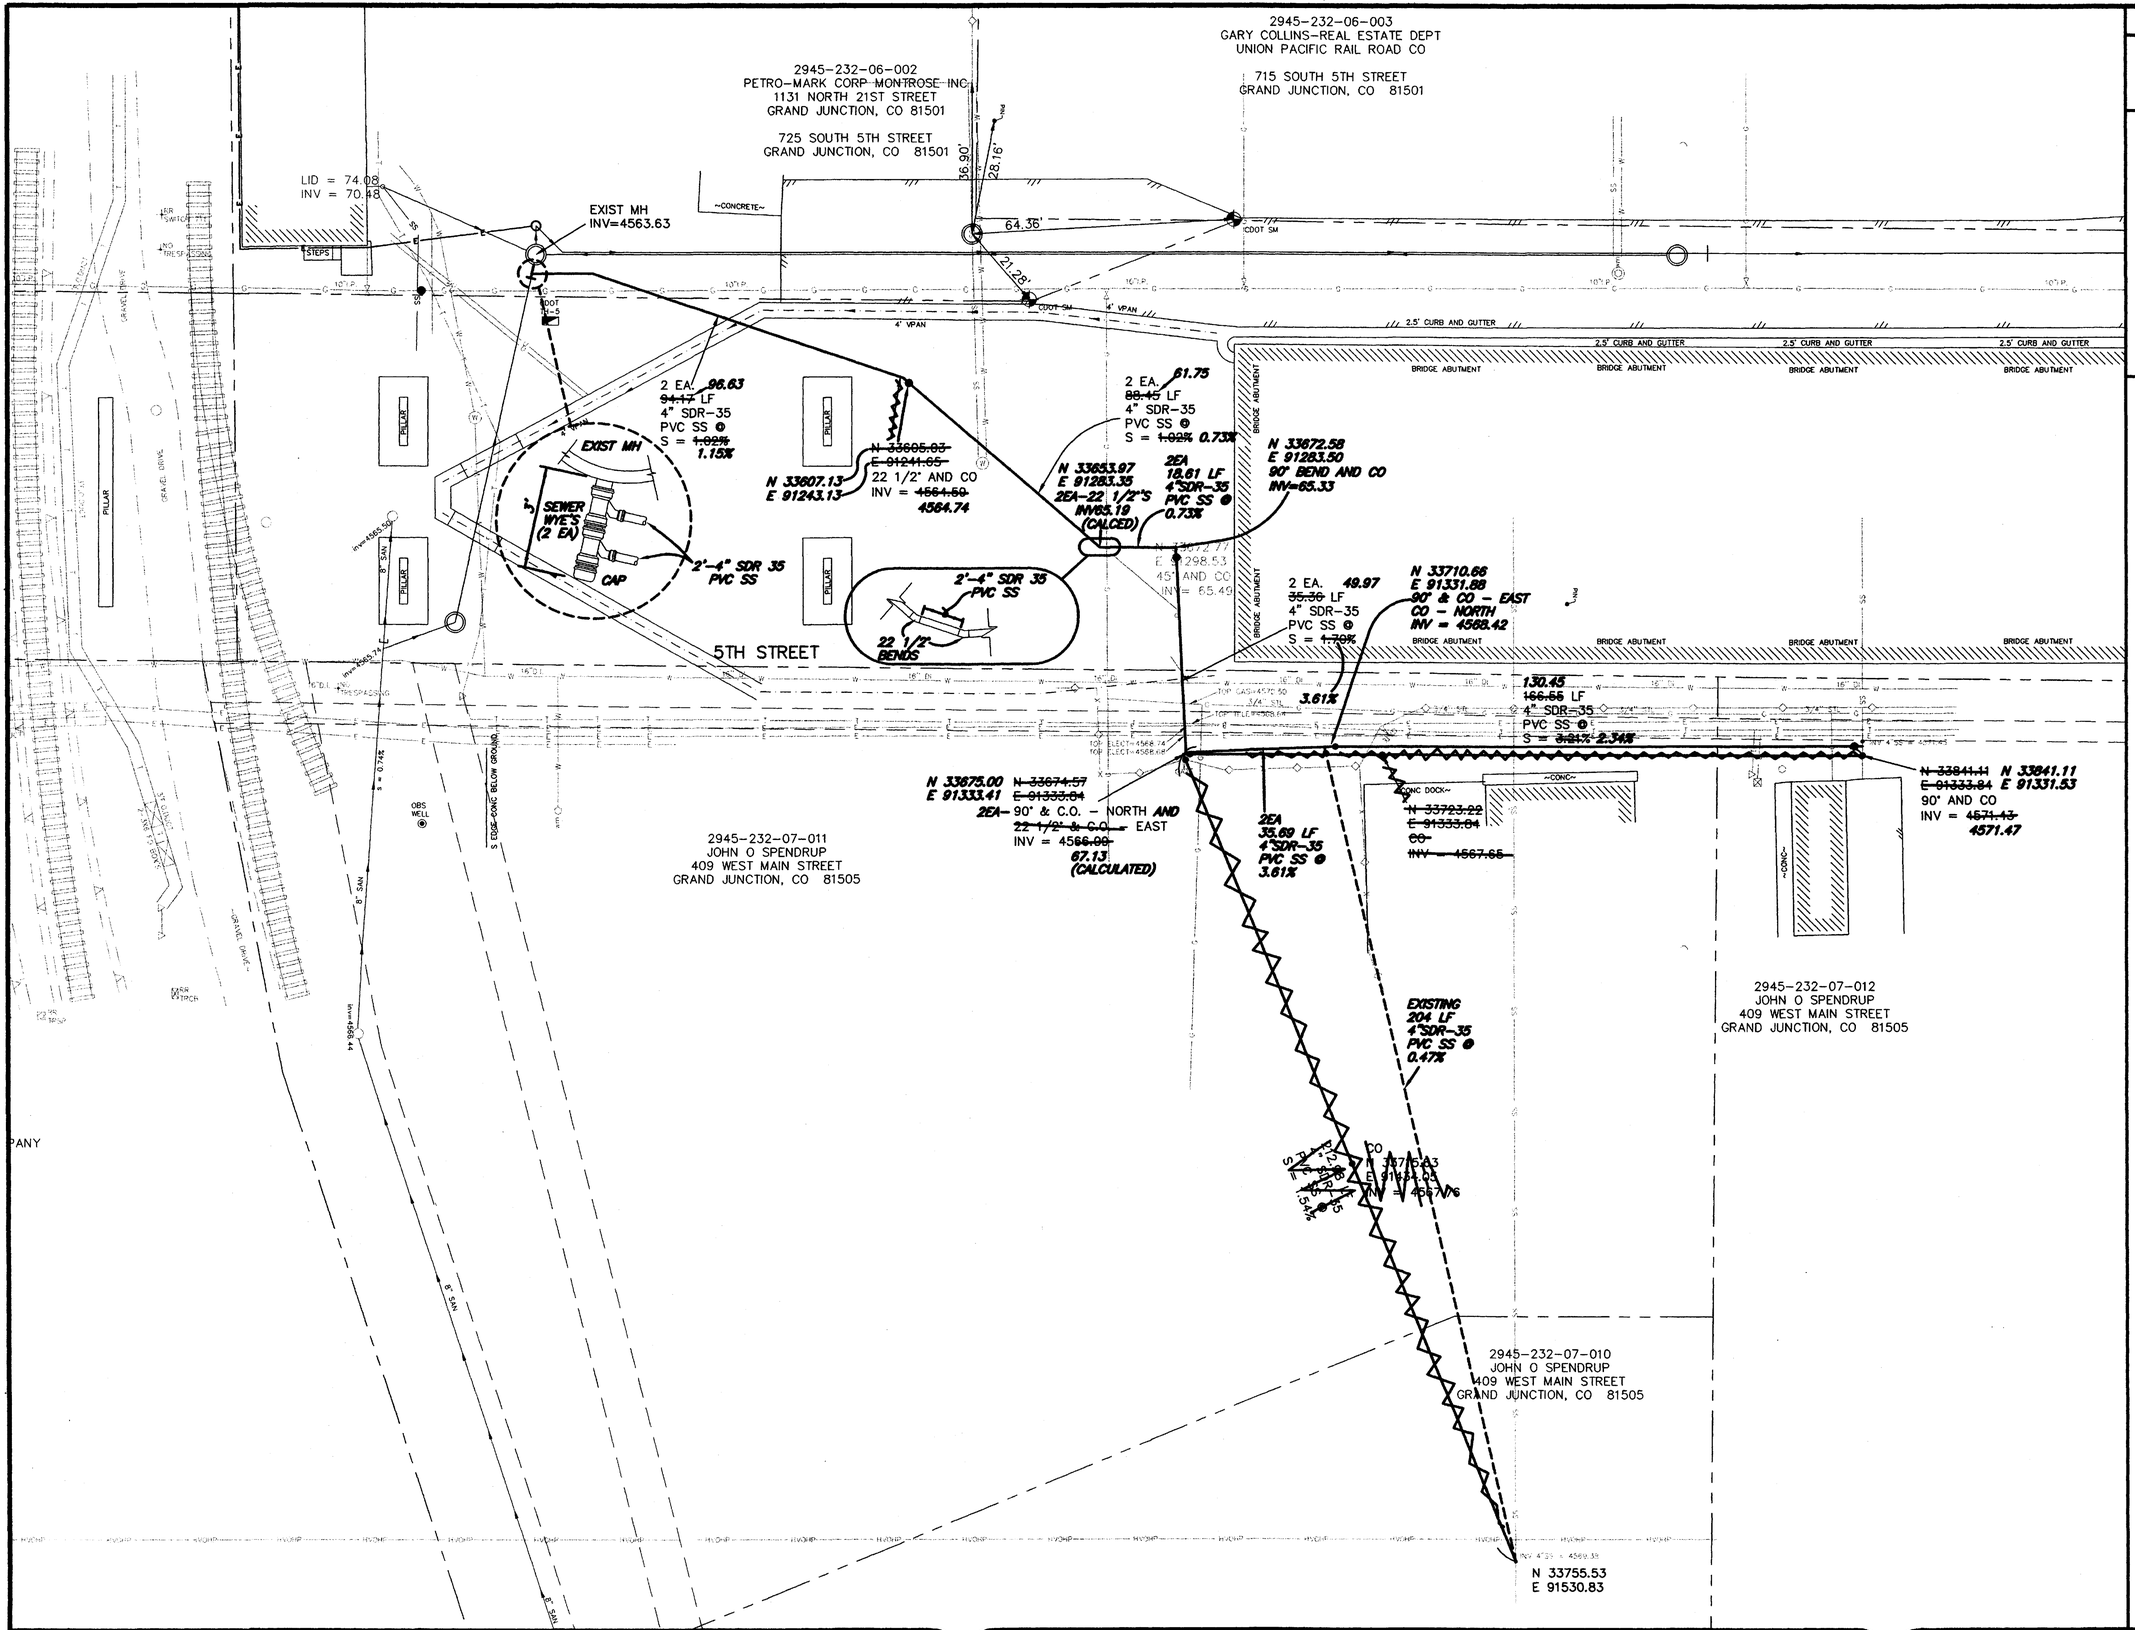

DESCRIPTION	DATE
REVISION 1 ASBUILT	7-20-04
REVISION 2	
REVISION 3	
REVISION 4	

DRAWN BY JCS	DATE 2003		
DESIGNED BY SBG	DATE 2003		
CHECKED BY SBG	DATE 2003		
APPROVED BY	DATE		

SCALE	
PLAN	PROFILE
HORIZ. 1"=20'	HORIZ. 1"=20'
	VERT. 1"=5'

DEPARTMENT OF PUBLIC WORKS AND UTILITIES
ENGINEERING AND TECHNICAL SERVICES DIVISIONS
CITY OF GRAND JUNCTION, COLORADO

5th Street Viaduct
Sanitary Sewer Service Intercept
PARCELS 2945-232-07-010 & 2945-232-07-012

1

02105101.TIF